


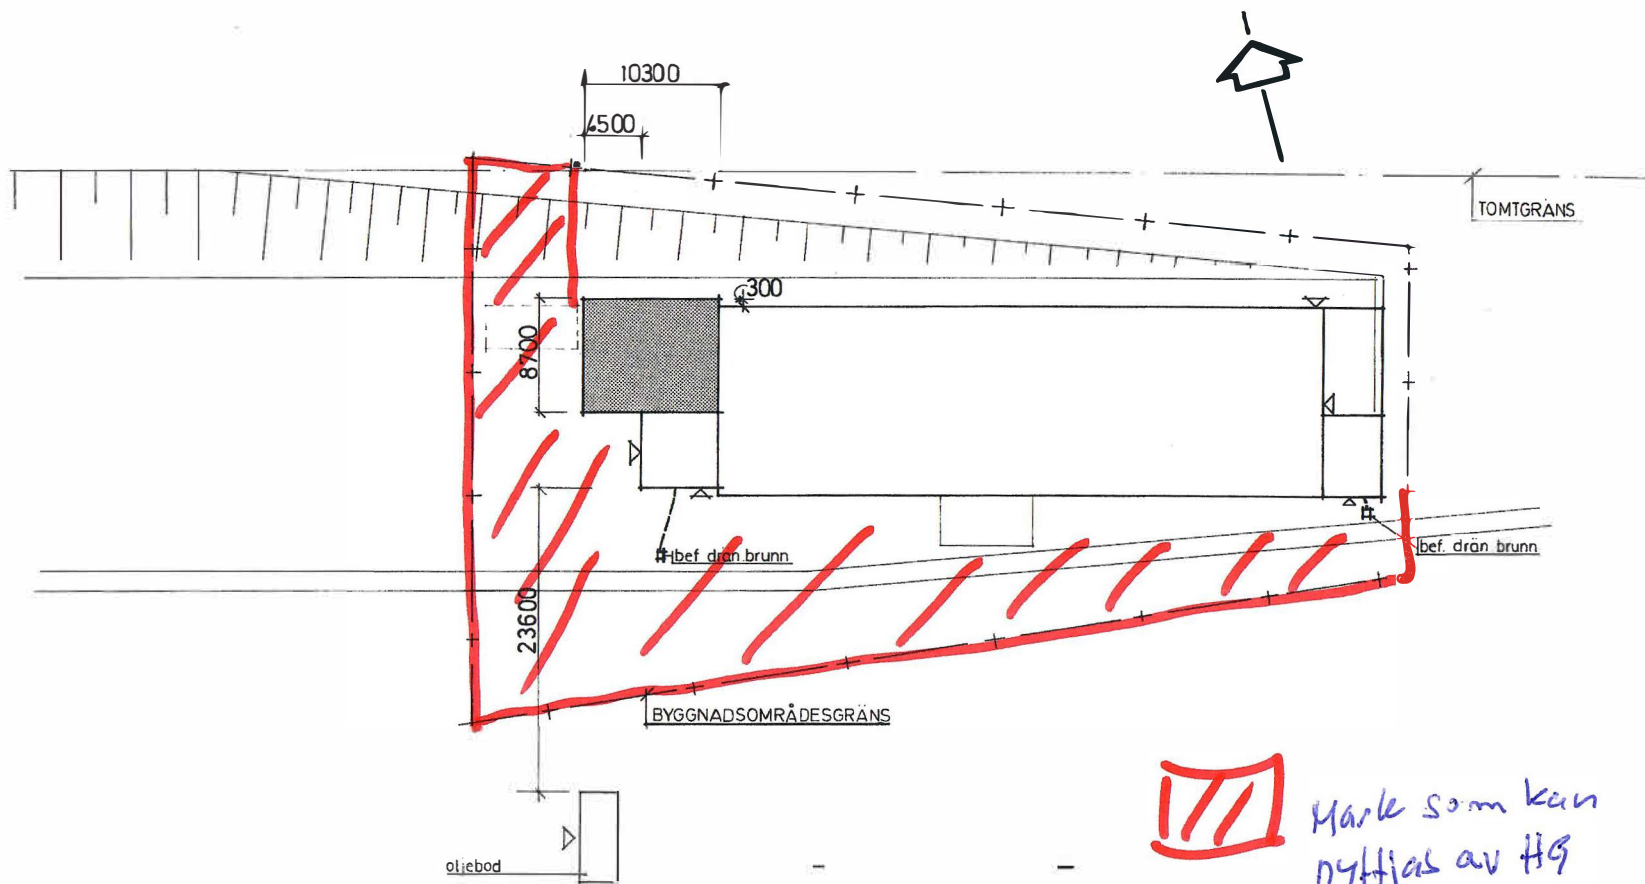

CA 908 KVM

NYFOSA

TRANSISTORN 1
SVEDJEVÄGEN 12
SKELLEFTEÅ
PLAN BV



NYFOSA

TRANSISTORN 1
 SVEDJEVÄGEN 12
 SKELLEFTEÅ
 PLAN BV