



Plan 1

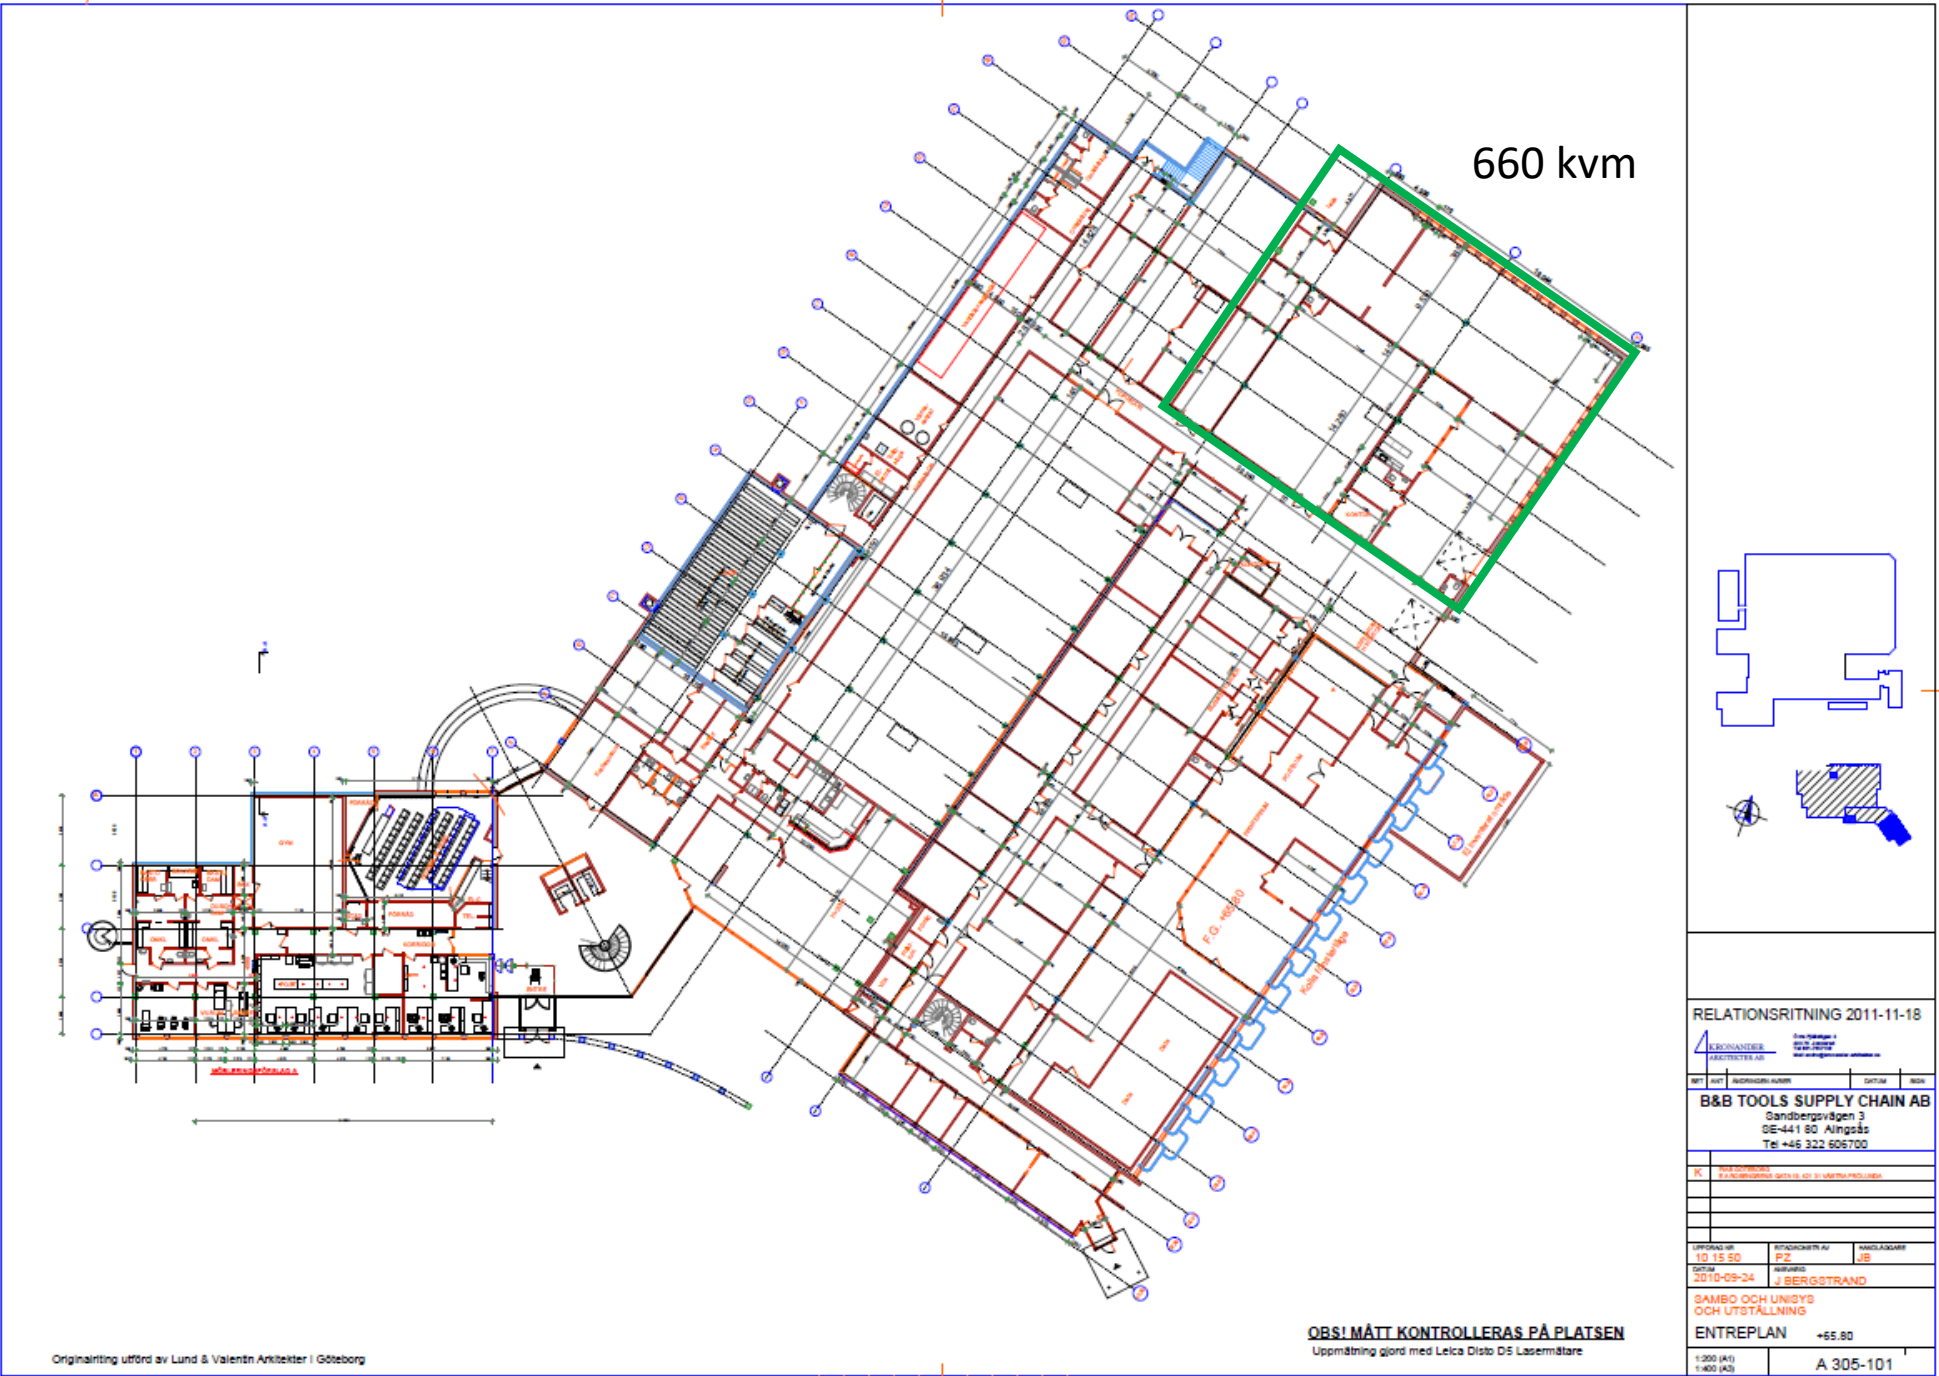

Plan 2

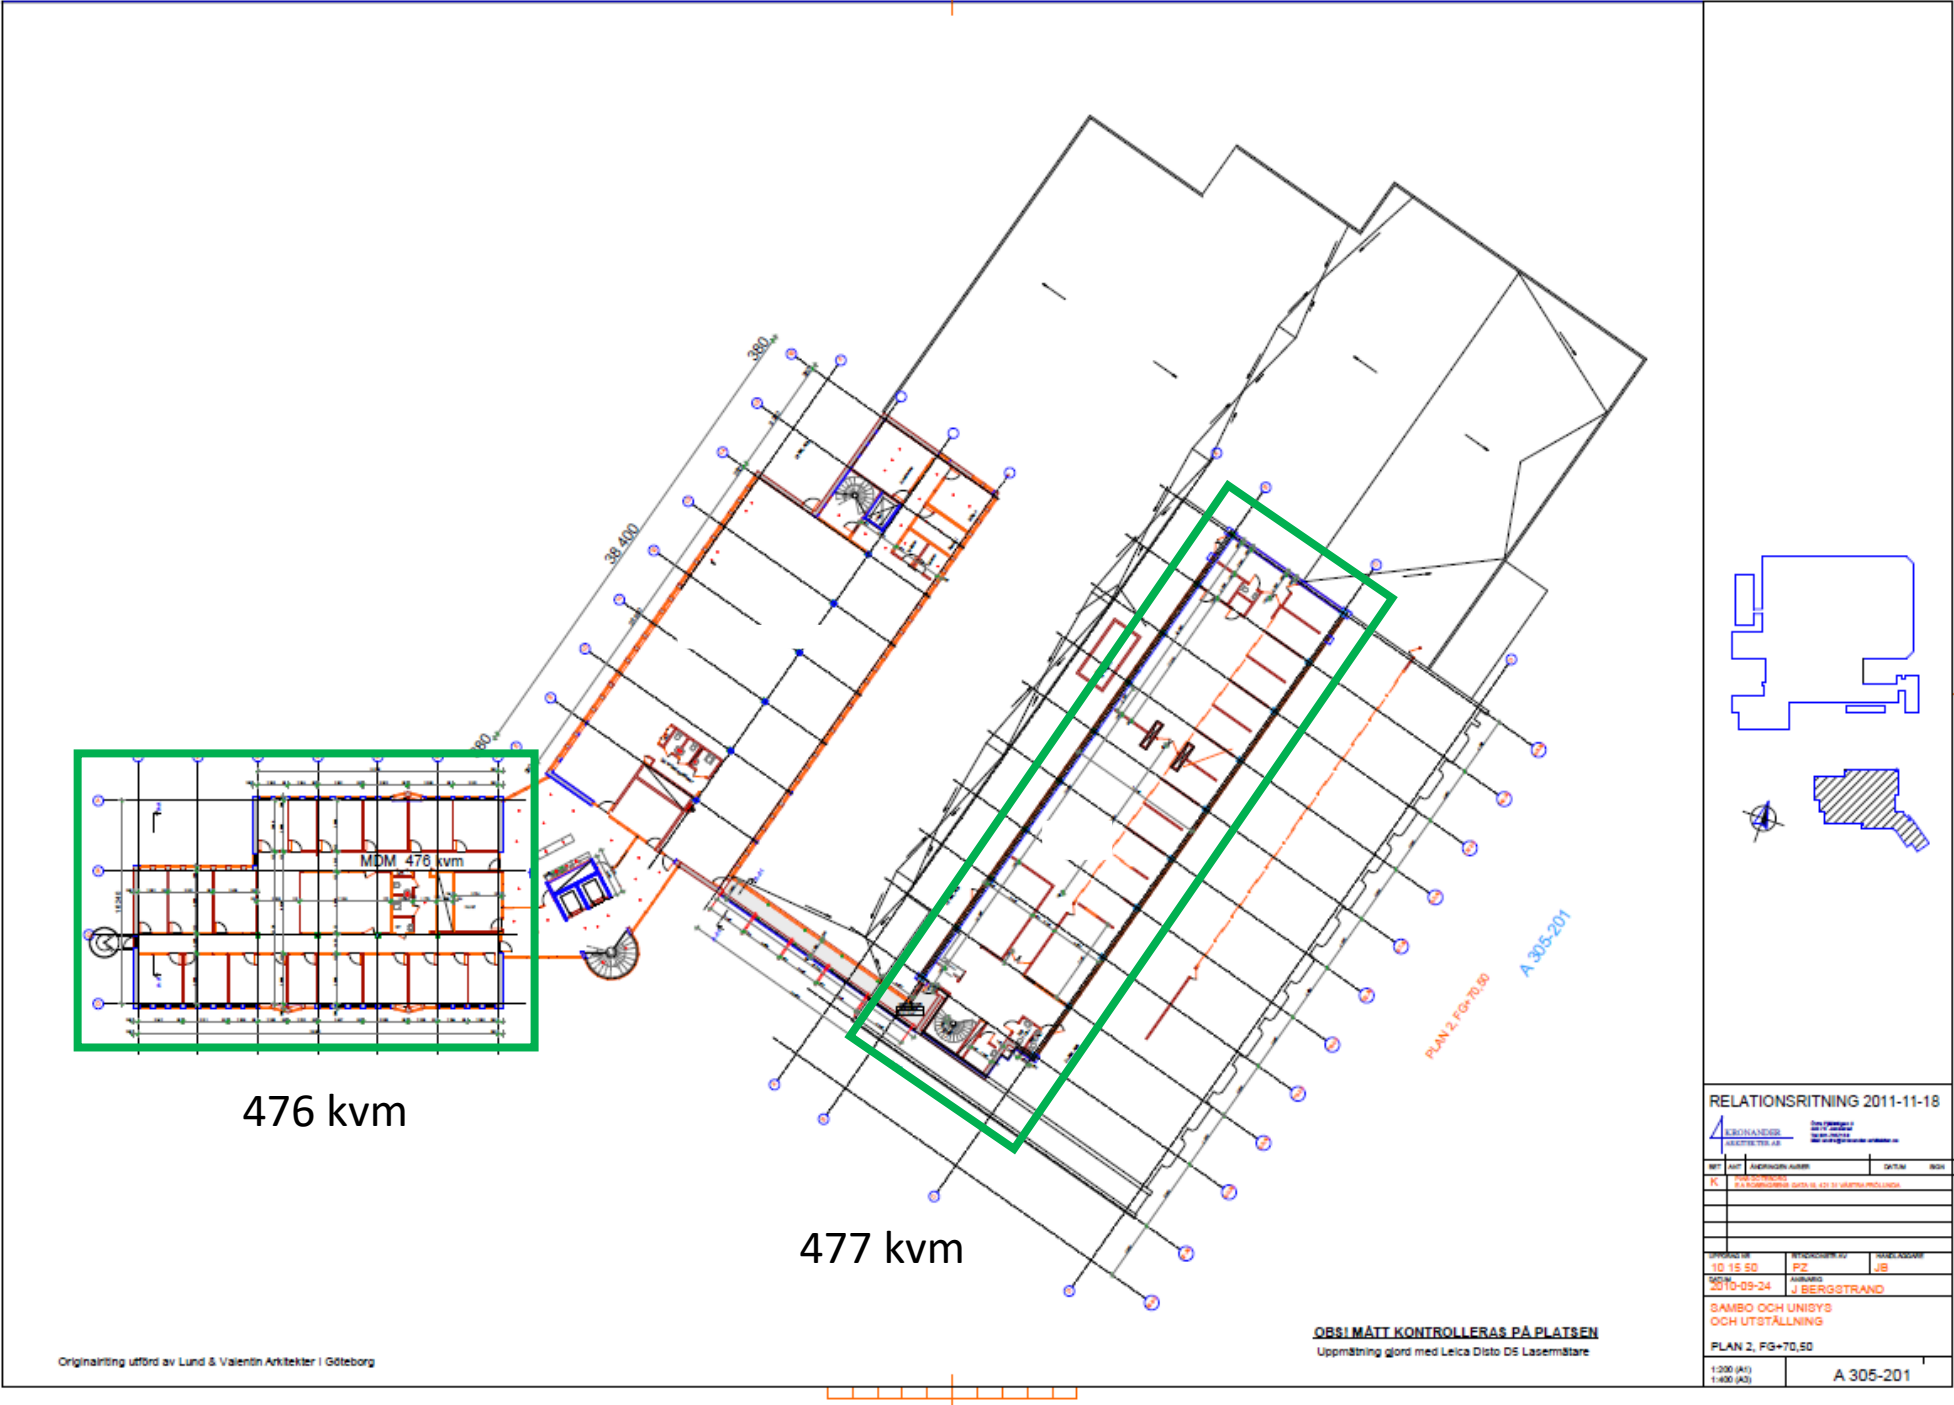

Plan 3

