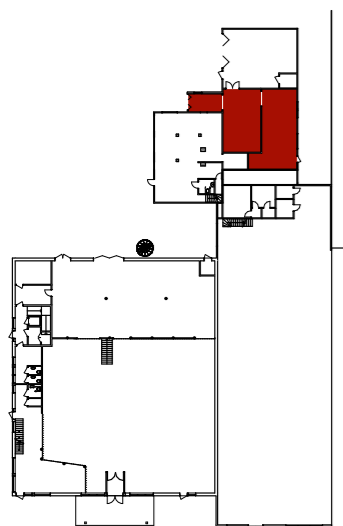


LOA	
LOKAL 4	
Plan 10	123
	123 m ²

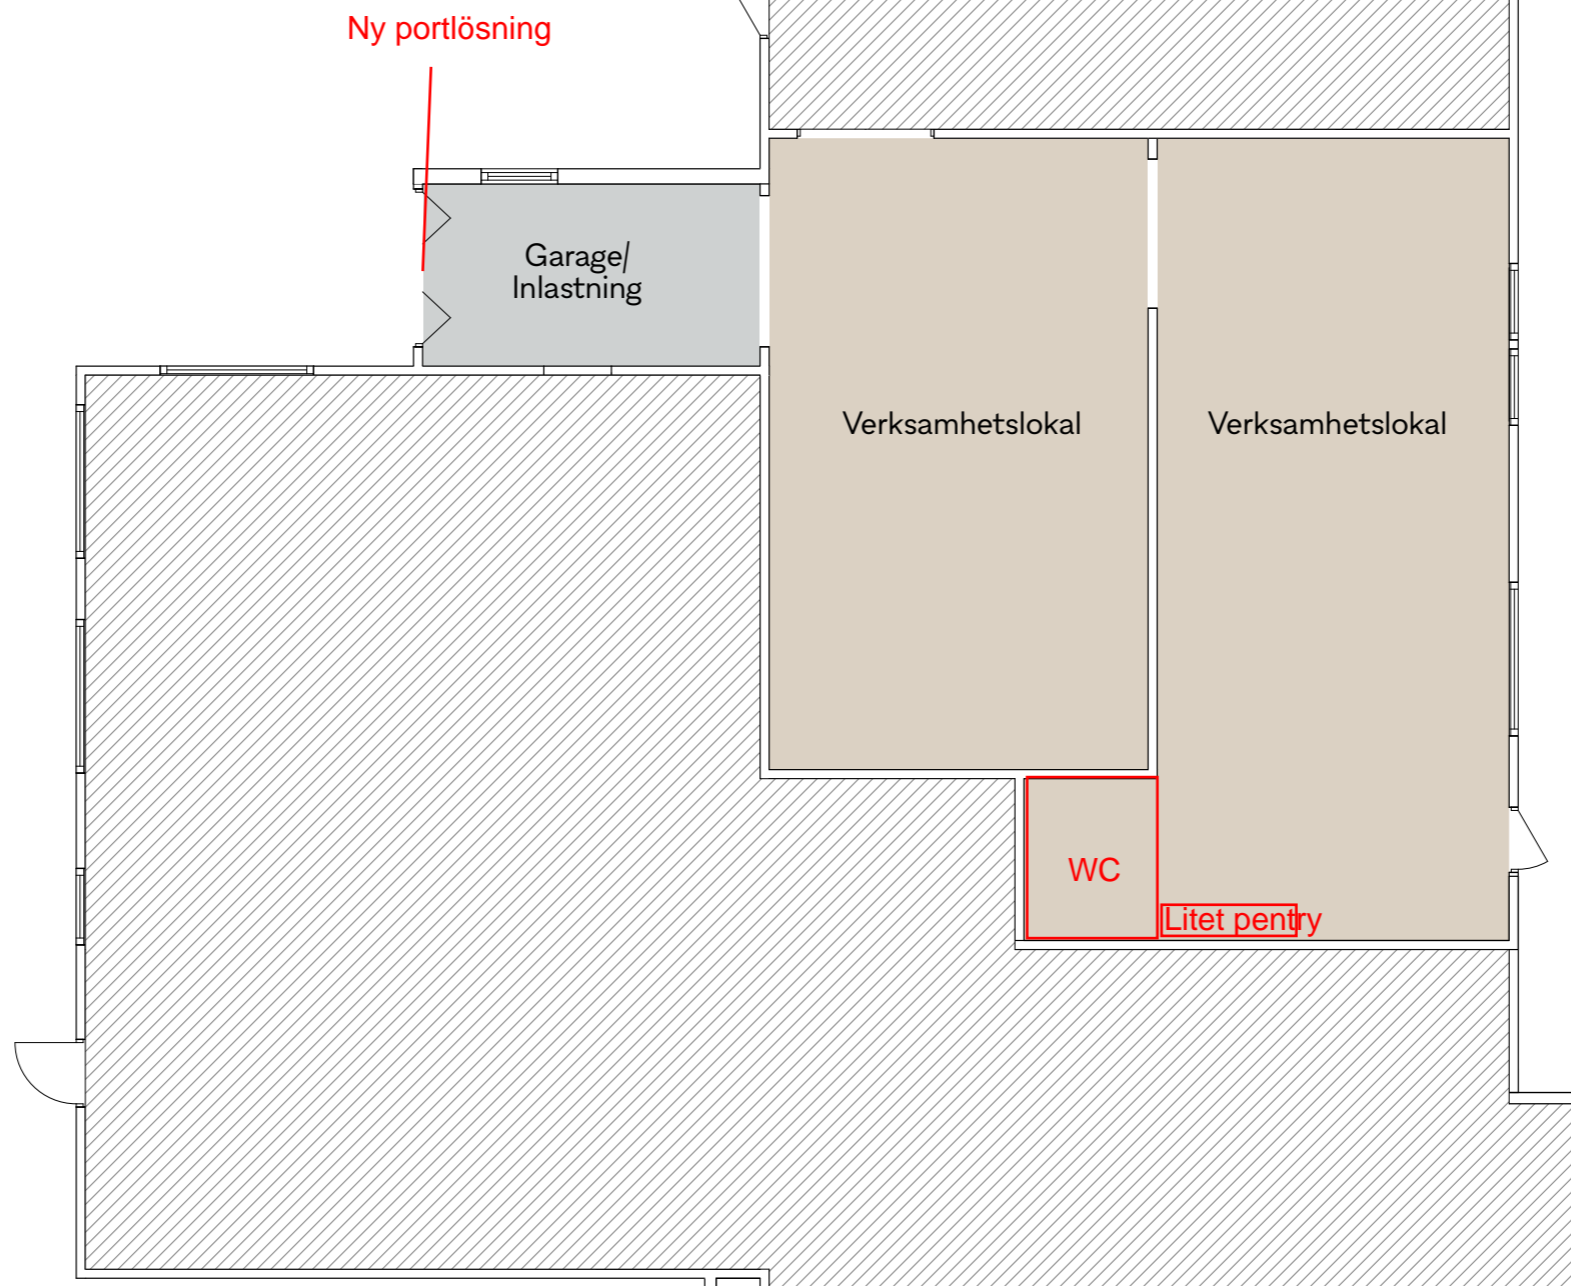

Annan HG



Orienteringsfigur
Plan 1



SKALA 1:100



Plan 1
1:100

