



5330-1005

570 m²

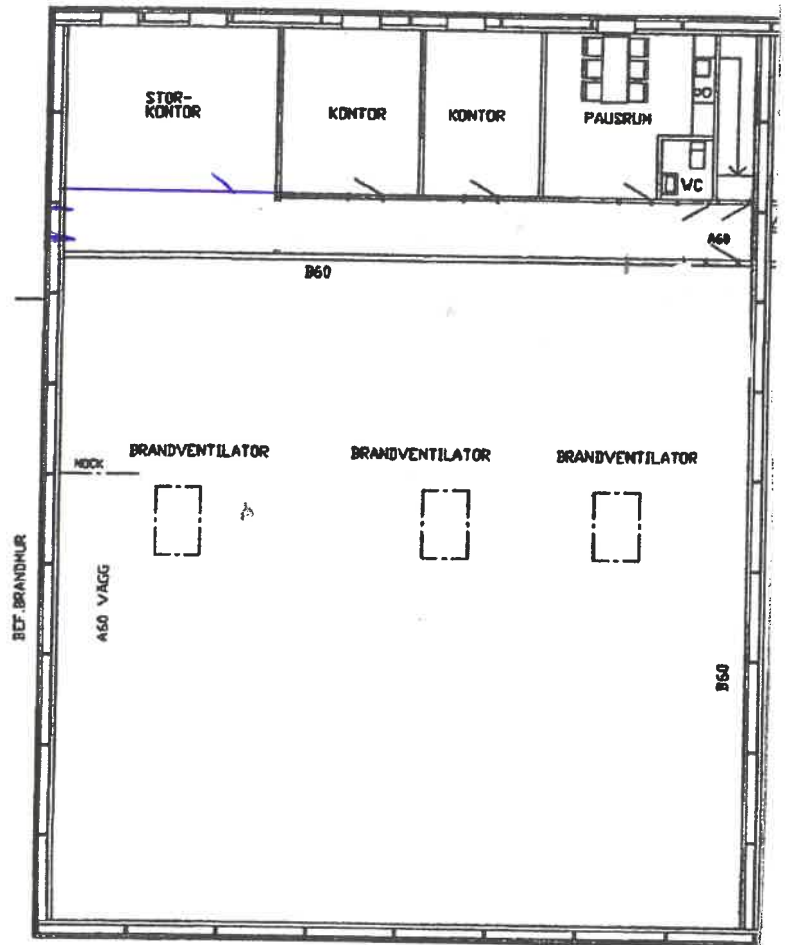

VÅNINGSPLAN 2

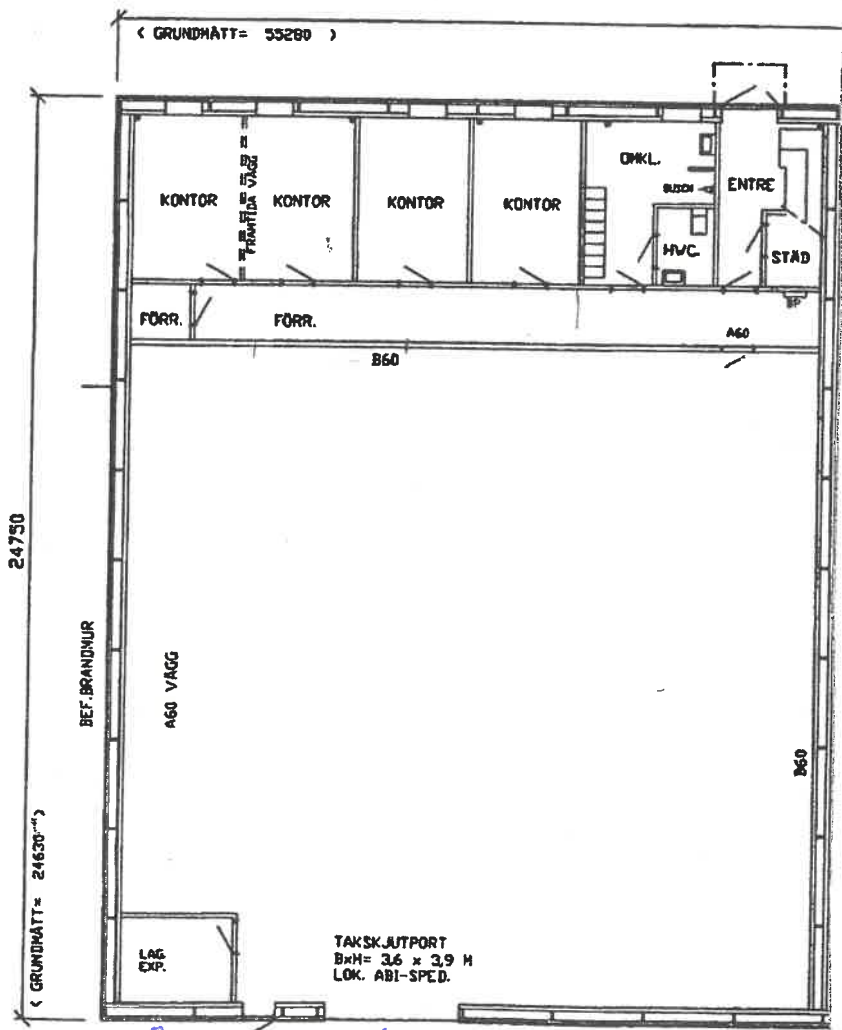

Vår 1 - markplan