


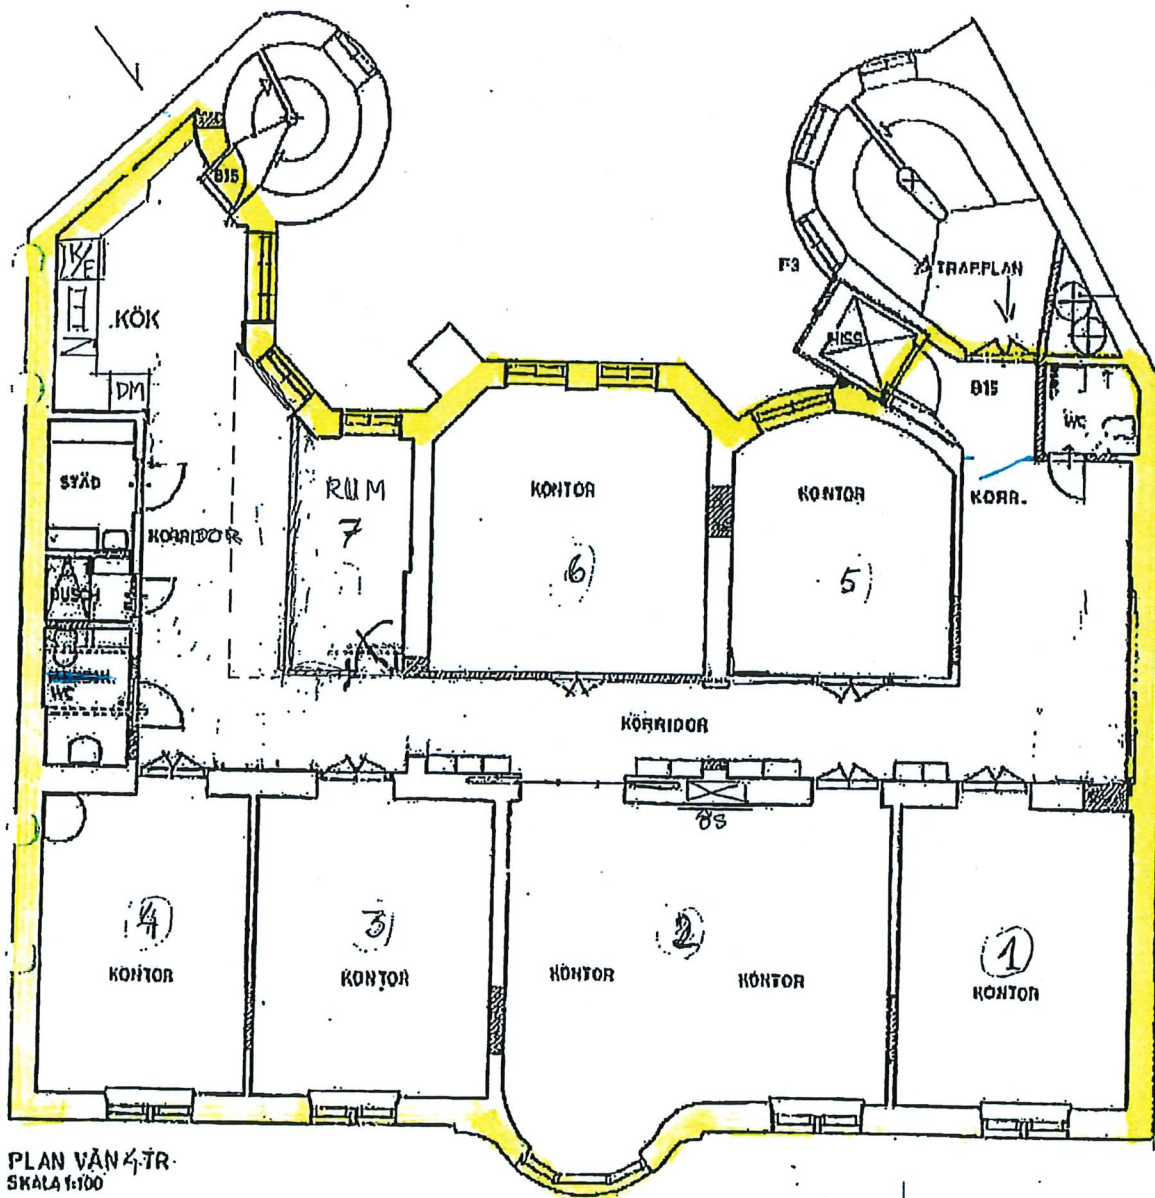

PLAN VÄN 4-TR.
SKALA 1:100