
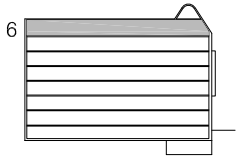


PLAN 6

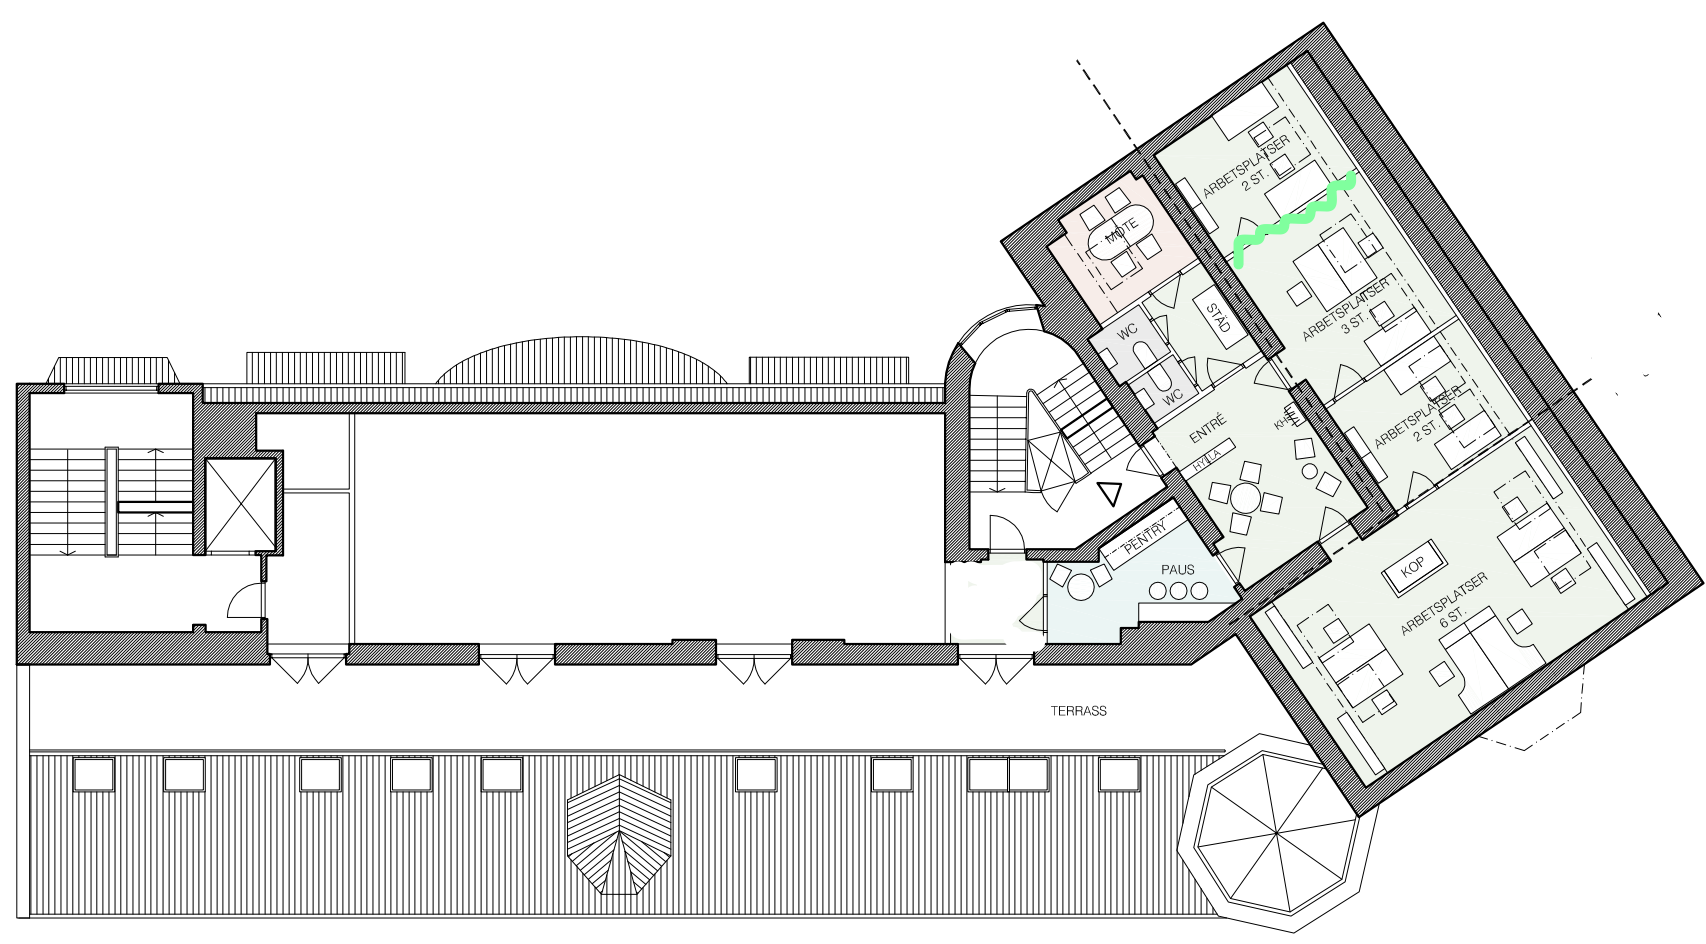

b.

.3'

1:200 (A3)

