



VÄLLINGBY CENTRUM

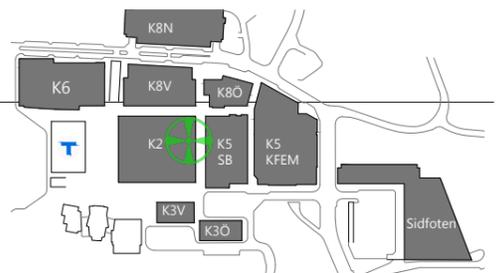

Status: ORIENTERINGSRITNING	
Drawing nr: OBJEKT 0063D	
Vällingby Centrum	
 NREP	rev:
	scale: 1:300 A3
date: 2025.02.07	level: PLAN 05

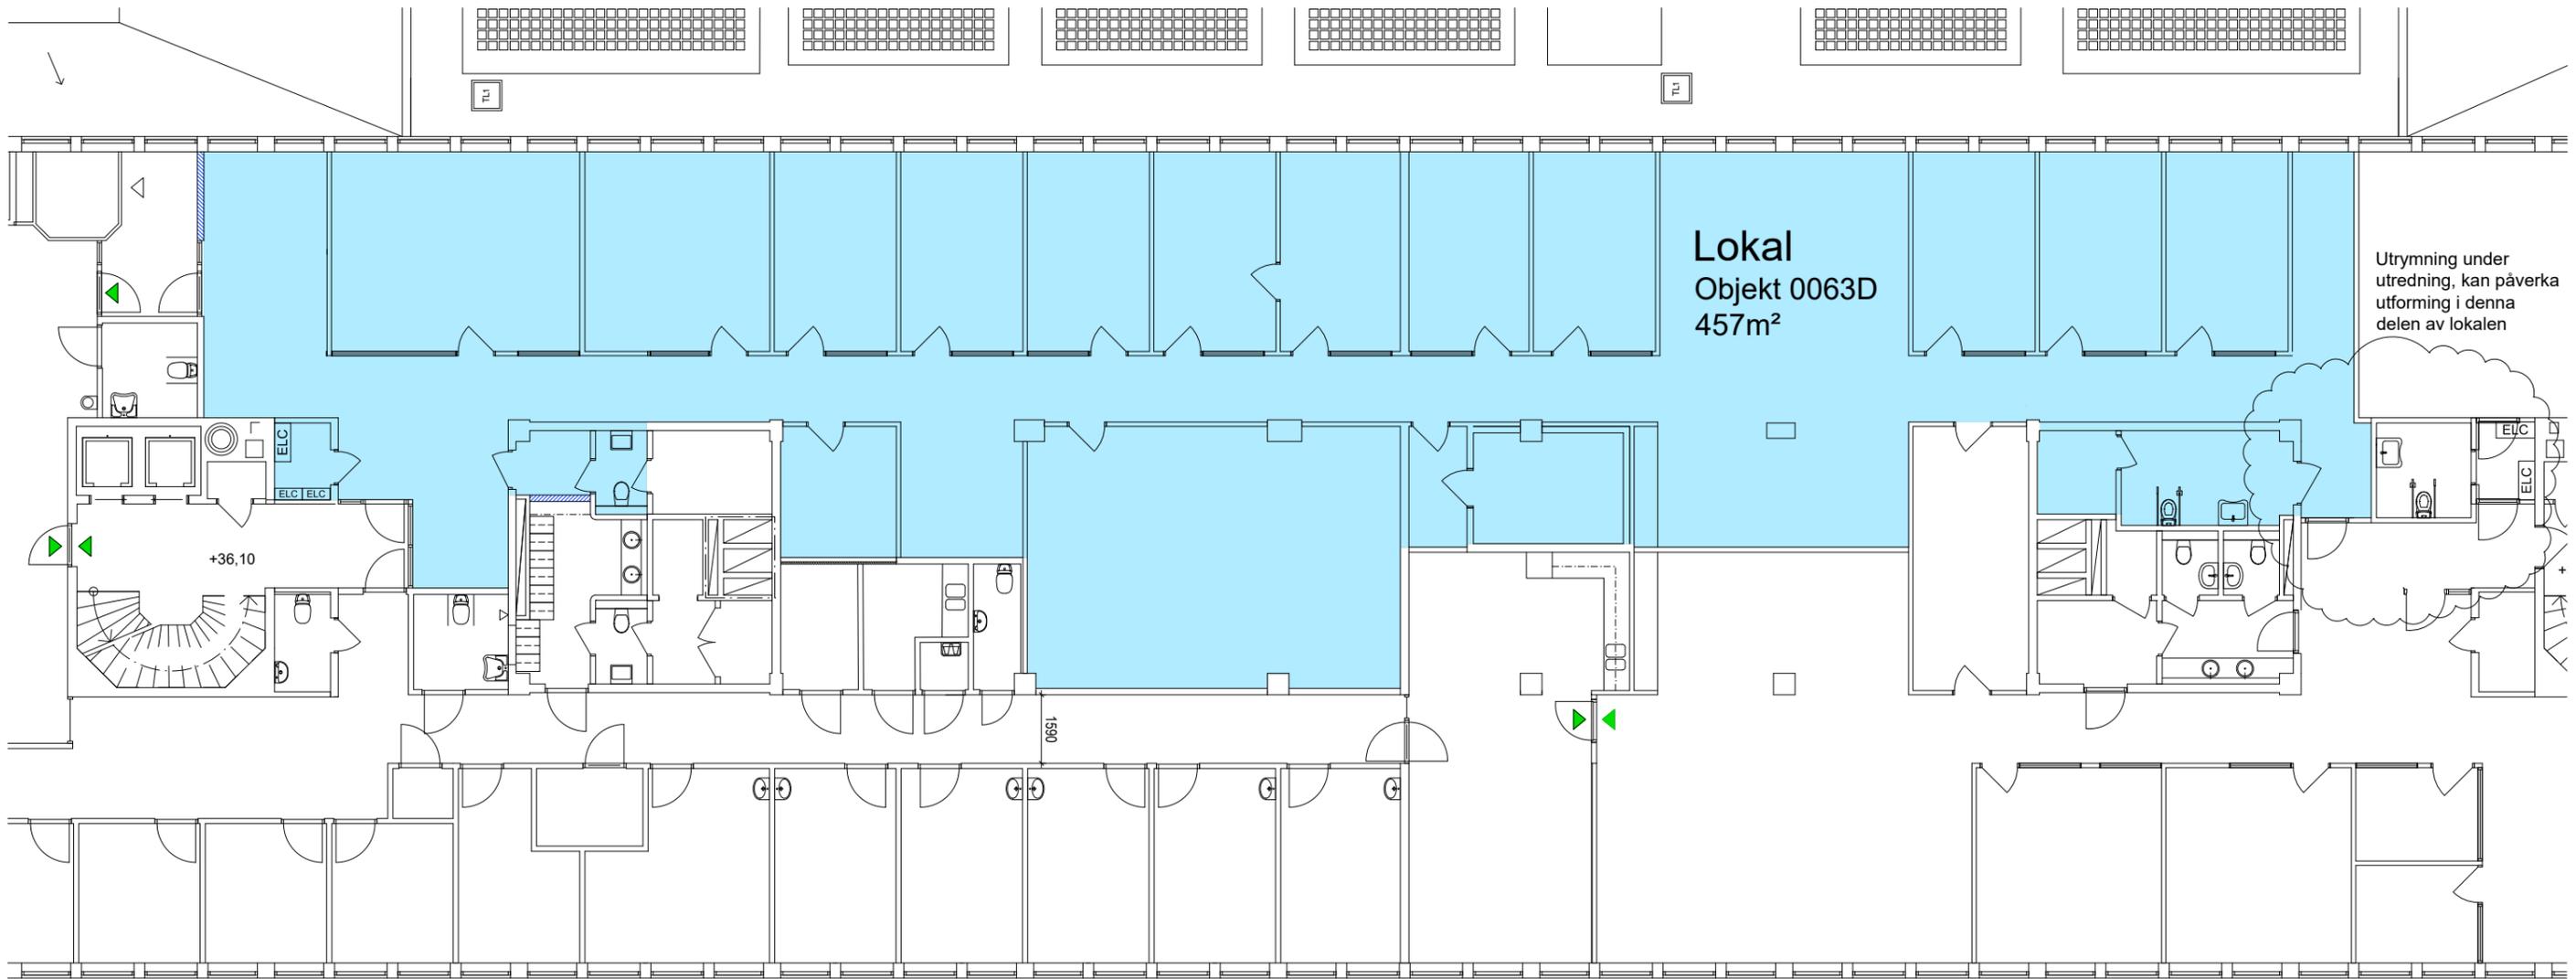

Status:		Leasing Drawing	
Drawing nr:		OBJEKT 0063D	
Vällingby Centrum			
 NREP	rev:	scale:	1:150 A3
	date:	level:	PLAN 05
	2025.02.07		



VÄLLINGBY CENTRUM

