


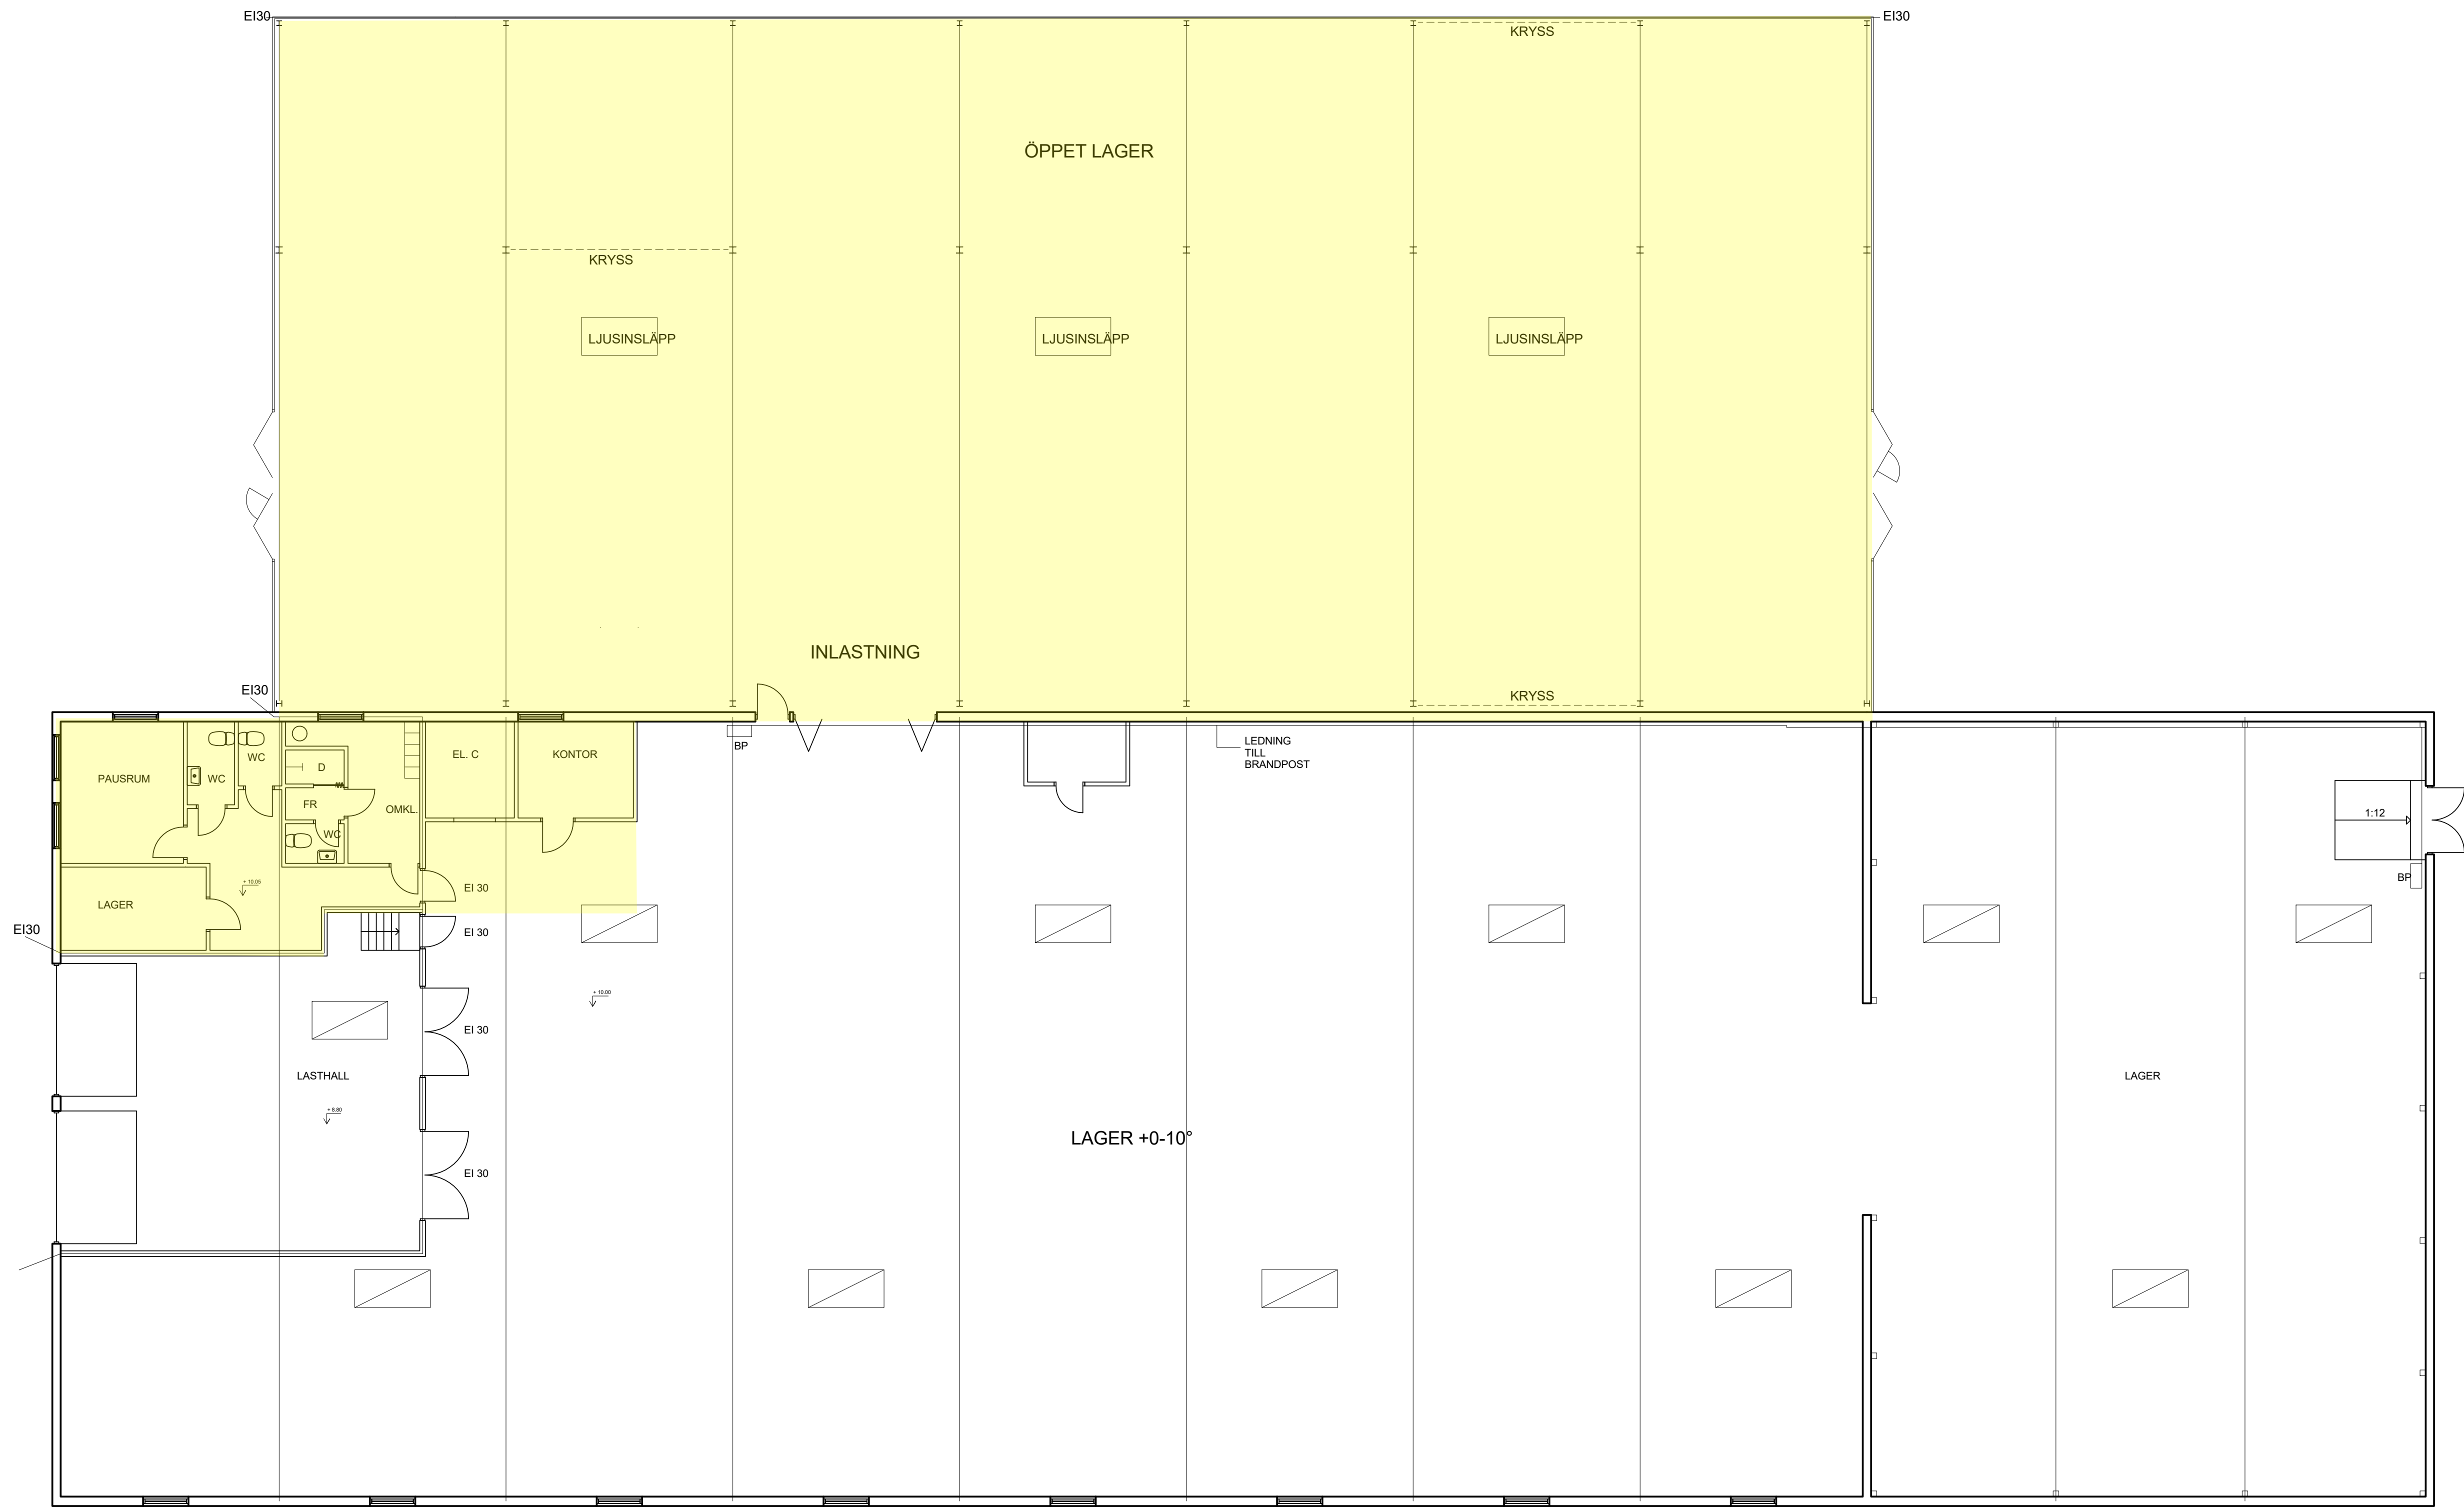

Odalbygden 7

Status	Relationsritningar	Scale	1 : 100 (A1)	Architect	Marcus Holmgren	Client	Vasaparken	Constructor	.
Address		Project no.	001	Address	Bandargatan 37	Address	Apotekargatan 14	Address	.
		Date	17/11/15		115 22 Stockholm		582 24 Linköping		.
Title	Plan - Del II	Responsible	Administrator	Mail	marcus@holmgrn.com	Mail	info@vasaparken.se	Mail	.
No.	005	Checker		Phone	+46 707 142601	Phone	+46 13 242030	Phone	.

