


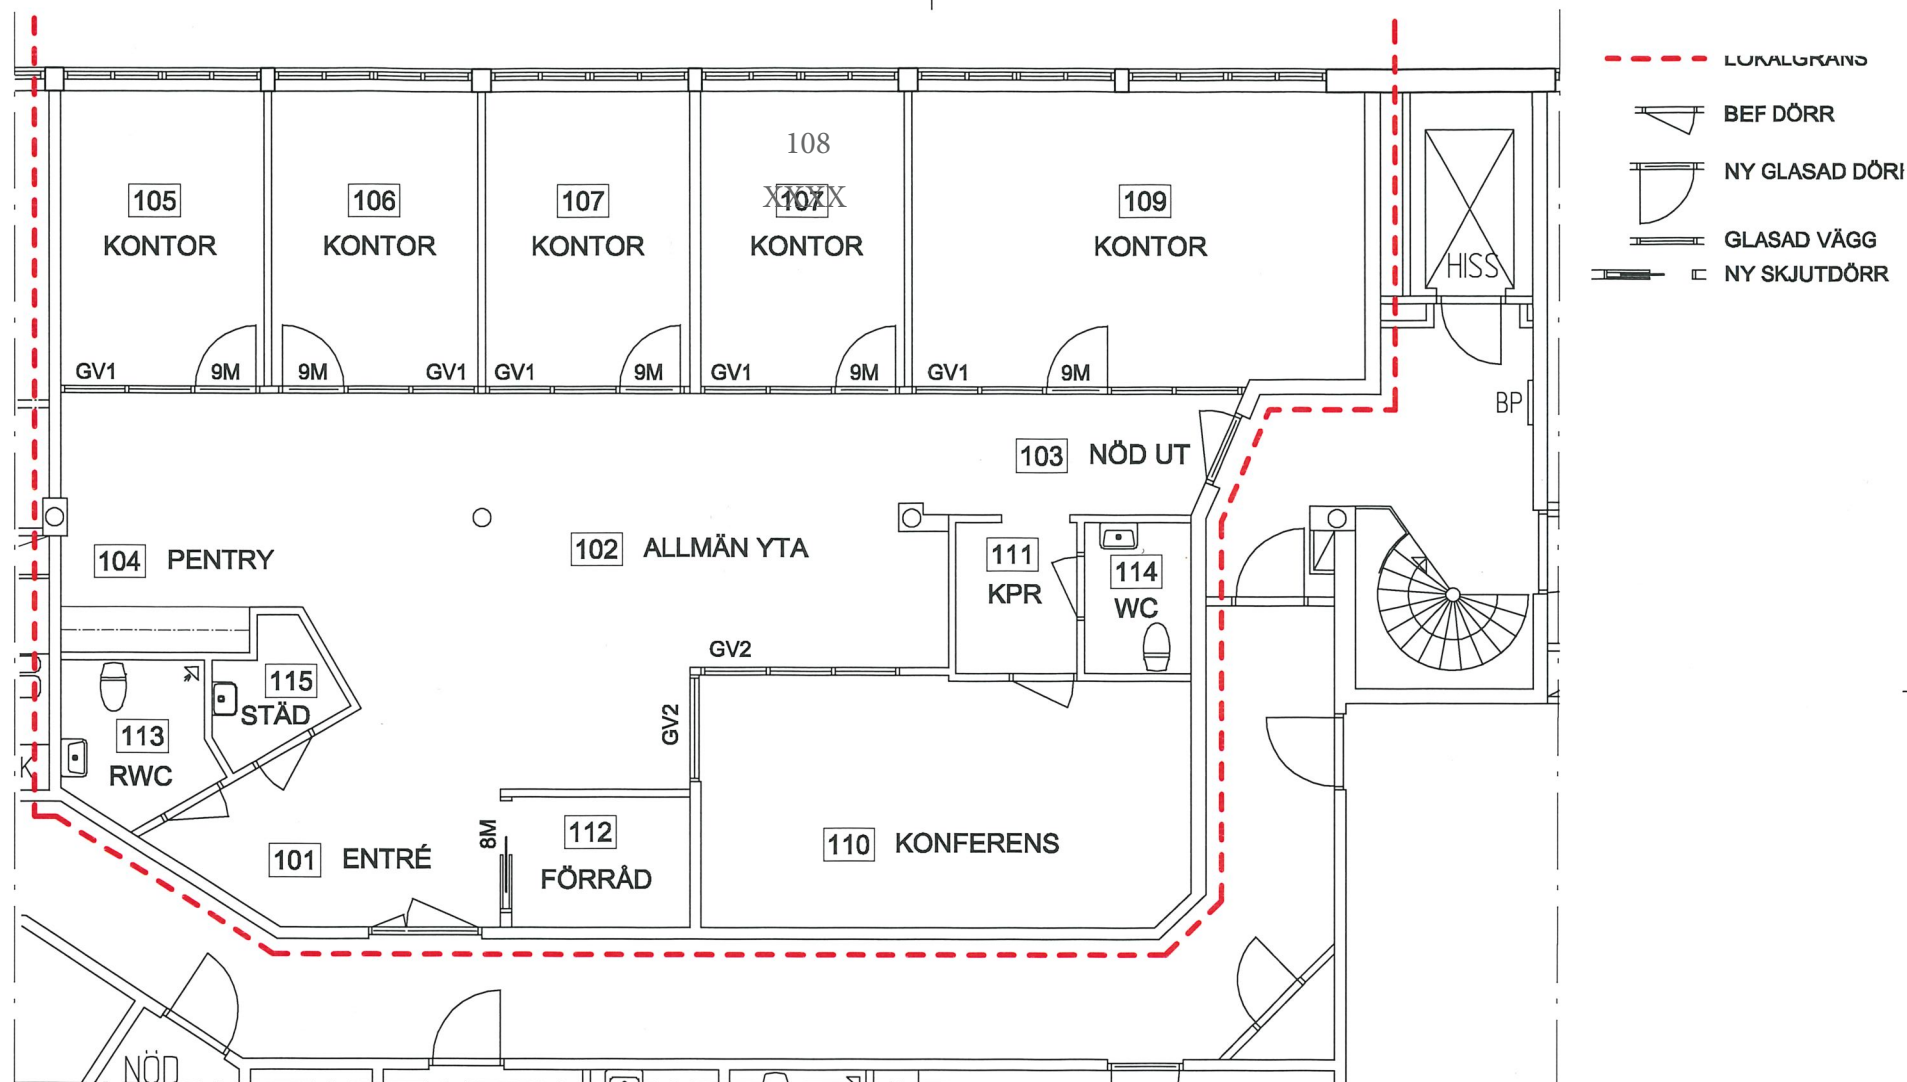

PLAN 1 TRAPPA
KV SIGVALD 6, VÄSTERÅS

RITNING 2022-03-16
KV SIGVALD 6, VÄSTERÅS
LOKALER TILL TENREP AB

SKALA A4 1:100
METER



MyArk

NYFOSA