


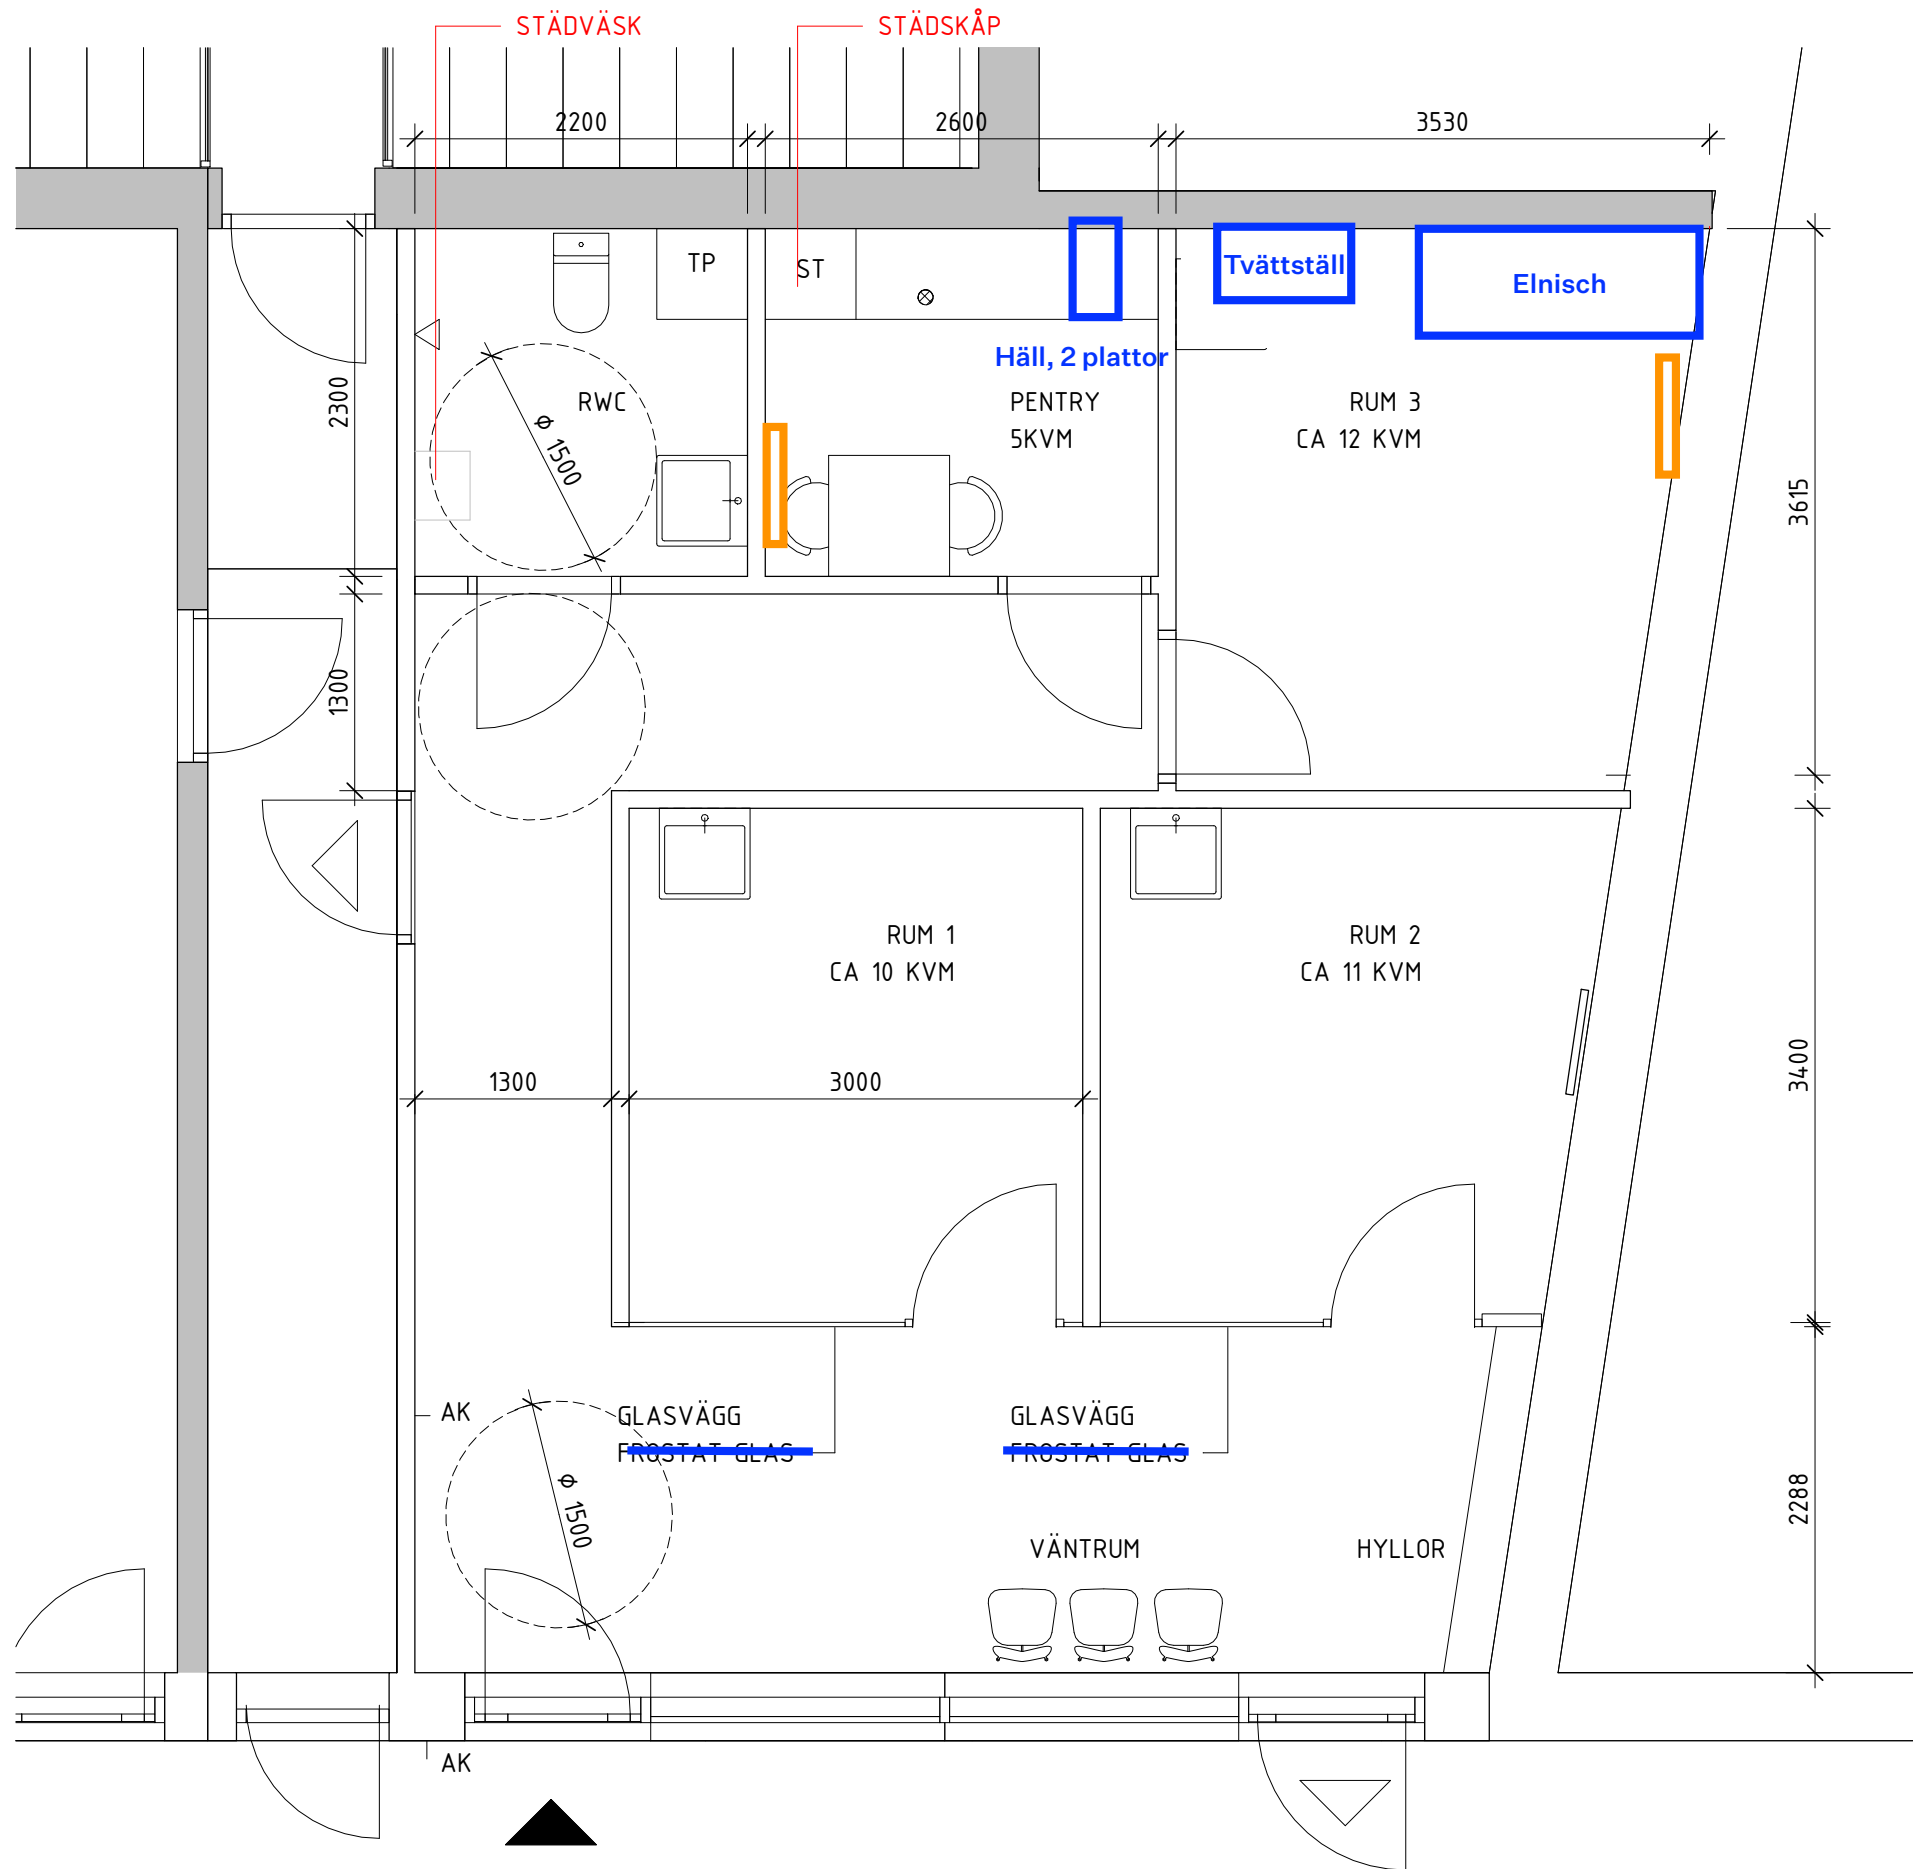

LOKAL 51008 - F8 BEAUTY CENTER

radiator



DINELLJOHANSSON
PROJEKT BARKARBYSTADEN KV.11
SKISS Lokal 51008
DATUM 2022-09-08