





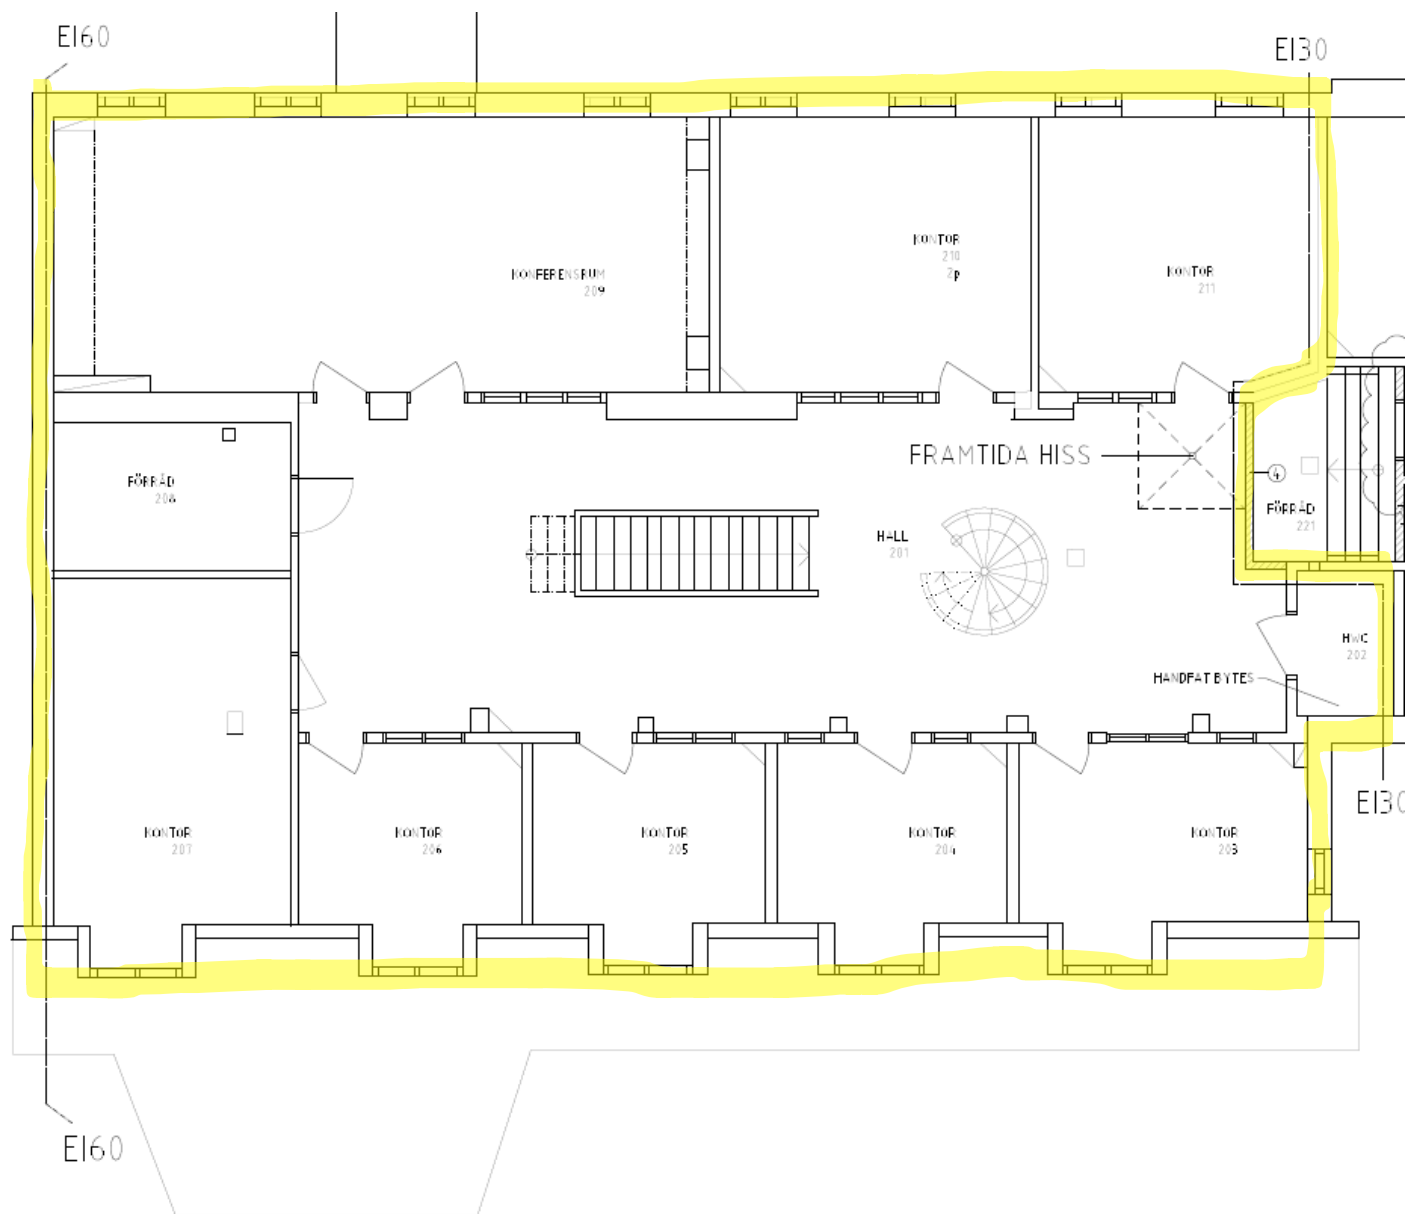

PLAN 2

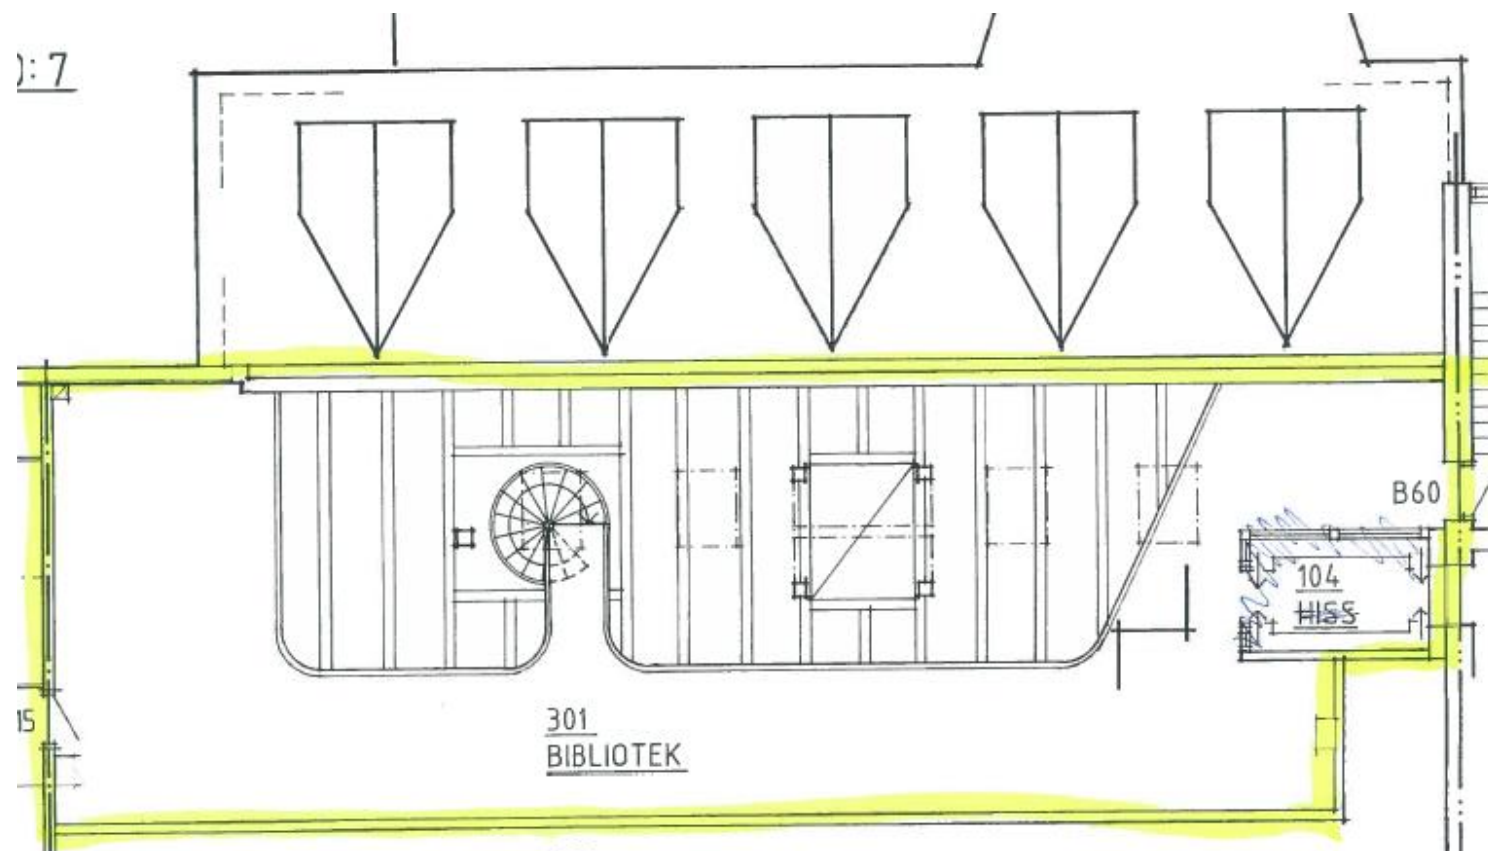

Plan 3