


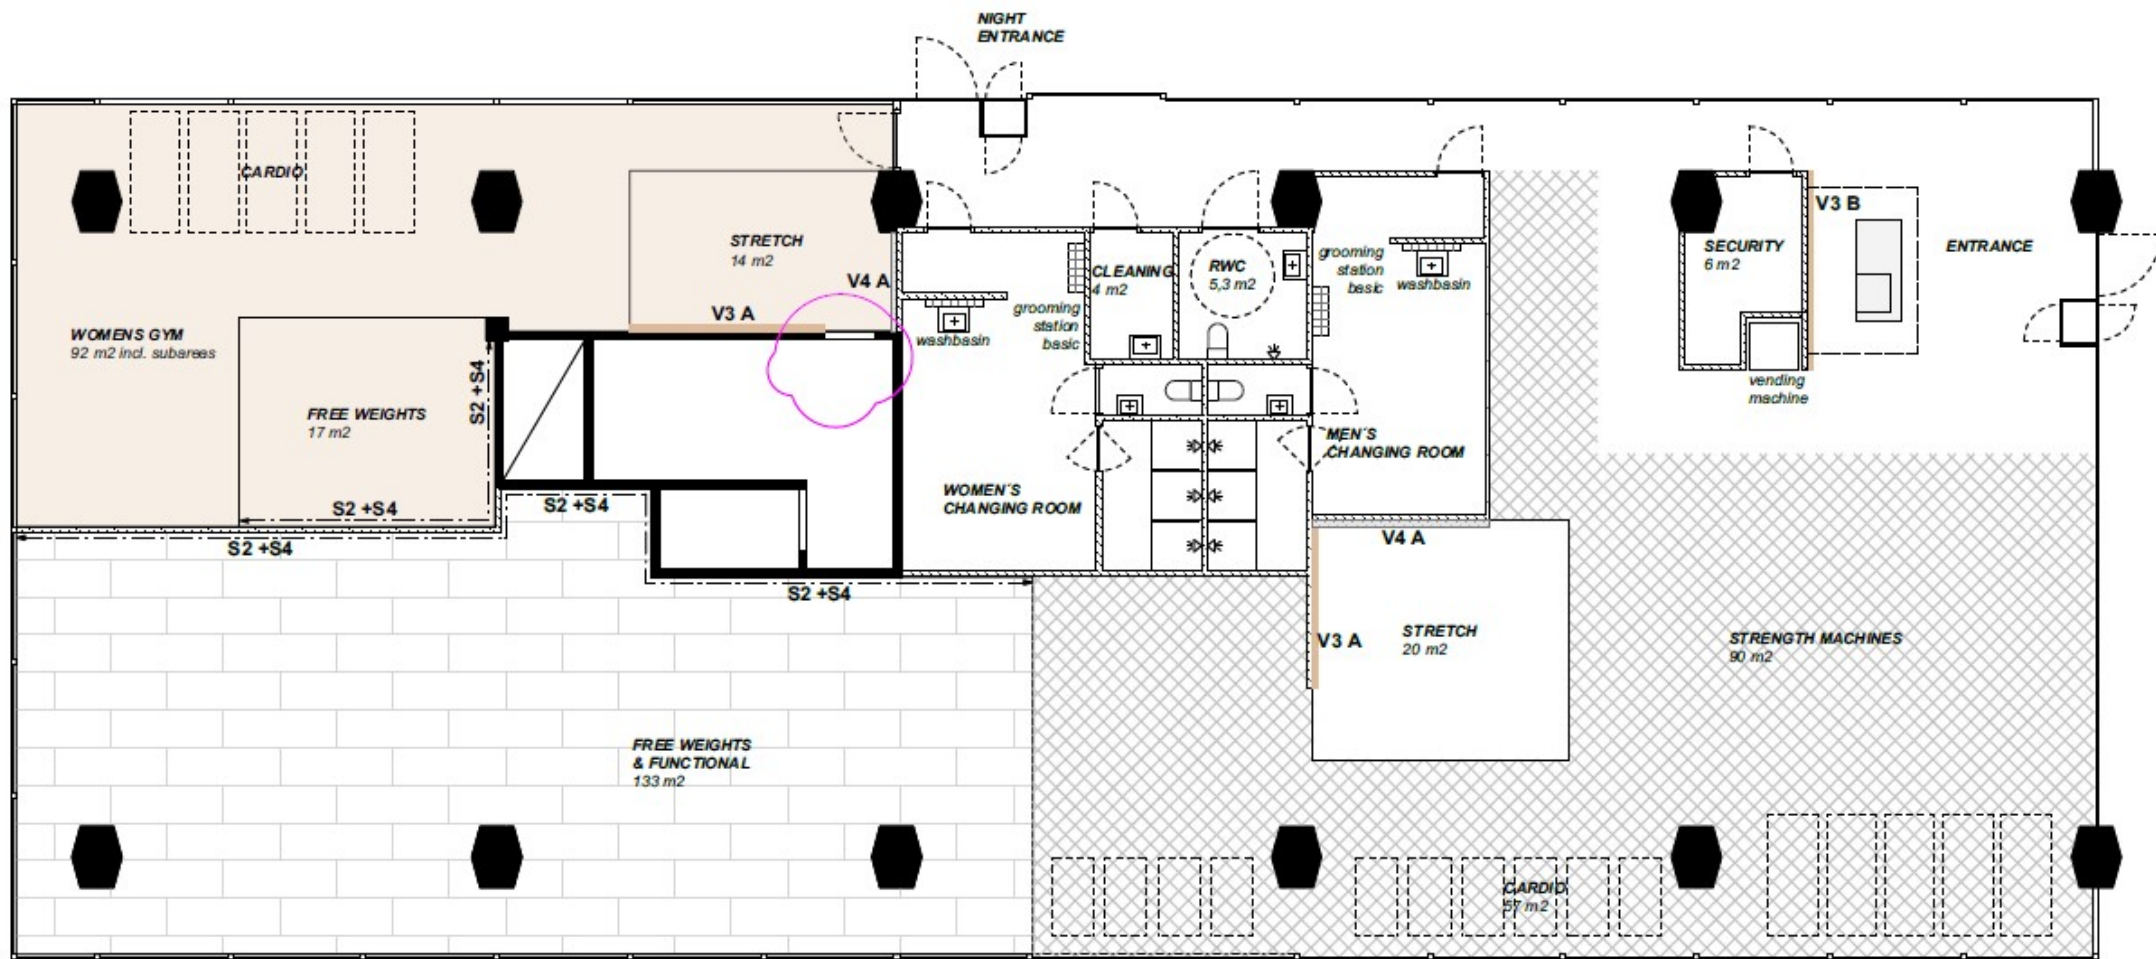

555 m²