


Bar/restaurant



Appendix 3 - Drawings

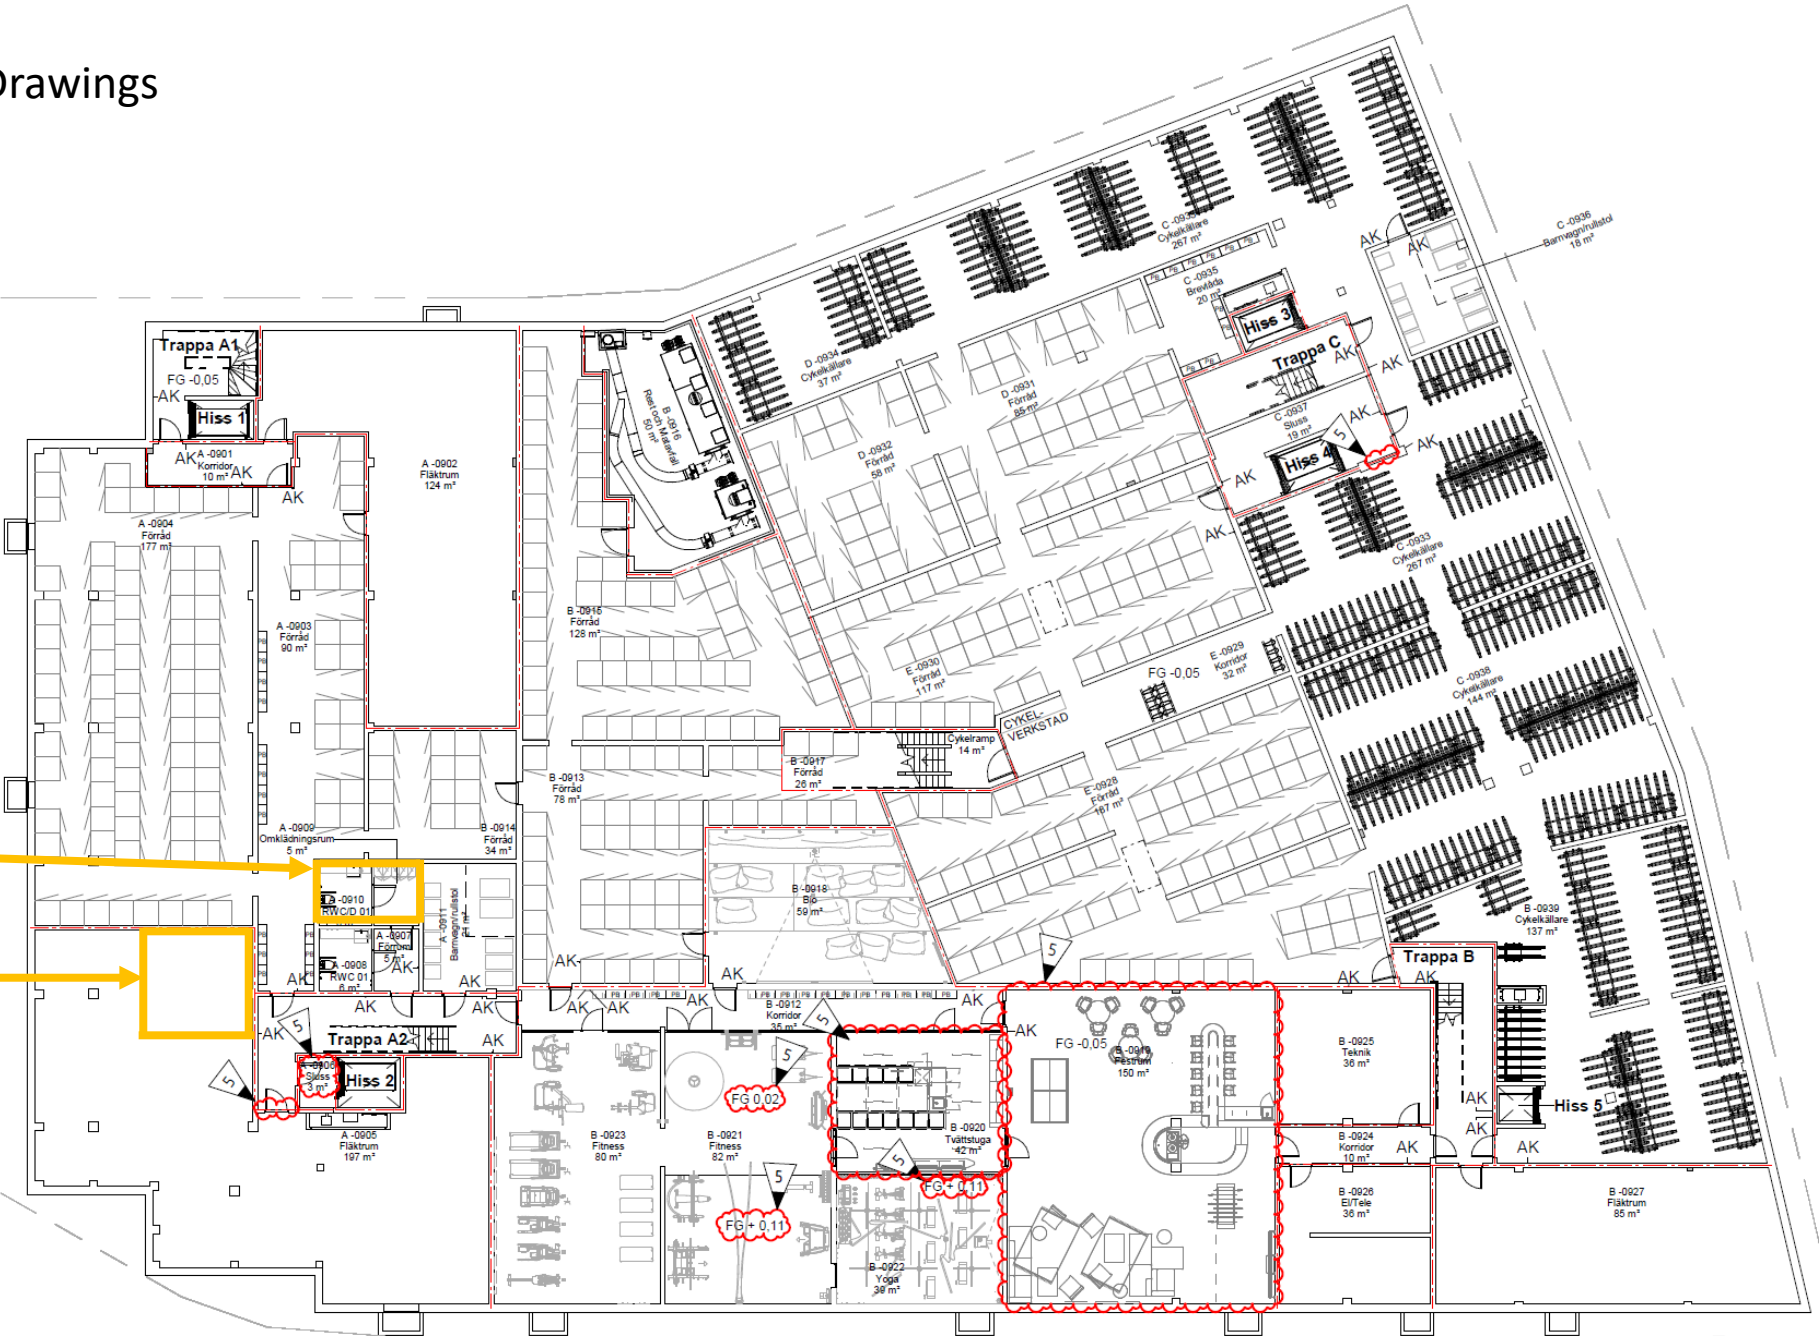

Jointly referred to as
"other areas" in the
lease form