



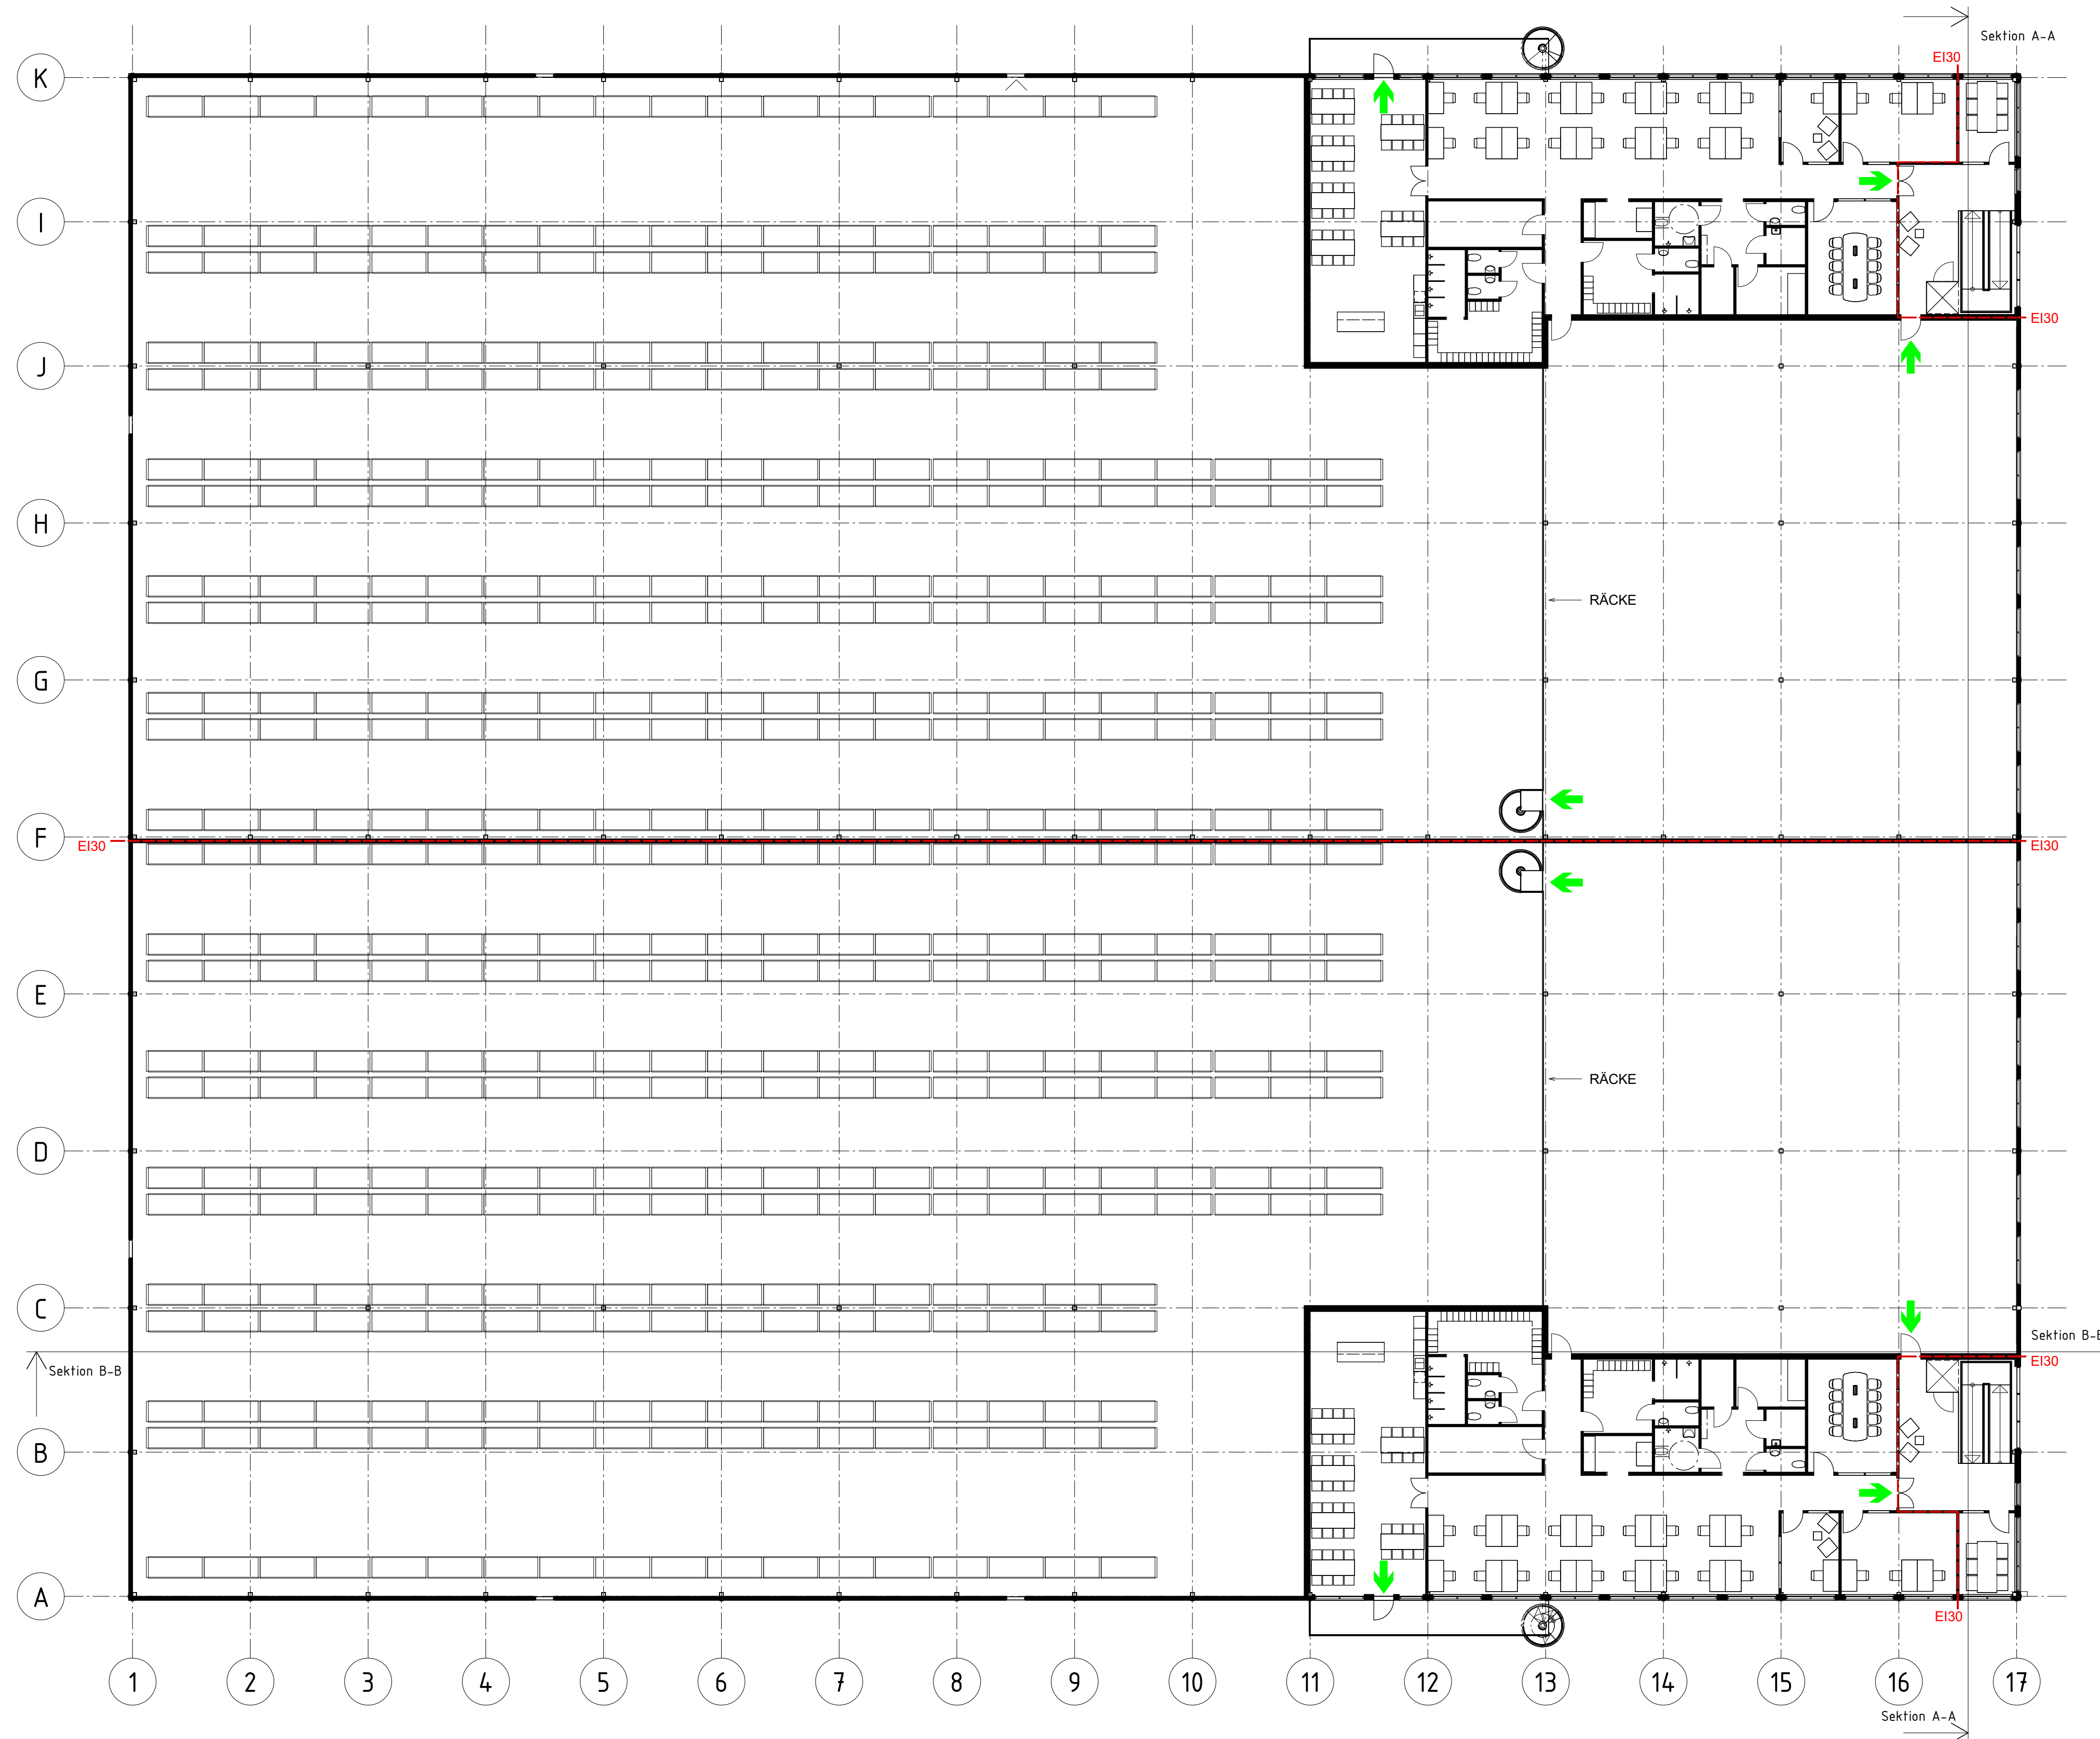

Plan 2
1 : 200

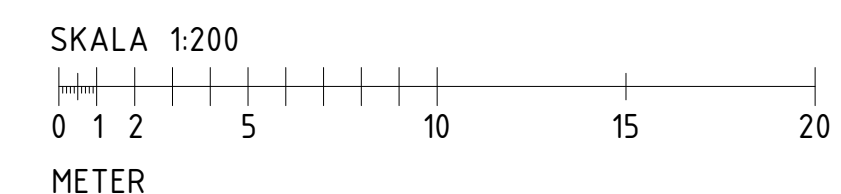

2024-01-15
REV A 2024-02-06 - BRANDGRÄNS

BYGGLOVSHANDLING		
LOGICOR Rosersberg 11:151		
☒ A	YLAB	Phone 036-800 87
PROJECT NR	DRAWN/CONSTR. BY	PROJECT DESIGNER
DATE	PROJECT MANAGER	ME
LOGISTIKBYGGNAD Plan 2		
SCALE A1 1:200 A3 1:400	NUMBER A-40-1-1200	A