


ENSTIPELISKATN

LOTLANDSKATN

ANDRAD EITN (SULTBESIKTN) 19/6/78

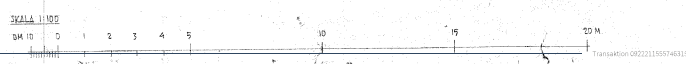

REV A KUTUR - BUTIK 97 10 27 67

KV. ROVAN NR II	19/72
BOTTENNING	1978
HENEV LETTJOLM	2
ZECITELT 08/04/93/90	

Transaction: 00221155746318771

