


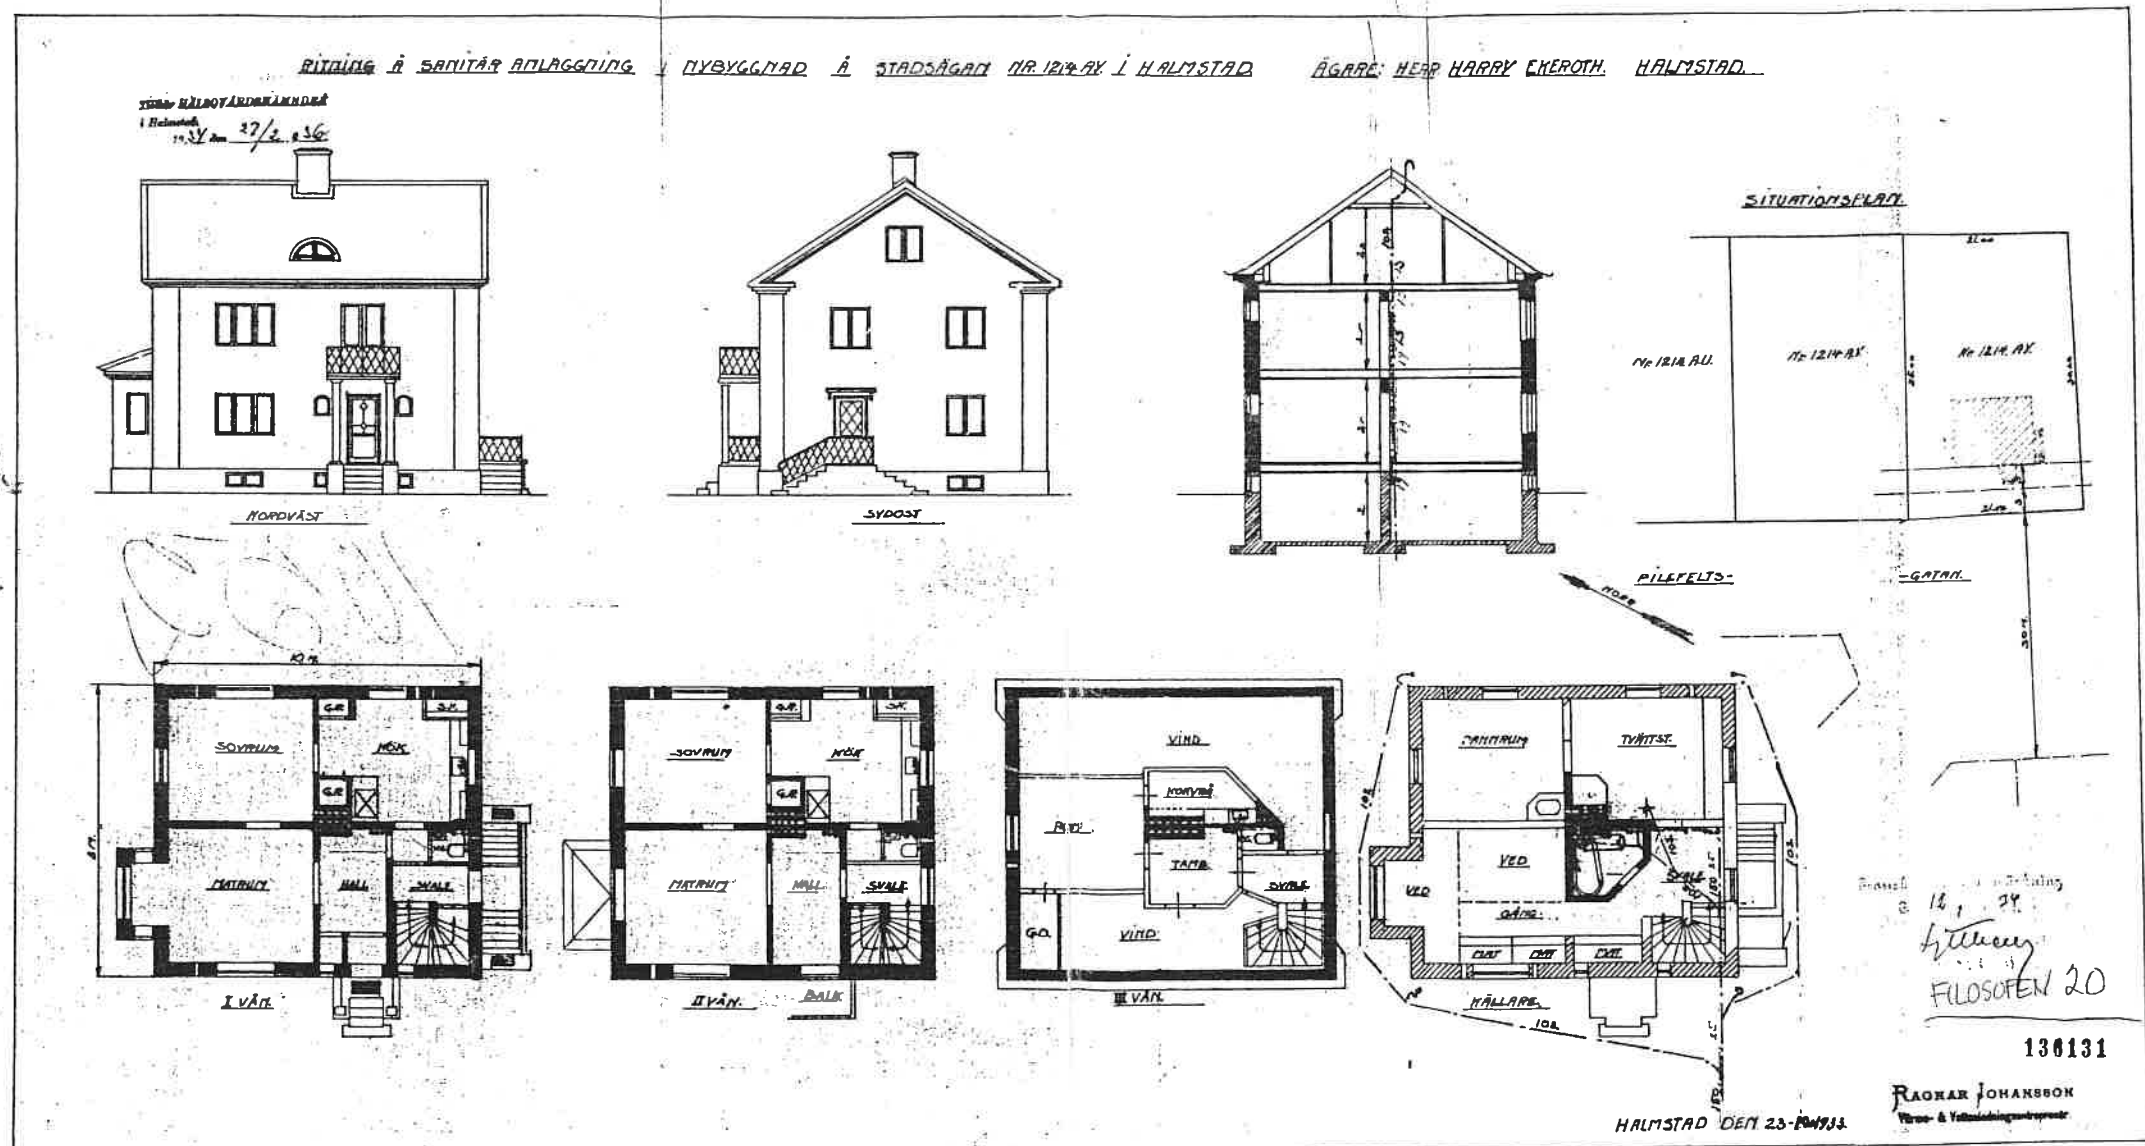

Pilefeltsq. 41