


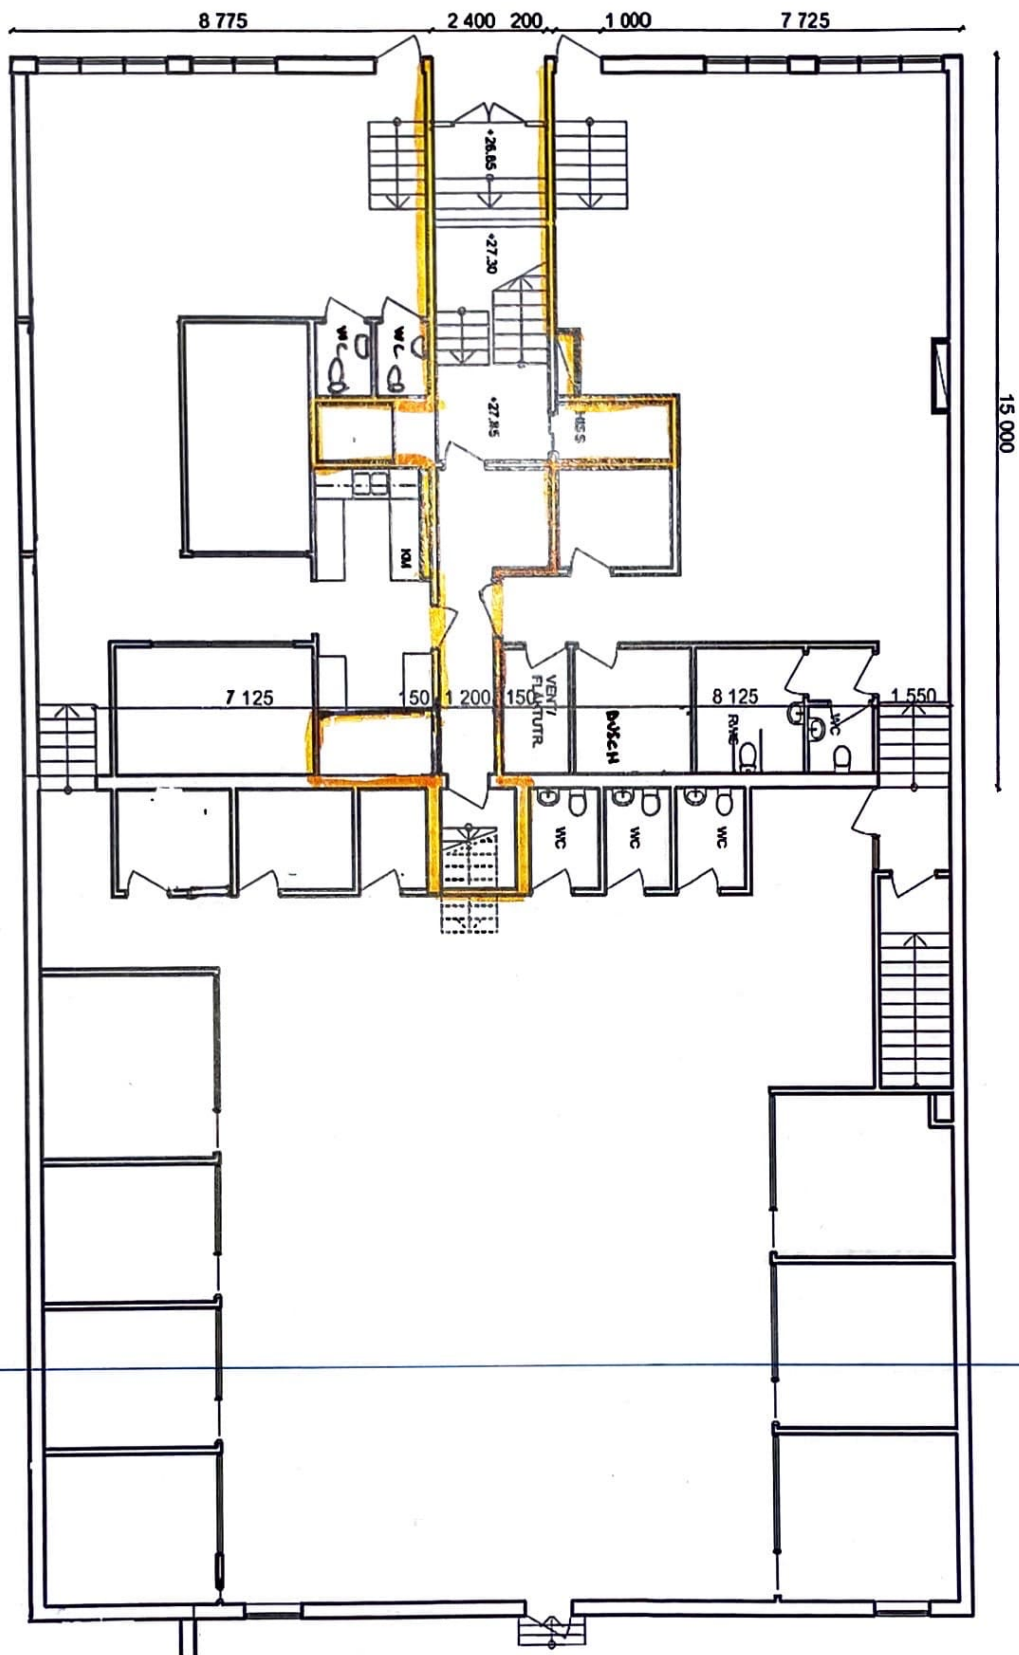

9
MK