




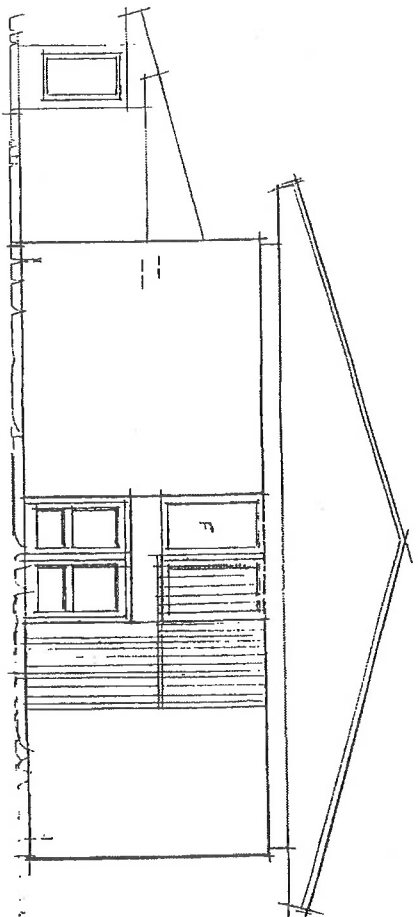

FASAD: X/000143T

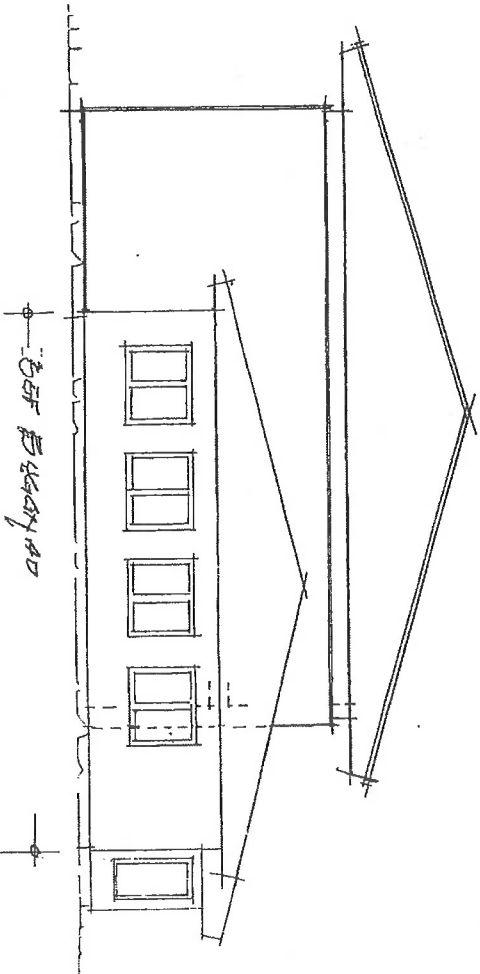

FASAD: X/000143T

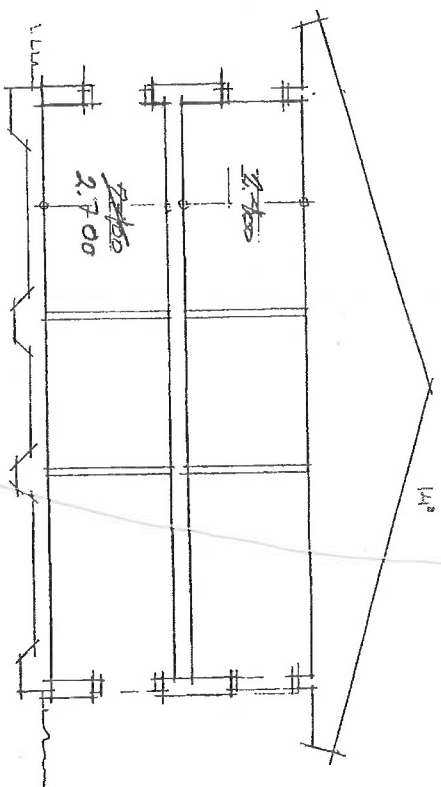

FASAD: X/000143T

[Handwritten signature]

OFFERTRNING
Offer nr 131-1303
20.11.2009

KV ÖGLAN 1: 17, ILANDA KARLSTAD

Kenneth Wahlström Entreprenad AB

Ny kontorsbyggnad, SEKTION FASADER

Karlstad 2009 10 10

Skala 1:100

[Handwritten signature]

BST Byggnad

Fasad Fasad

Fasad Fasad

BST Byggnad

OFFERTTILLNING
Offert nr. 201-15109
Åb. d. 2009, 10

KV ÖGLAN 1:17, ILANDA KARLSTAD
Kenneth Wahlström Entreprenad AB
Ny kontorsbyggnad FASADER
Karlstad 2009-10-10
Skala 1:100
Kenneth Wahlström