


Bilaga 1

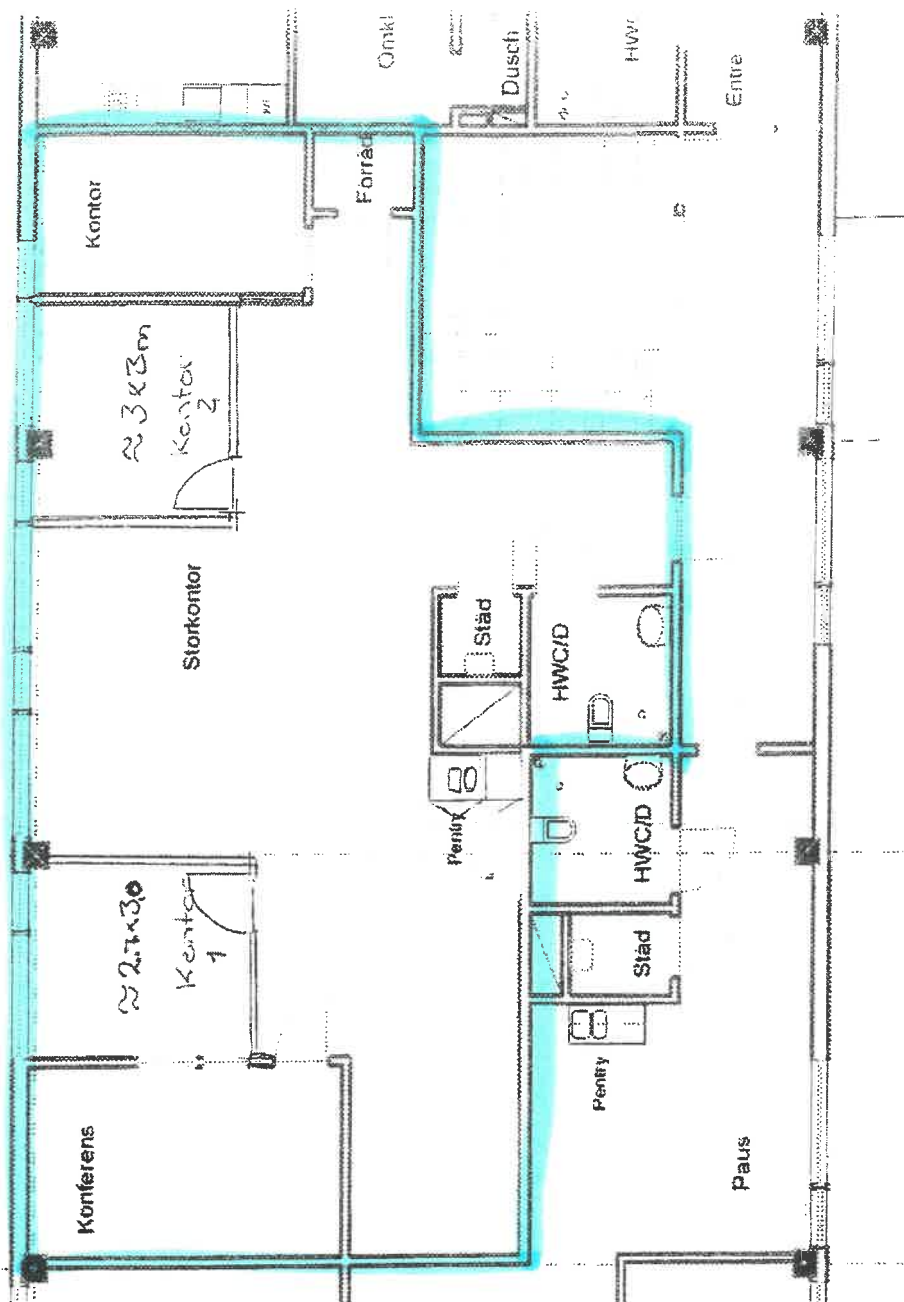

46 800

KIM