


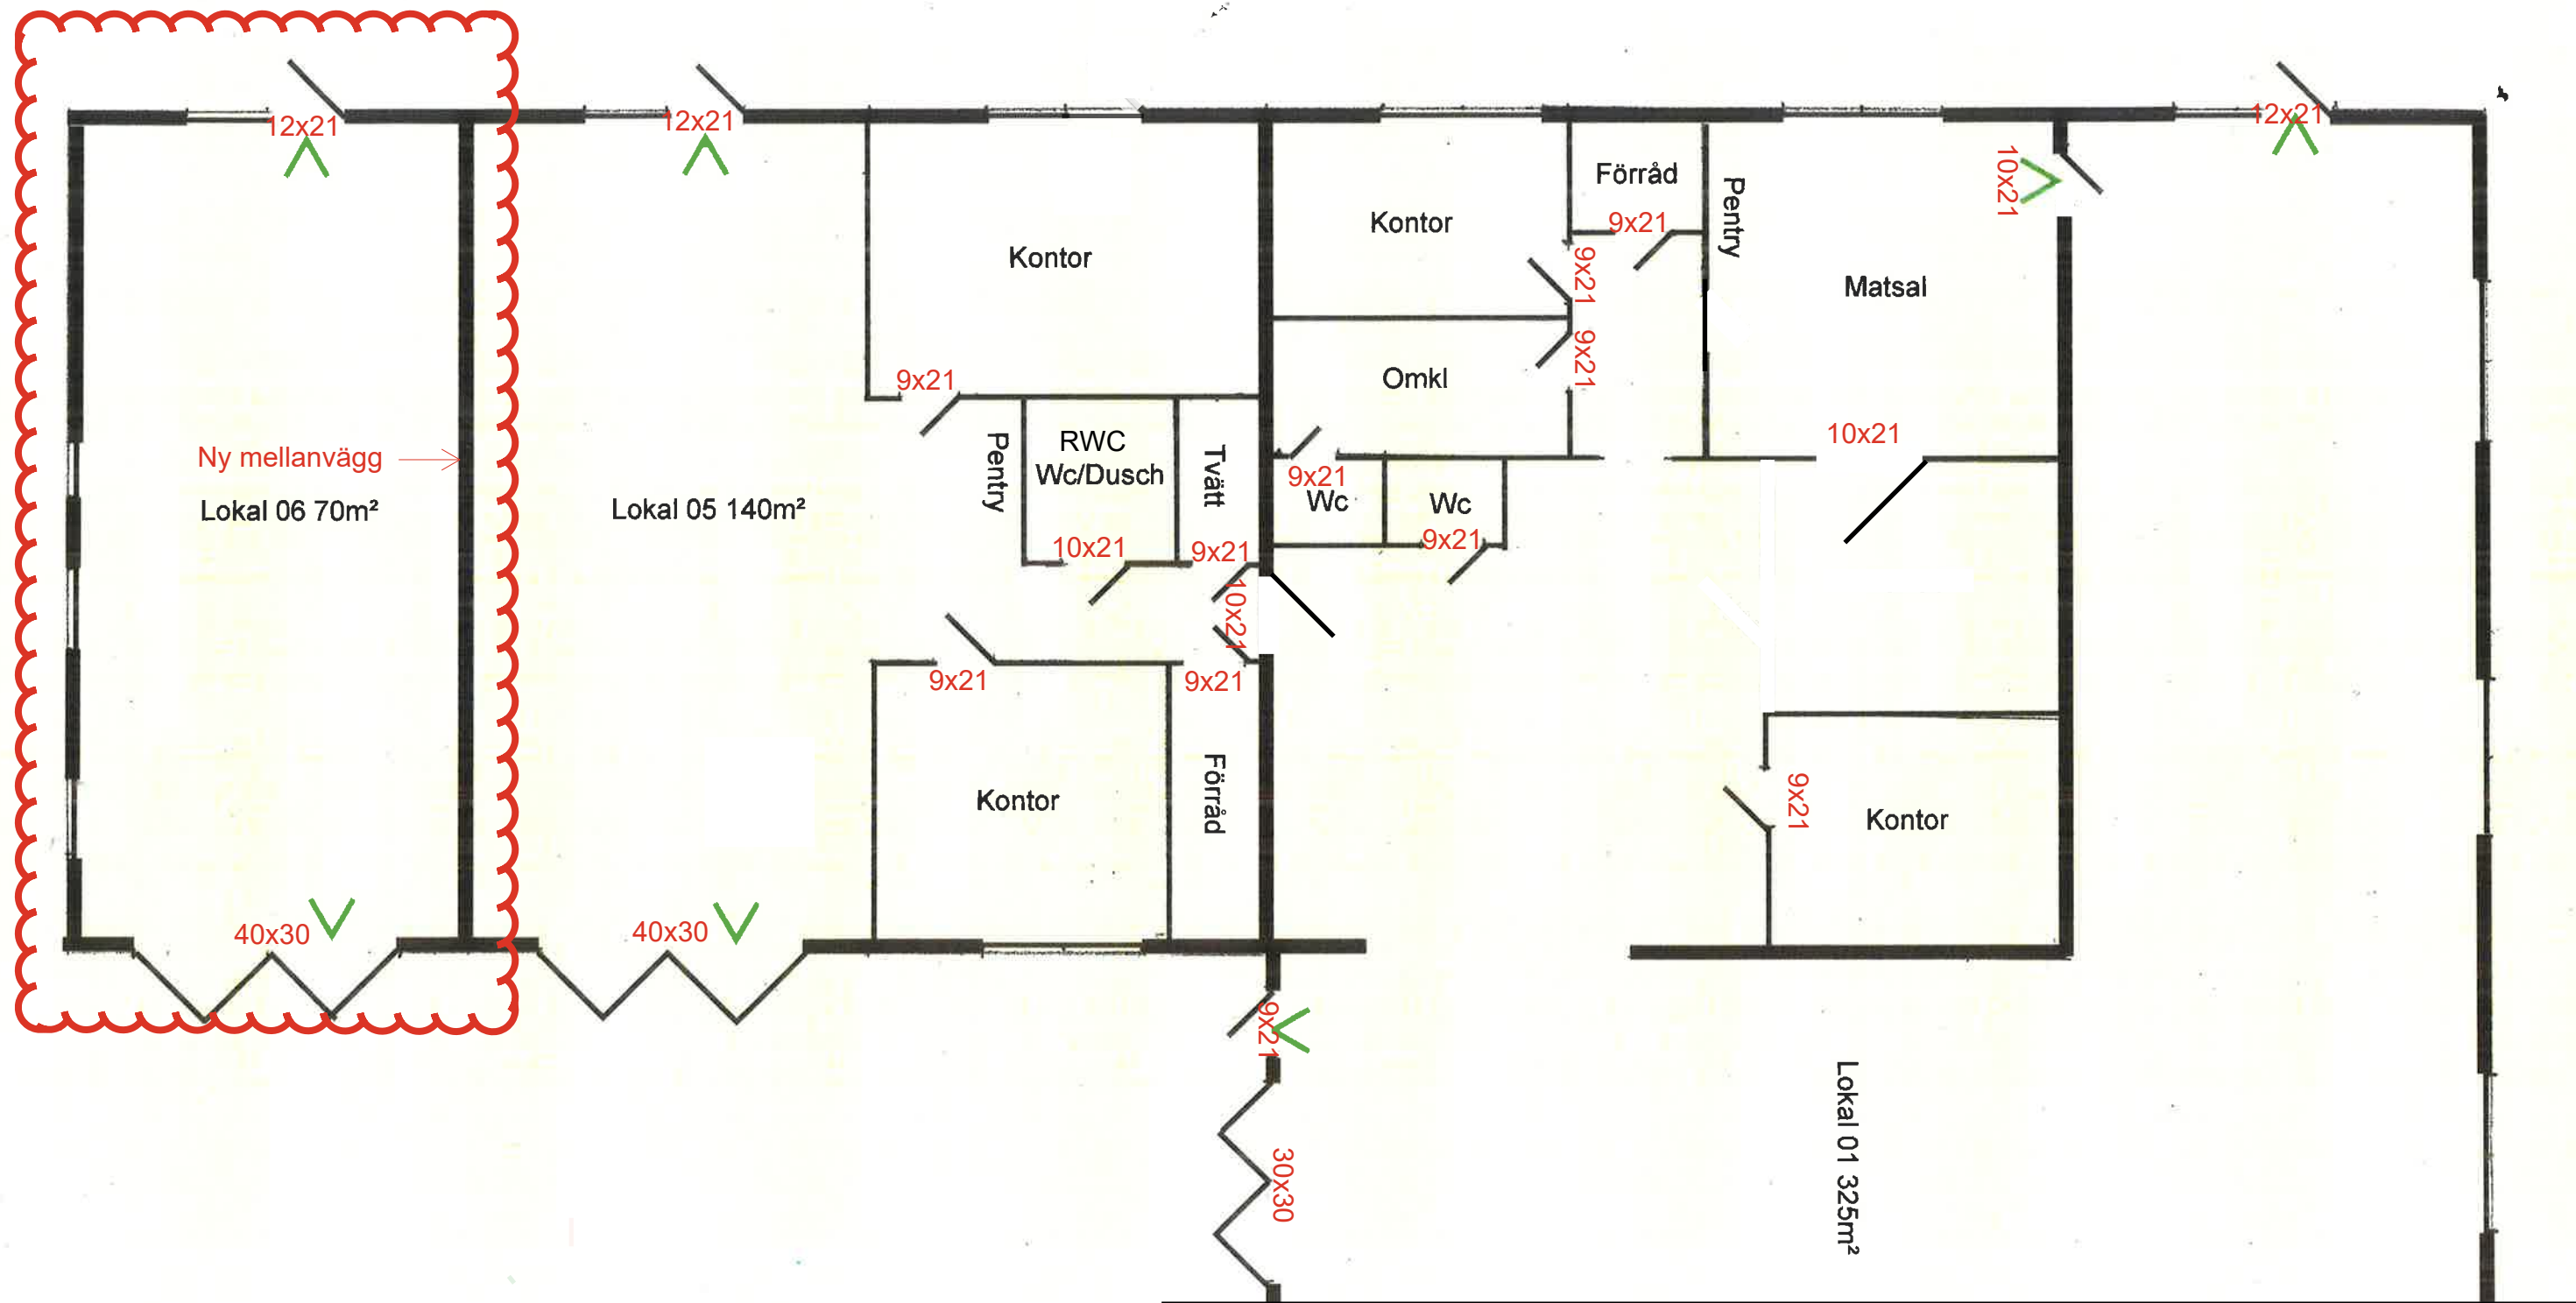

Plan del 1 Generatorn 3 skala 1:100 A

