


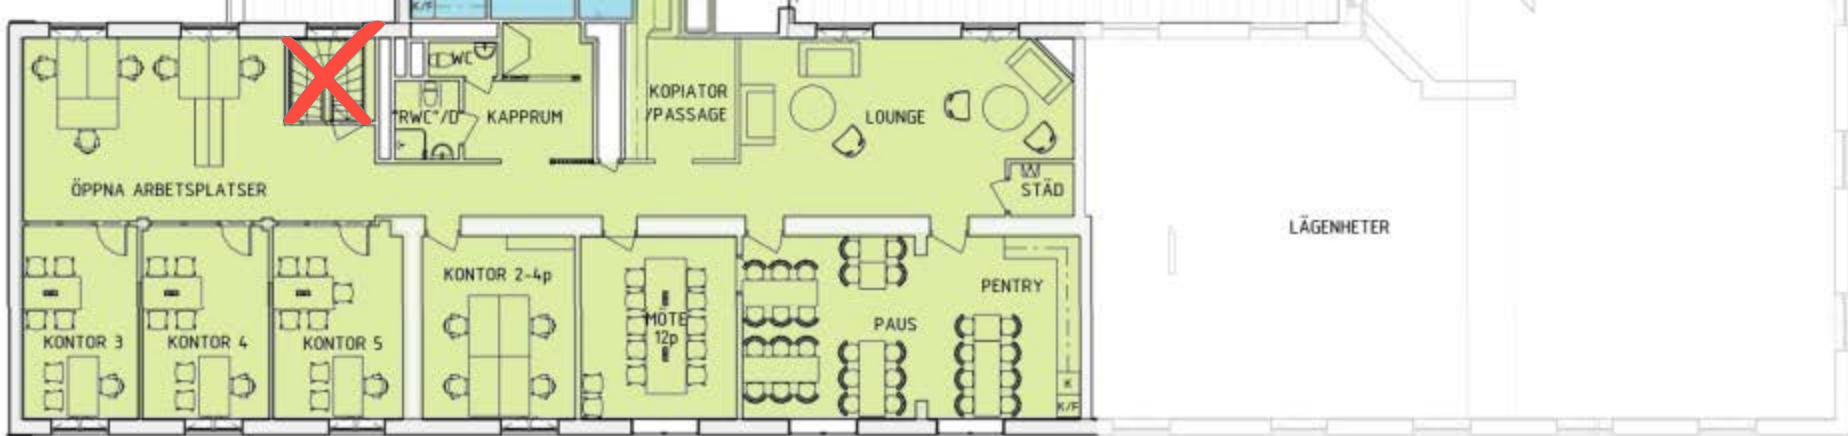

PLAN 2
SKALA 1:200



Bruksarea enl SS 21054
247 kvm