


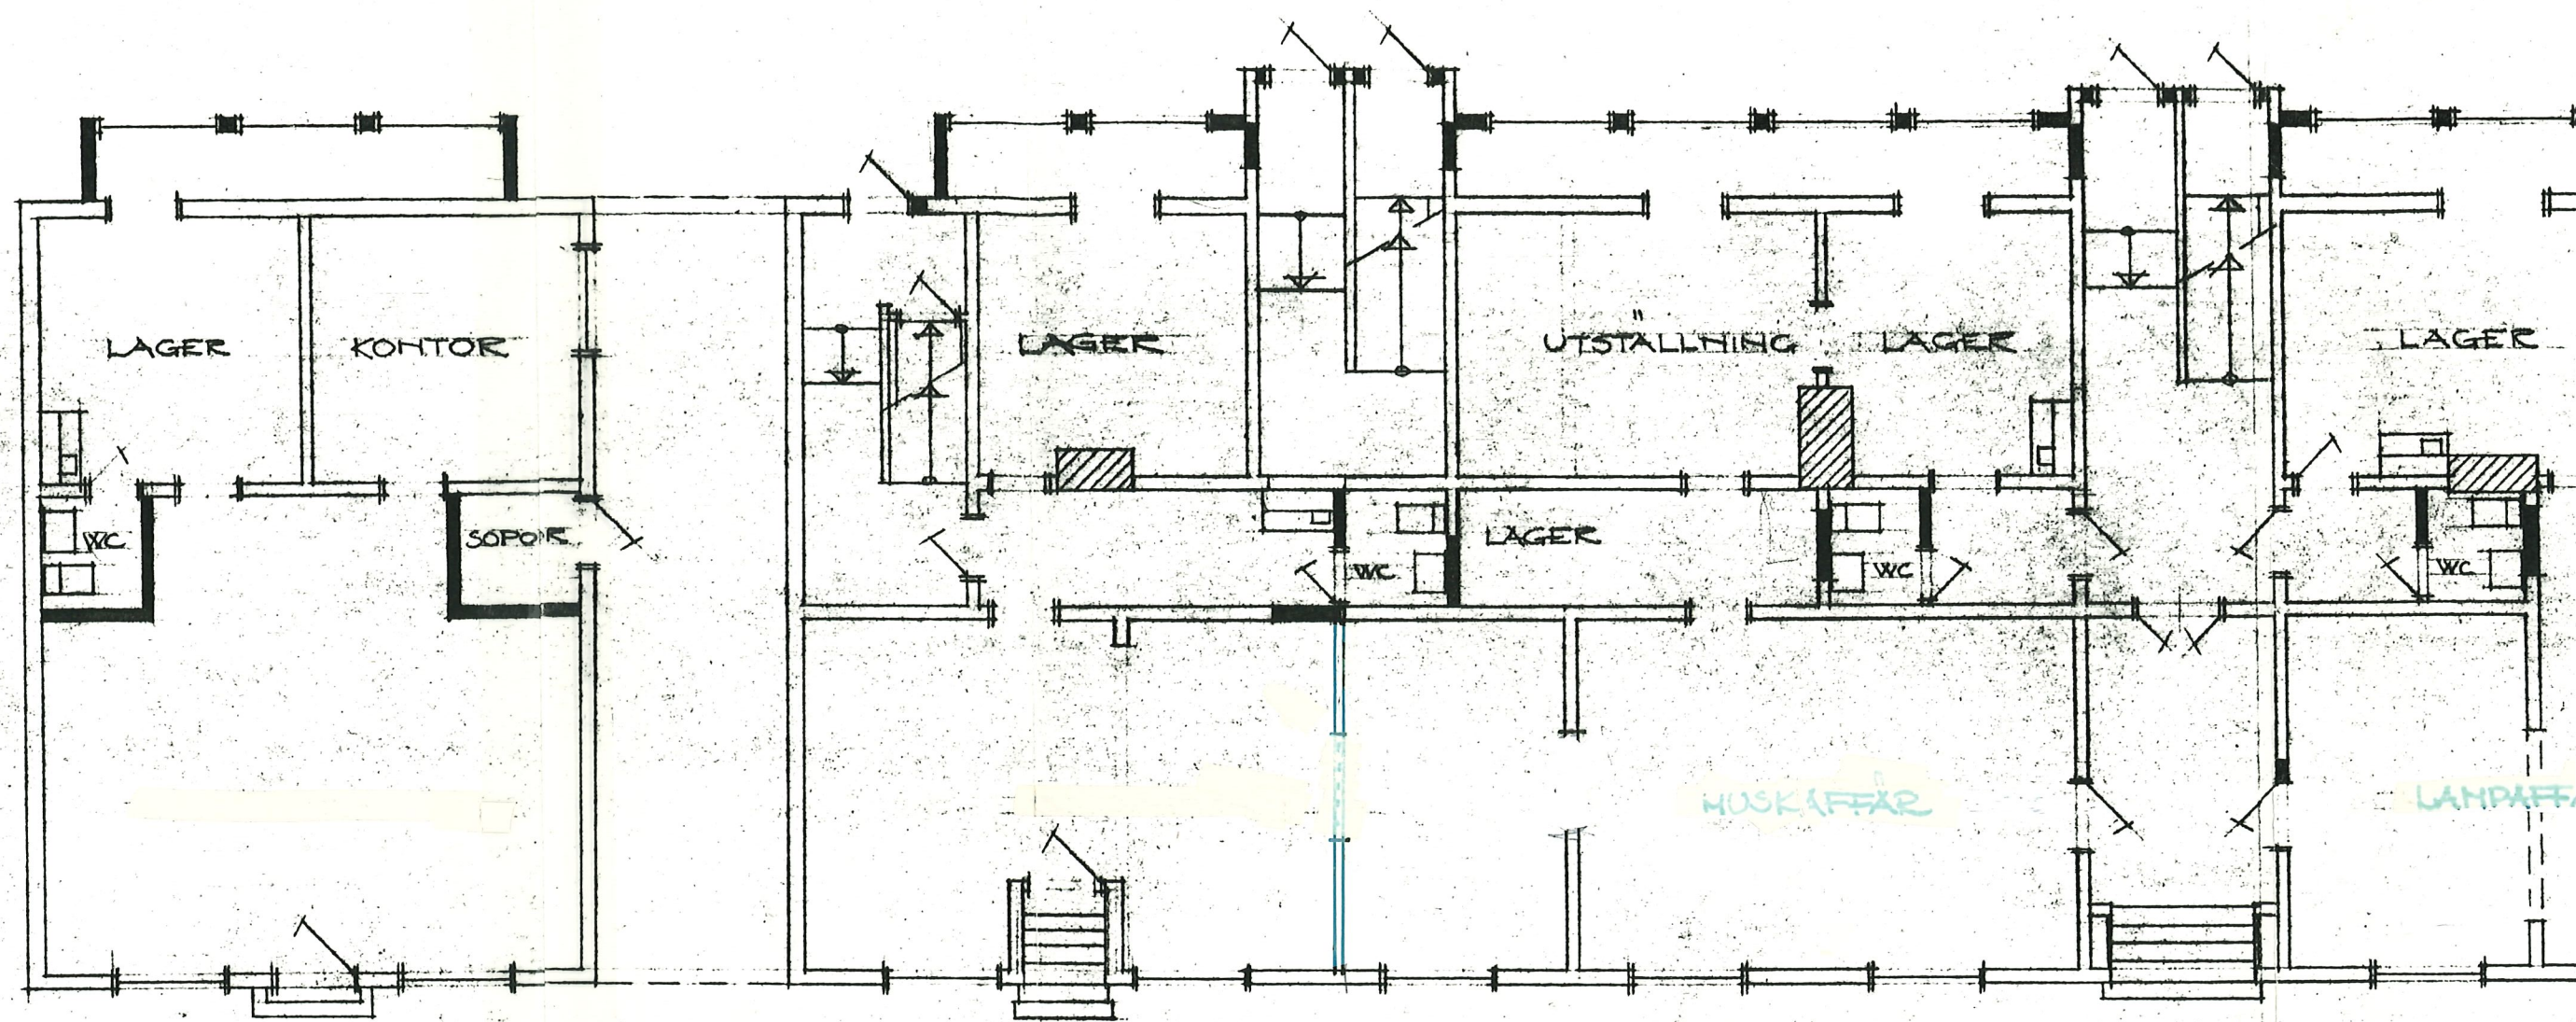

BOTTENVÅNING — 1:100 —

"Musikaffär"
Köpmannen 10
8888087 - 3002