


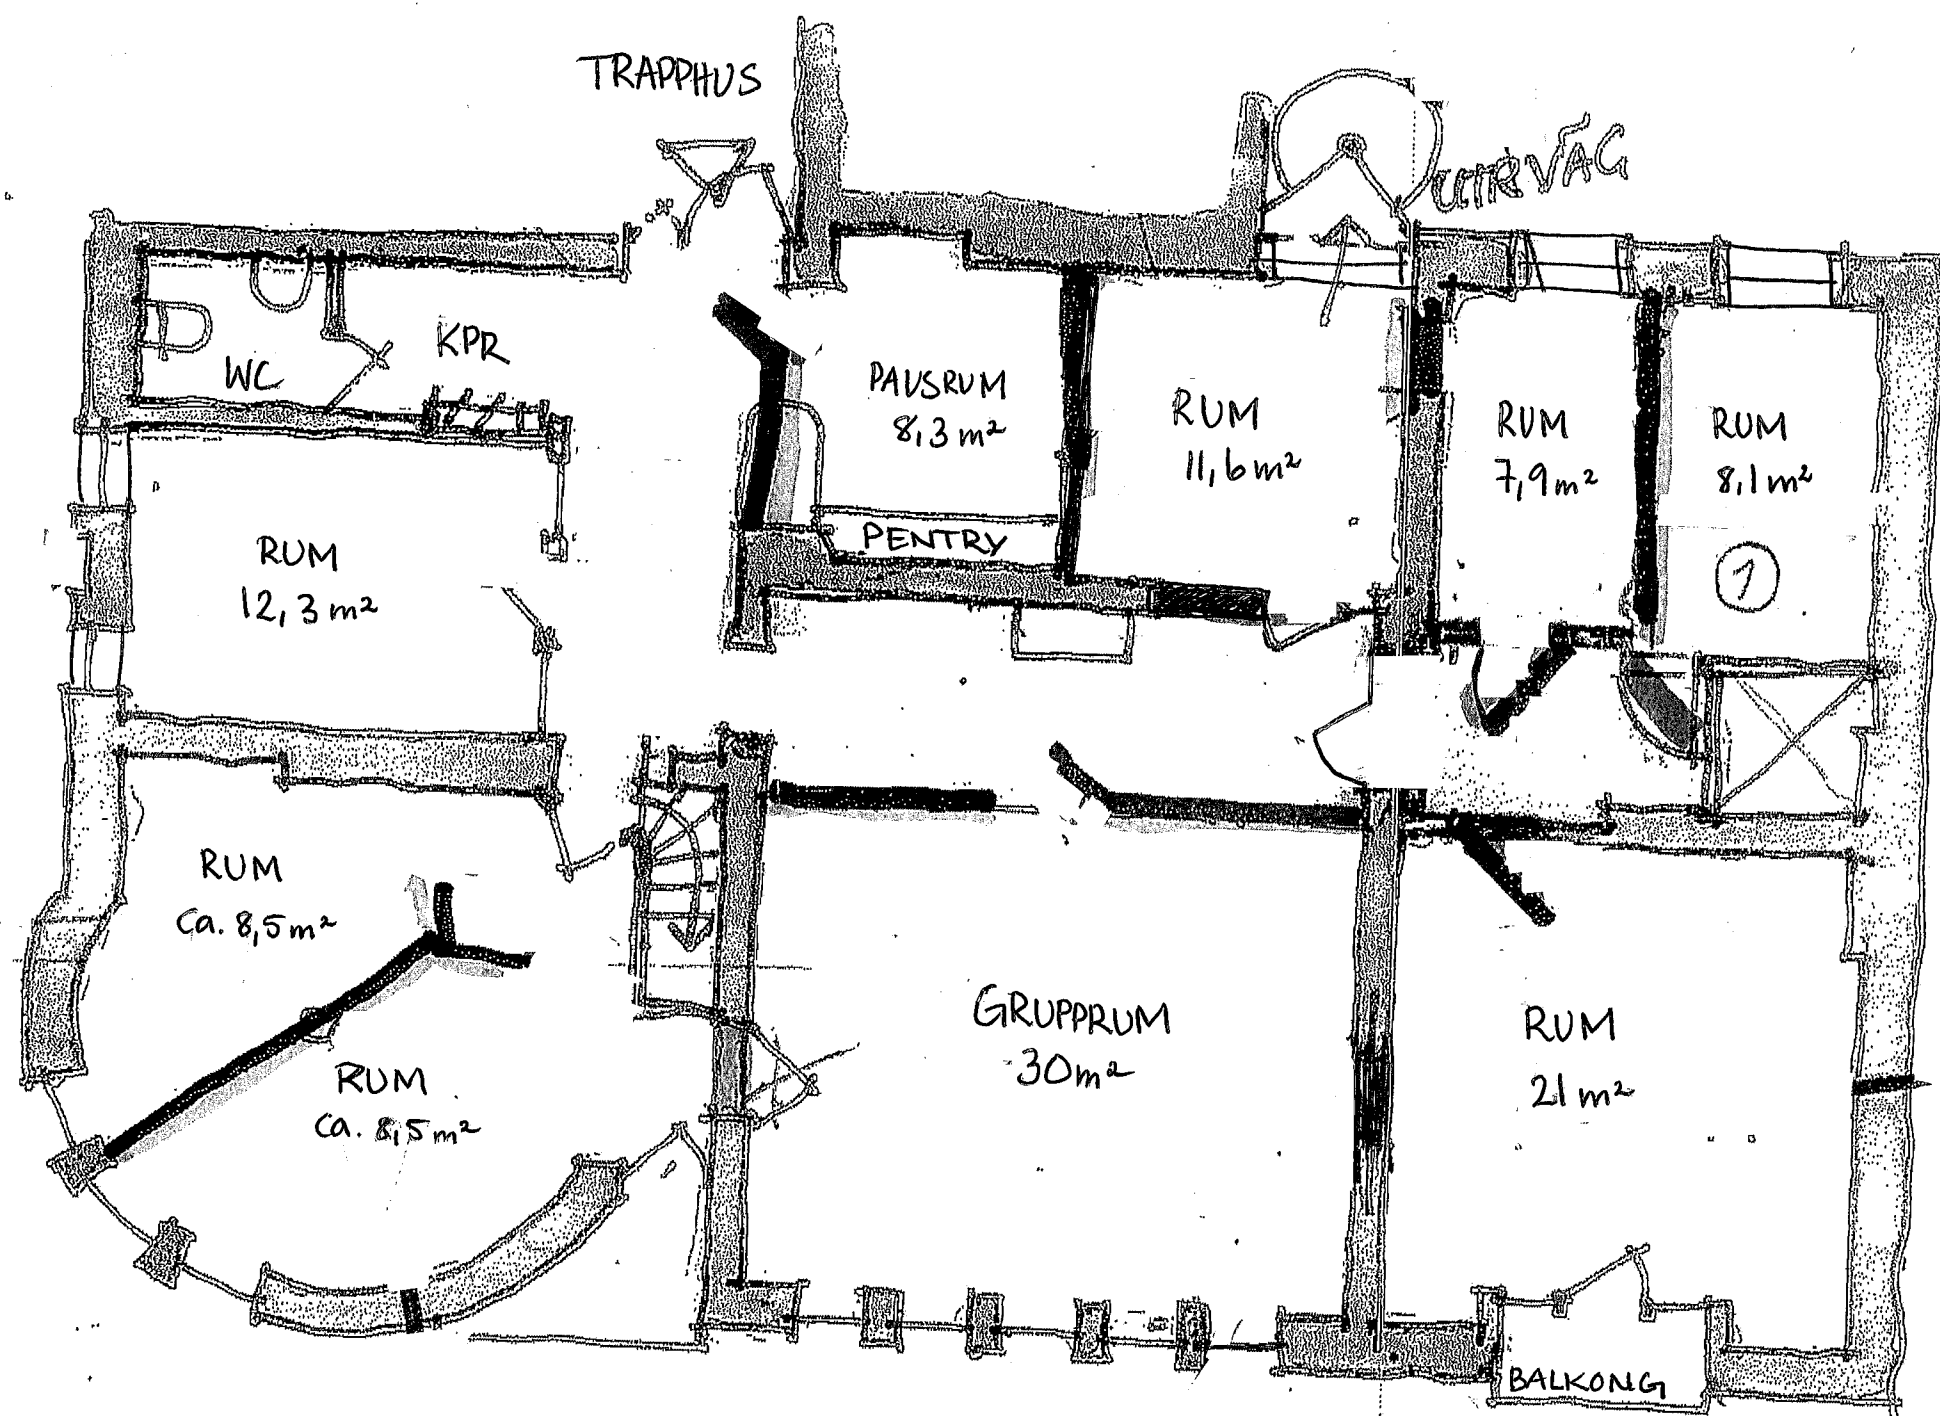

KV. LOKATTEN
PLAN 4, 3TR.

193 m²