



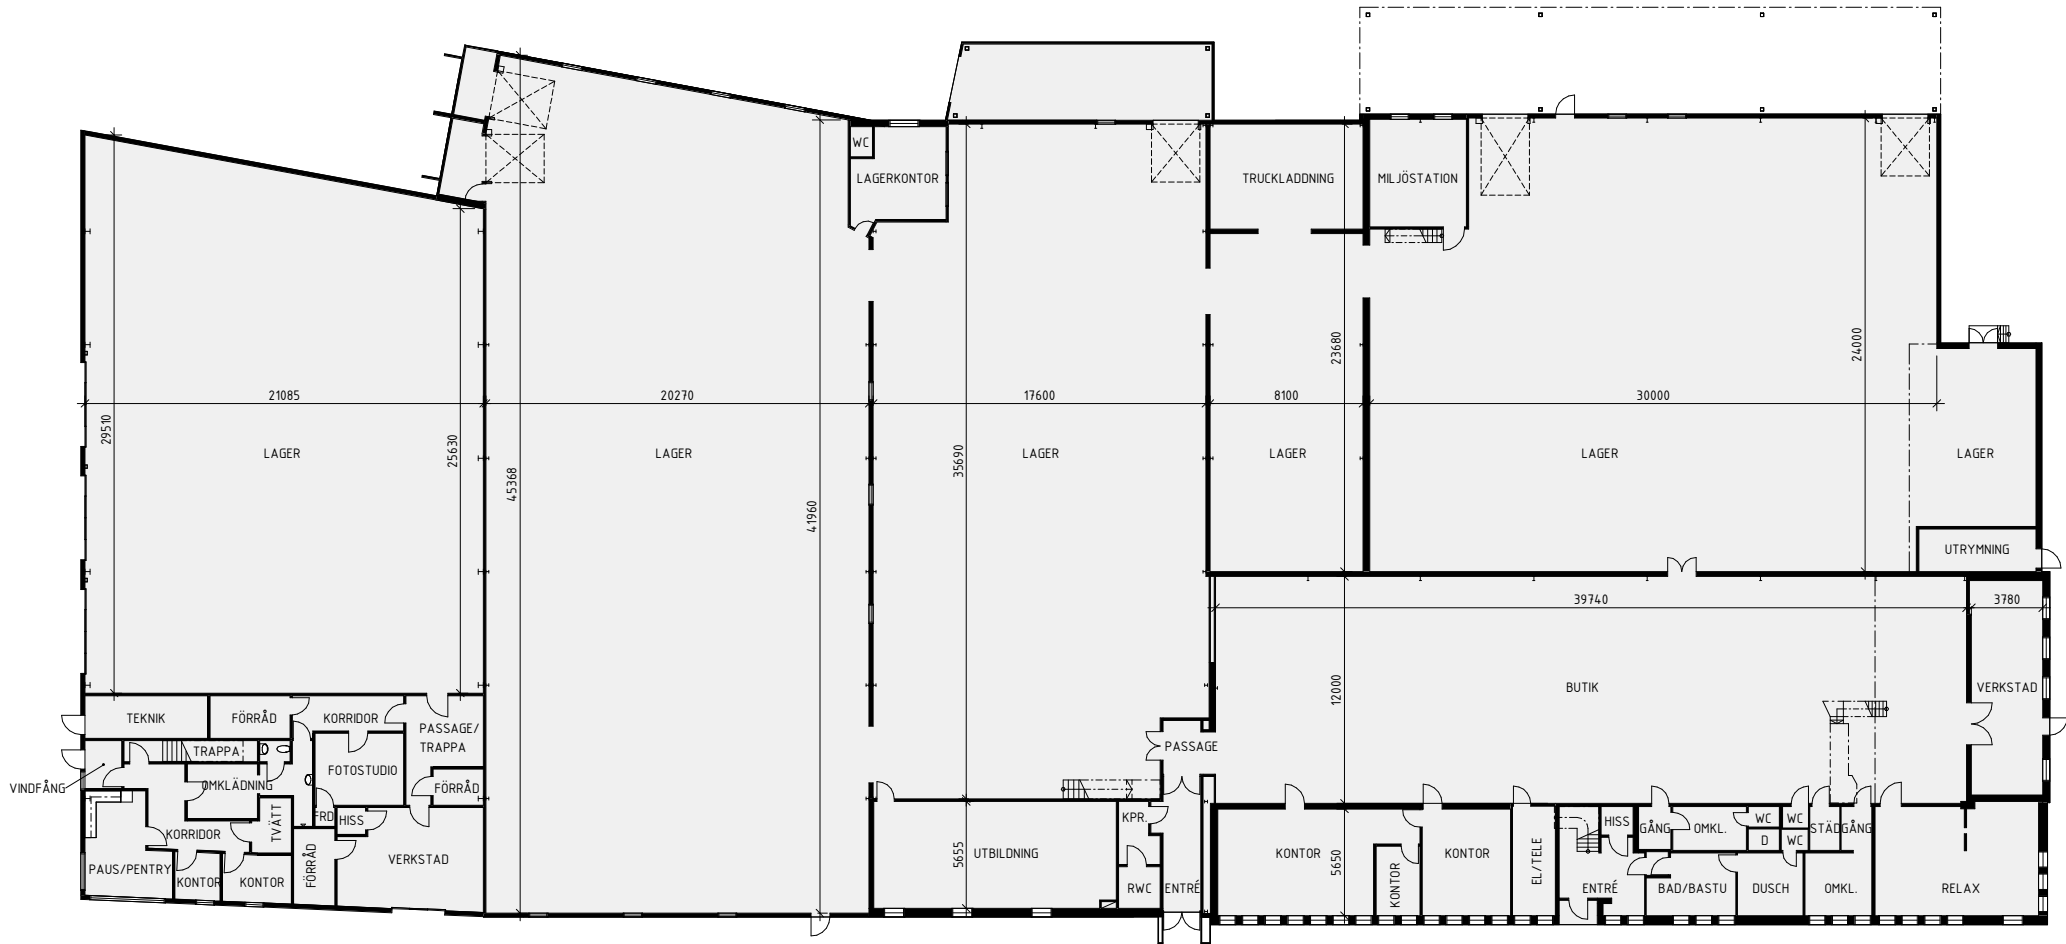


GASLYKTAN 14-15

PLAN 1, ÖVERSIKT

BFINTLIGT UTSEENDE
2025-04-10

A1 1:200
A3 1:400

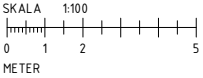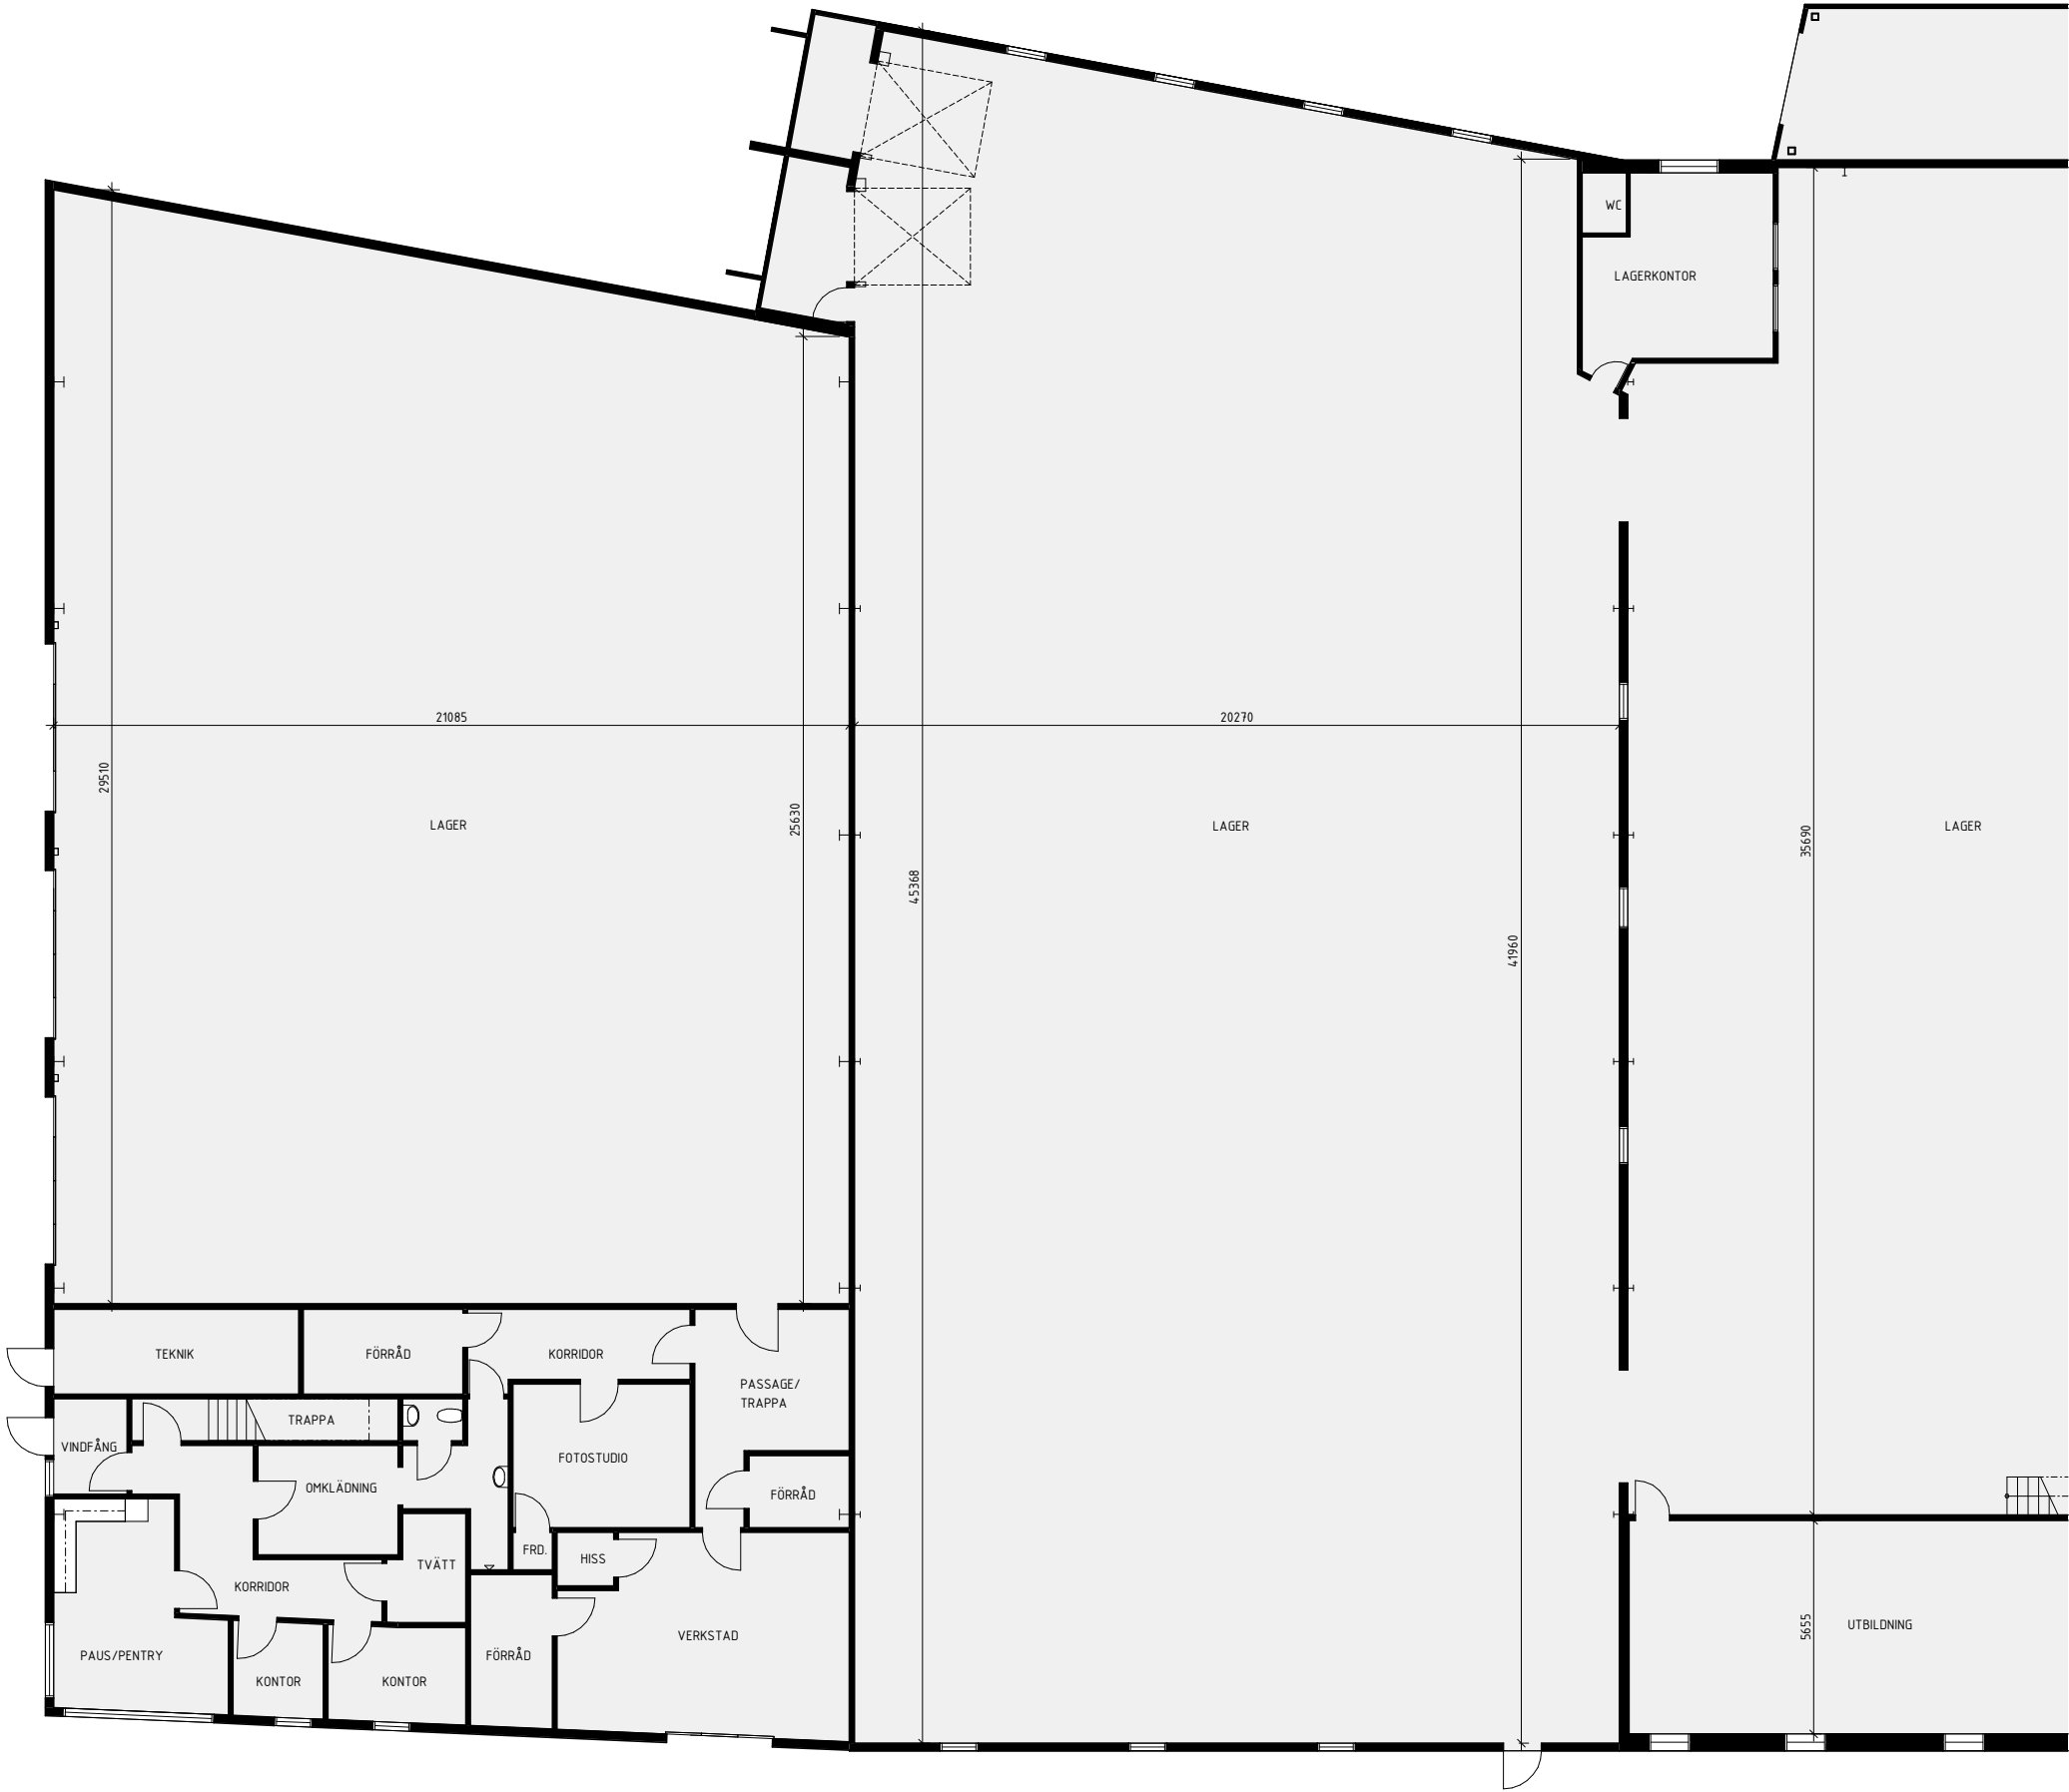


GASLYKTAN 14-15

PLAN 1, DEL 1

BFINTLIGT UTSEENDE
2025-04-10

A1 1:100
A3 1:200


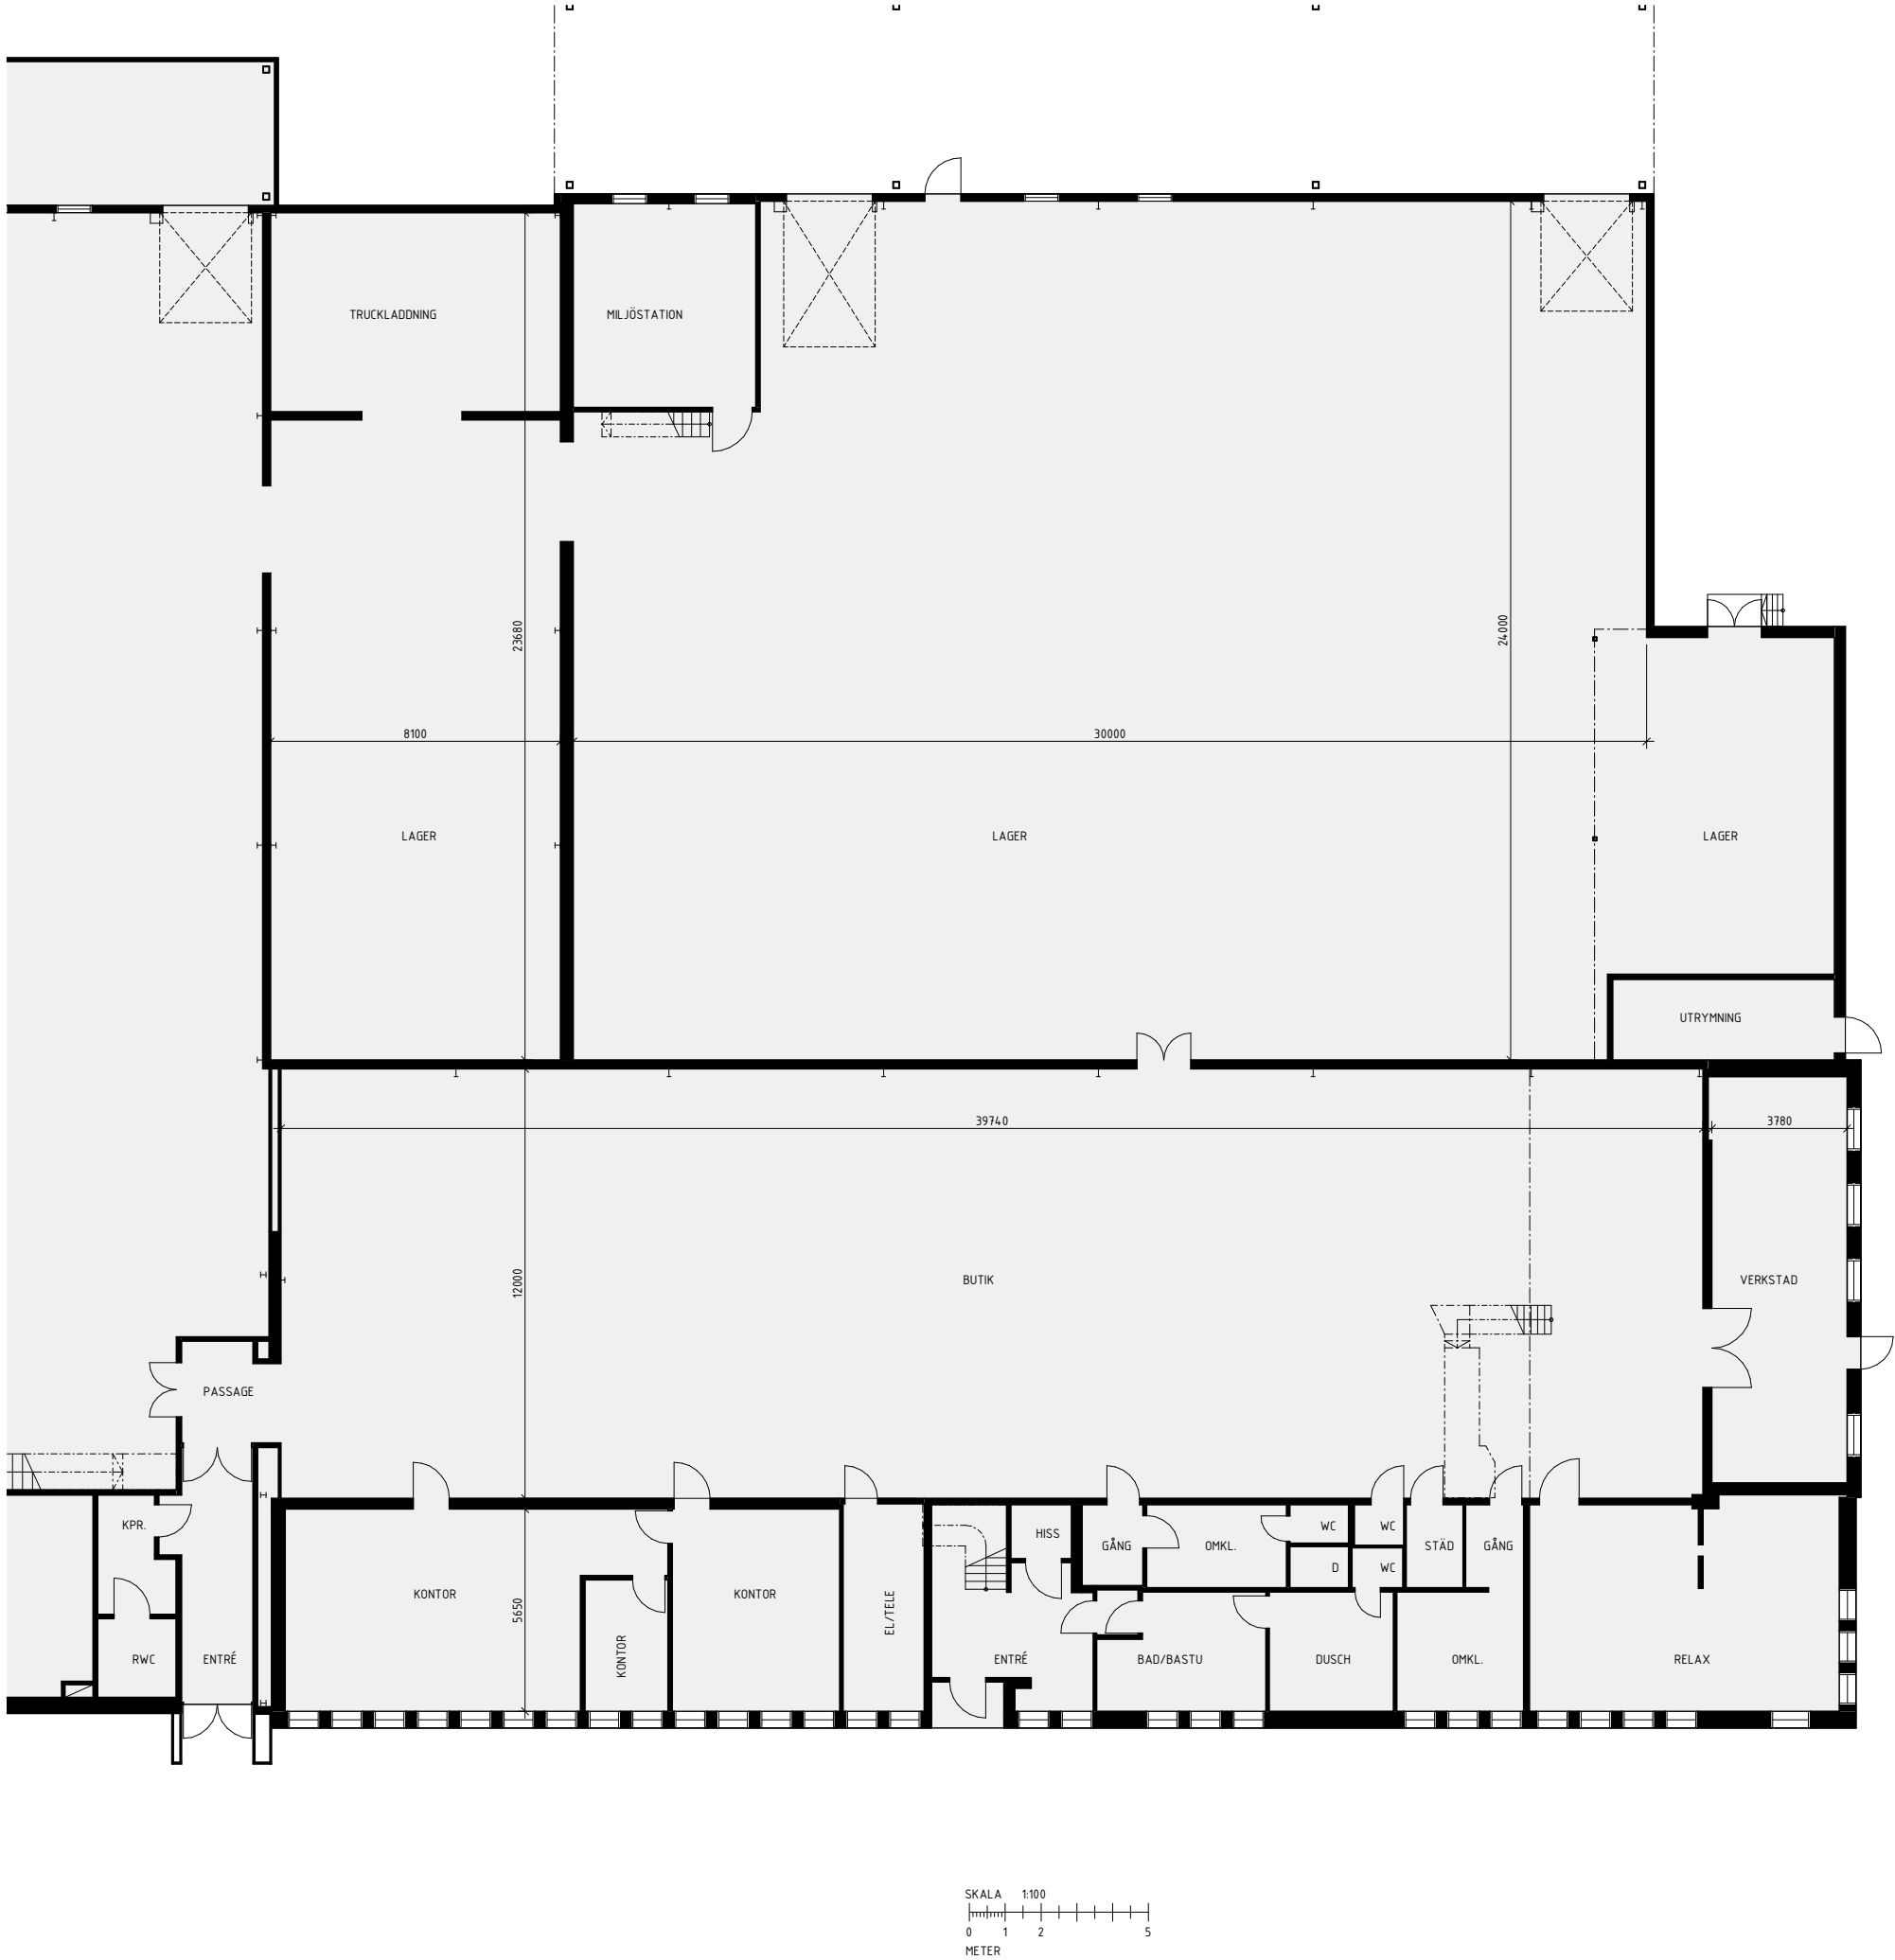


GASLYKTAN 14-15

PLAN 1, DEL 2

BFINTLIGT UTSEENDE
2025-04-10

A1 1:100
A3 1:200

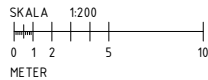
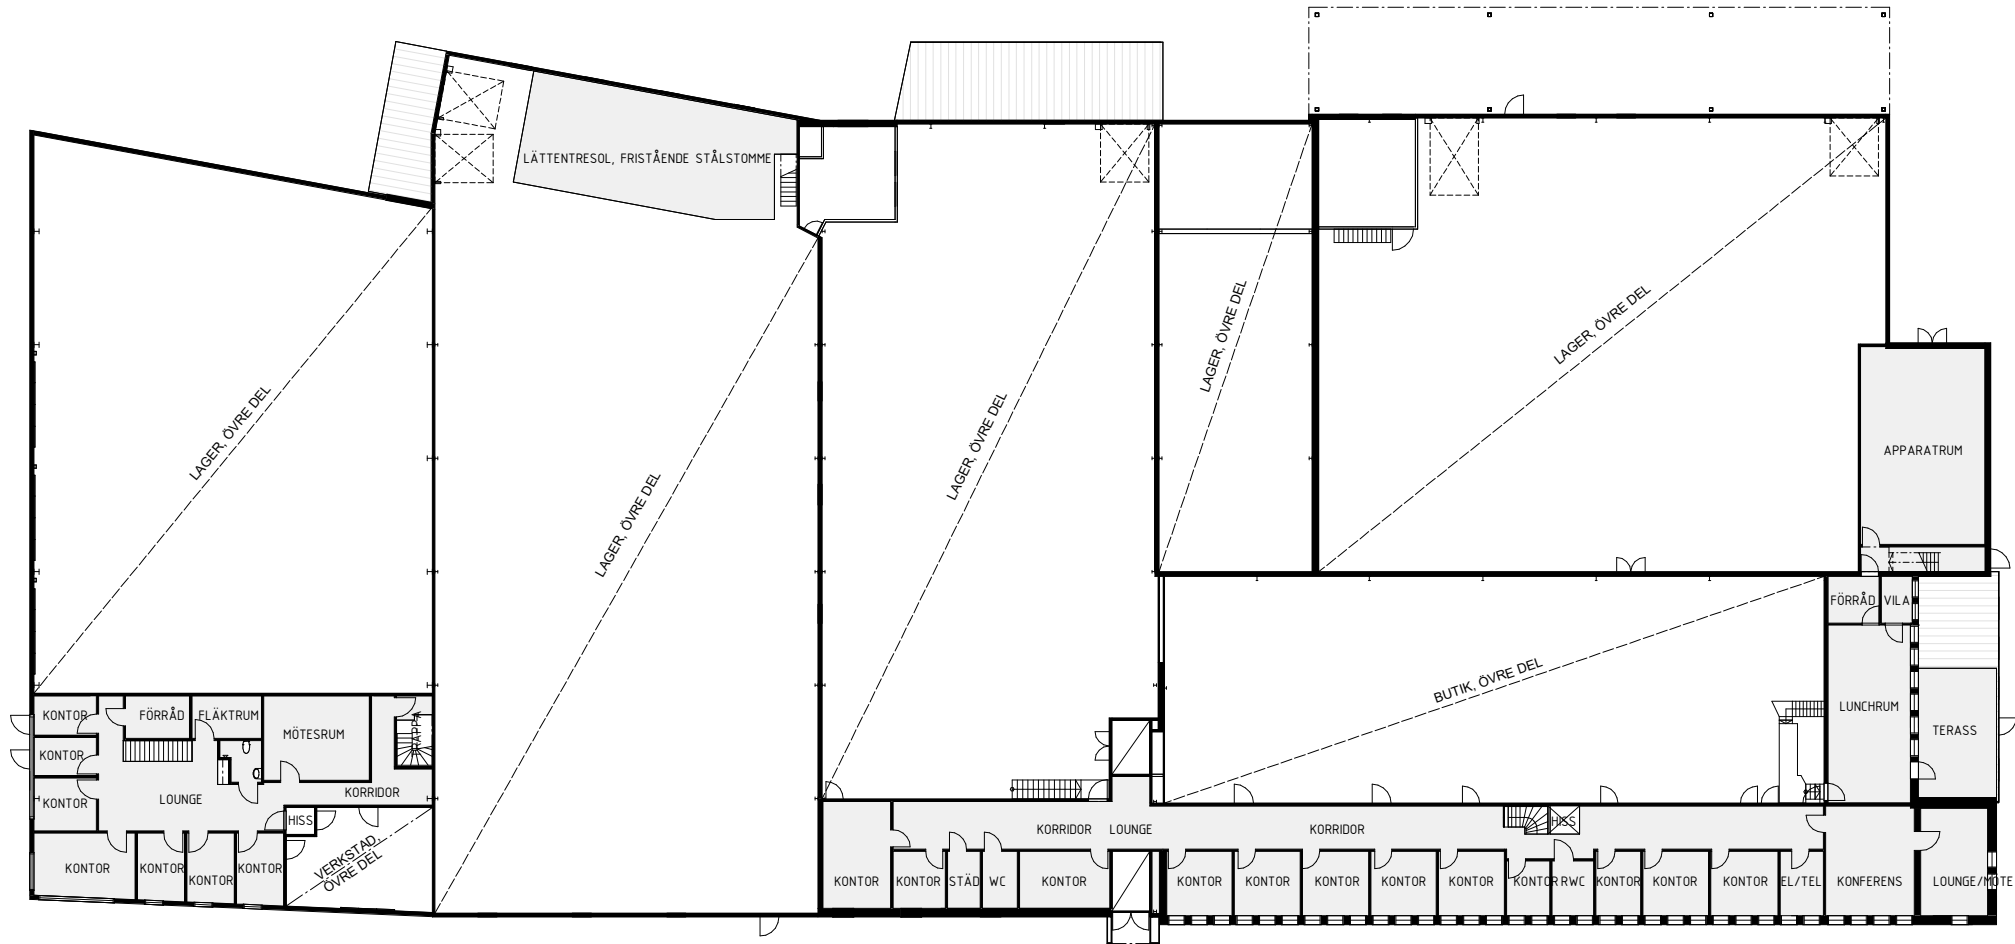


GASLYKTAN 14-15

PLAN 2, ÖVERSIKT



BFINTLIGT UTSEENDE
2025-04-10

A1 1:200
A3 1:400

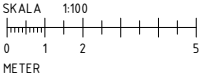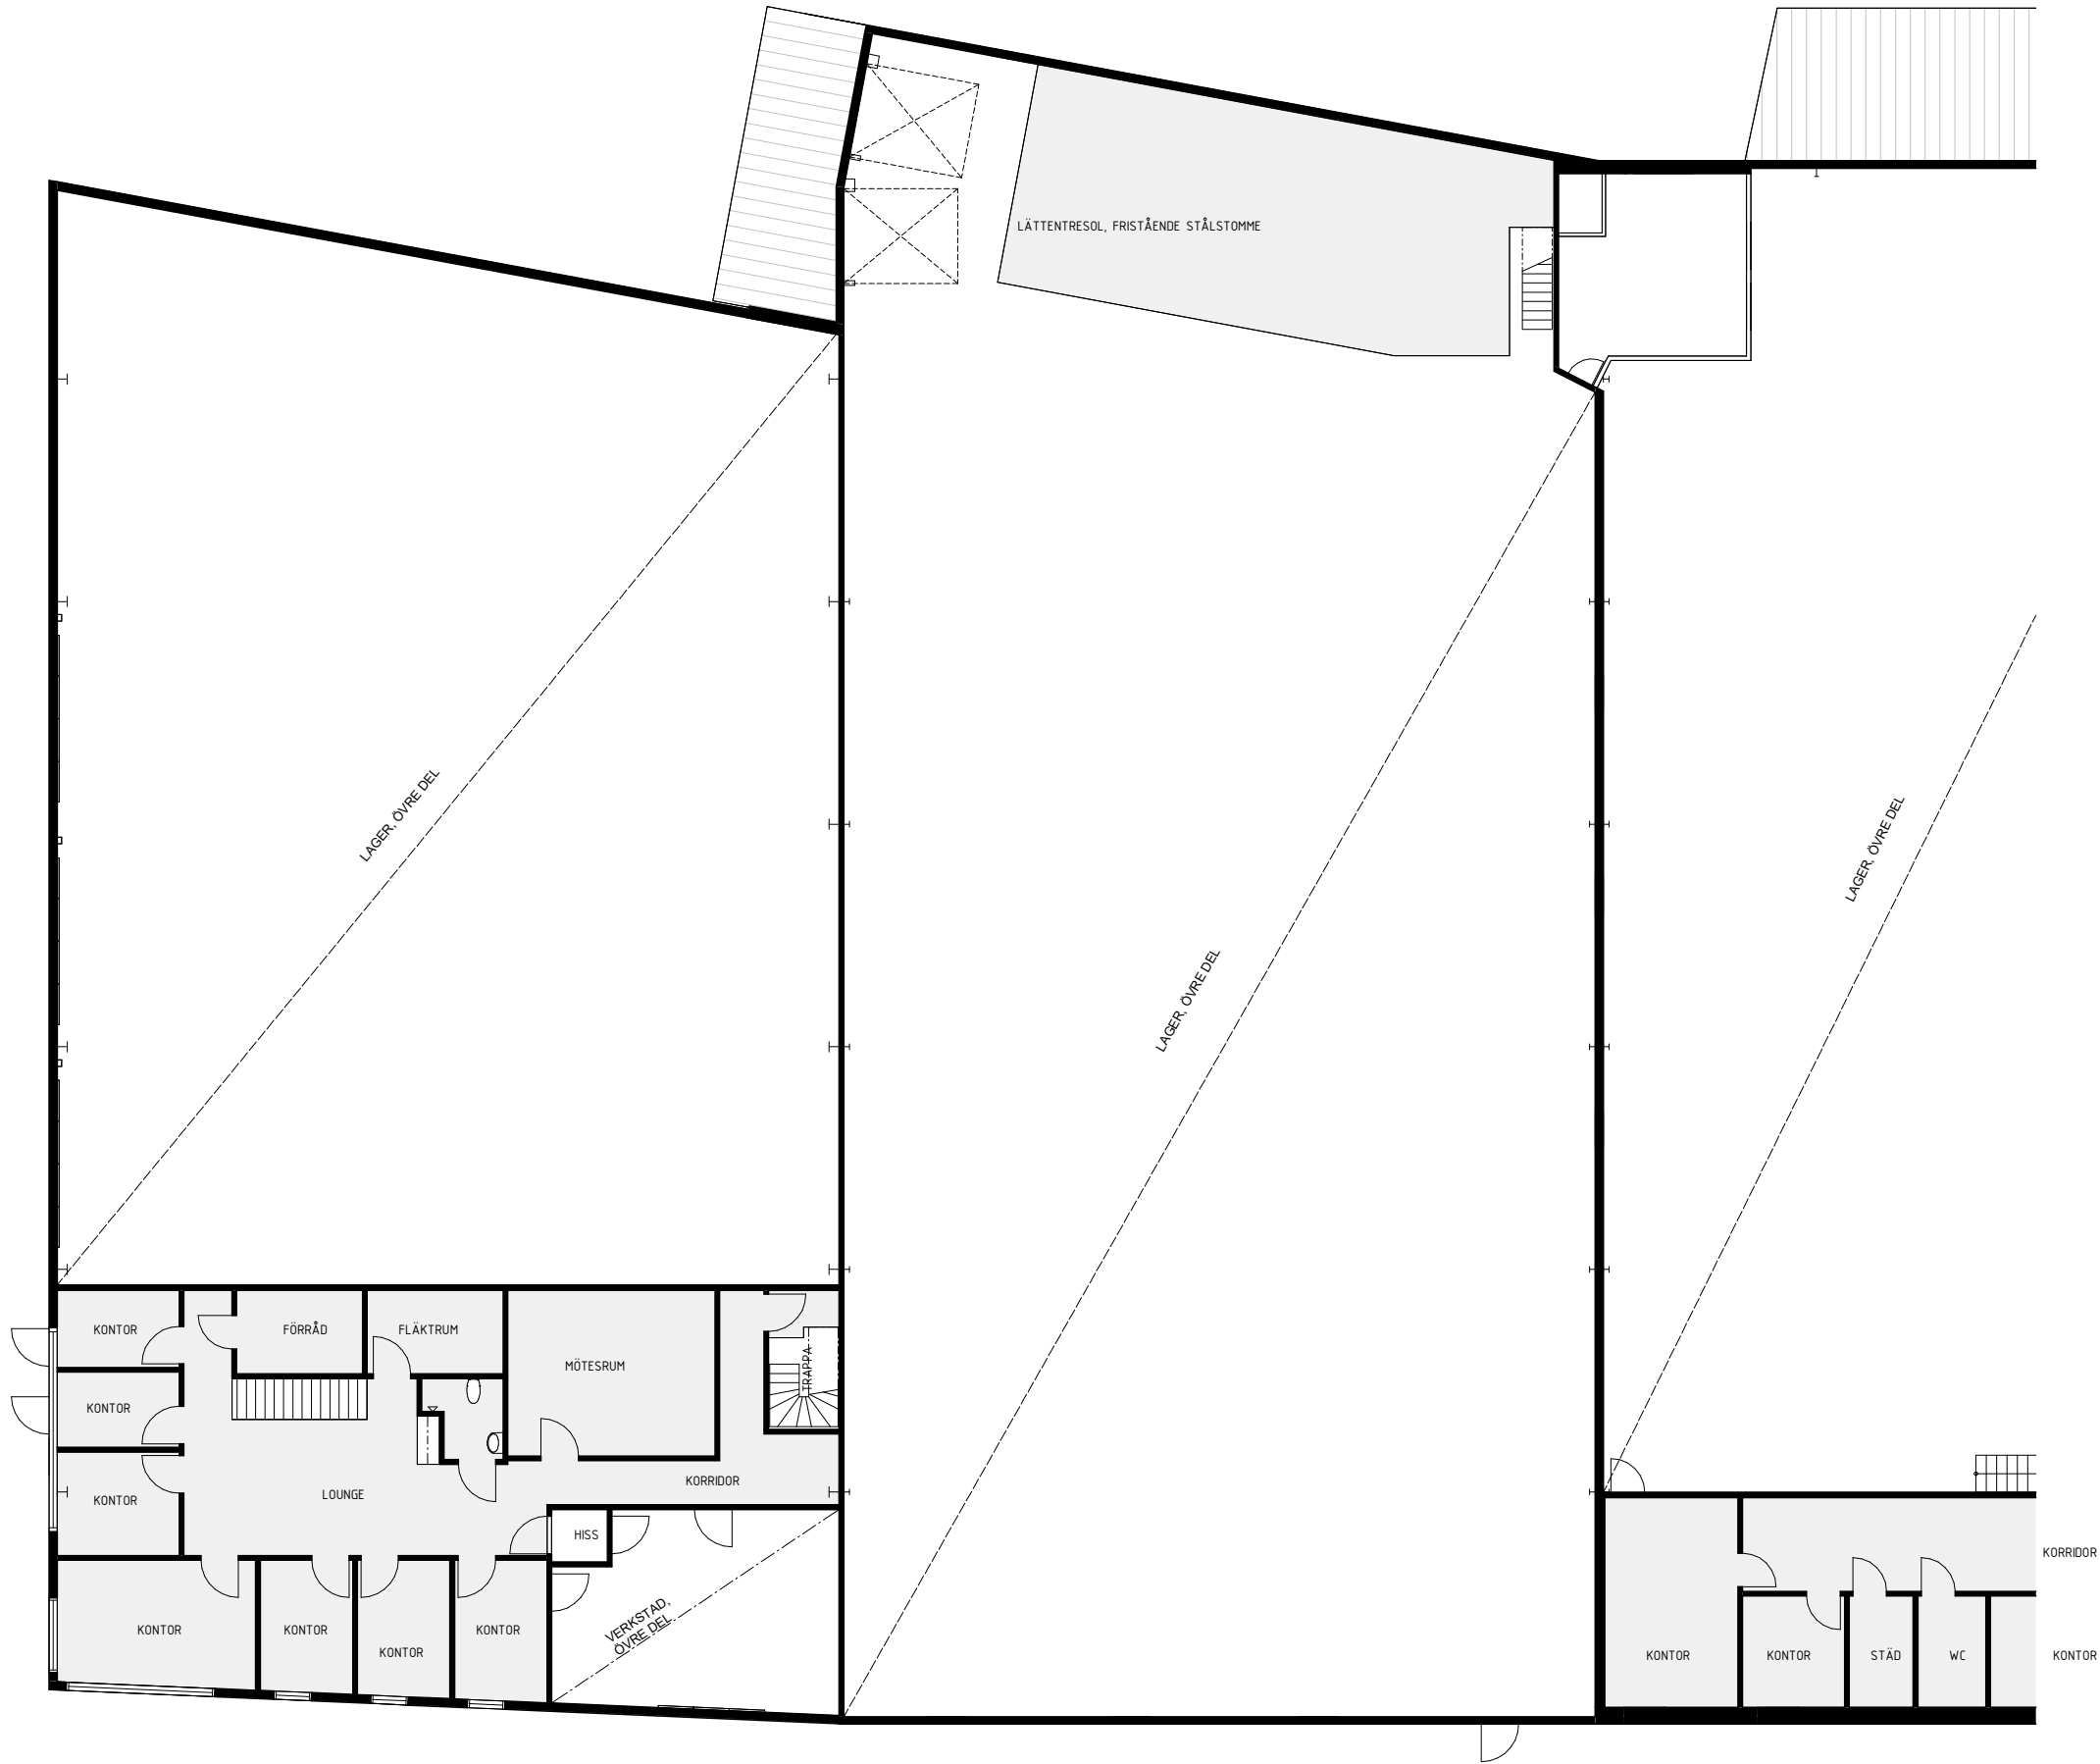

GASLYKTAN 14-15

PLAN 2, DEL 1
BFINTLIGT UTSEENDE
2025-04-10
A1 1:100
A3 1:200

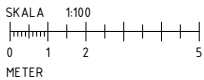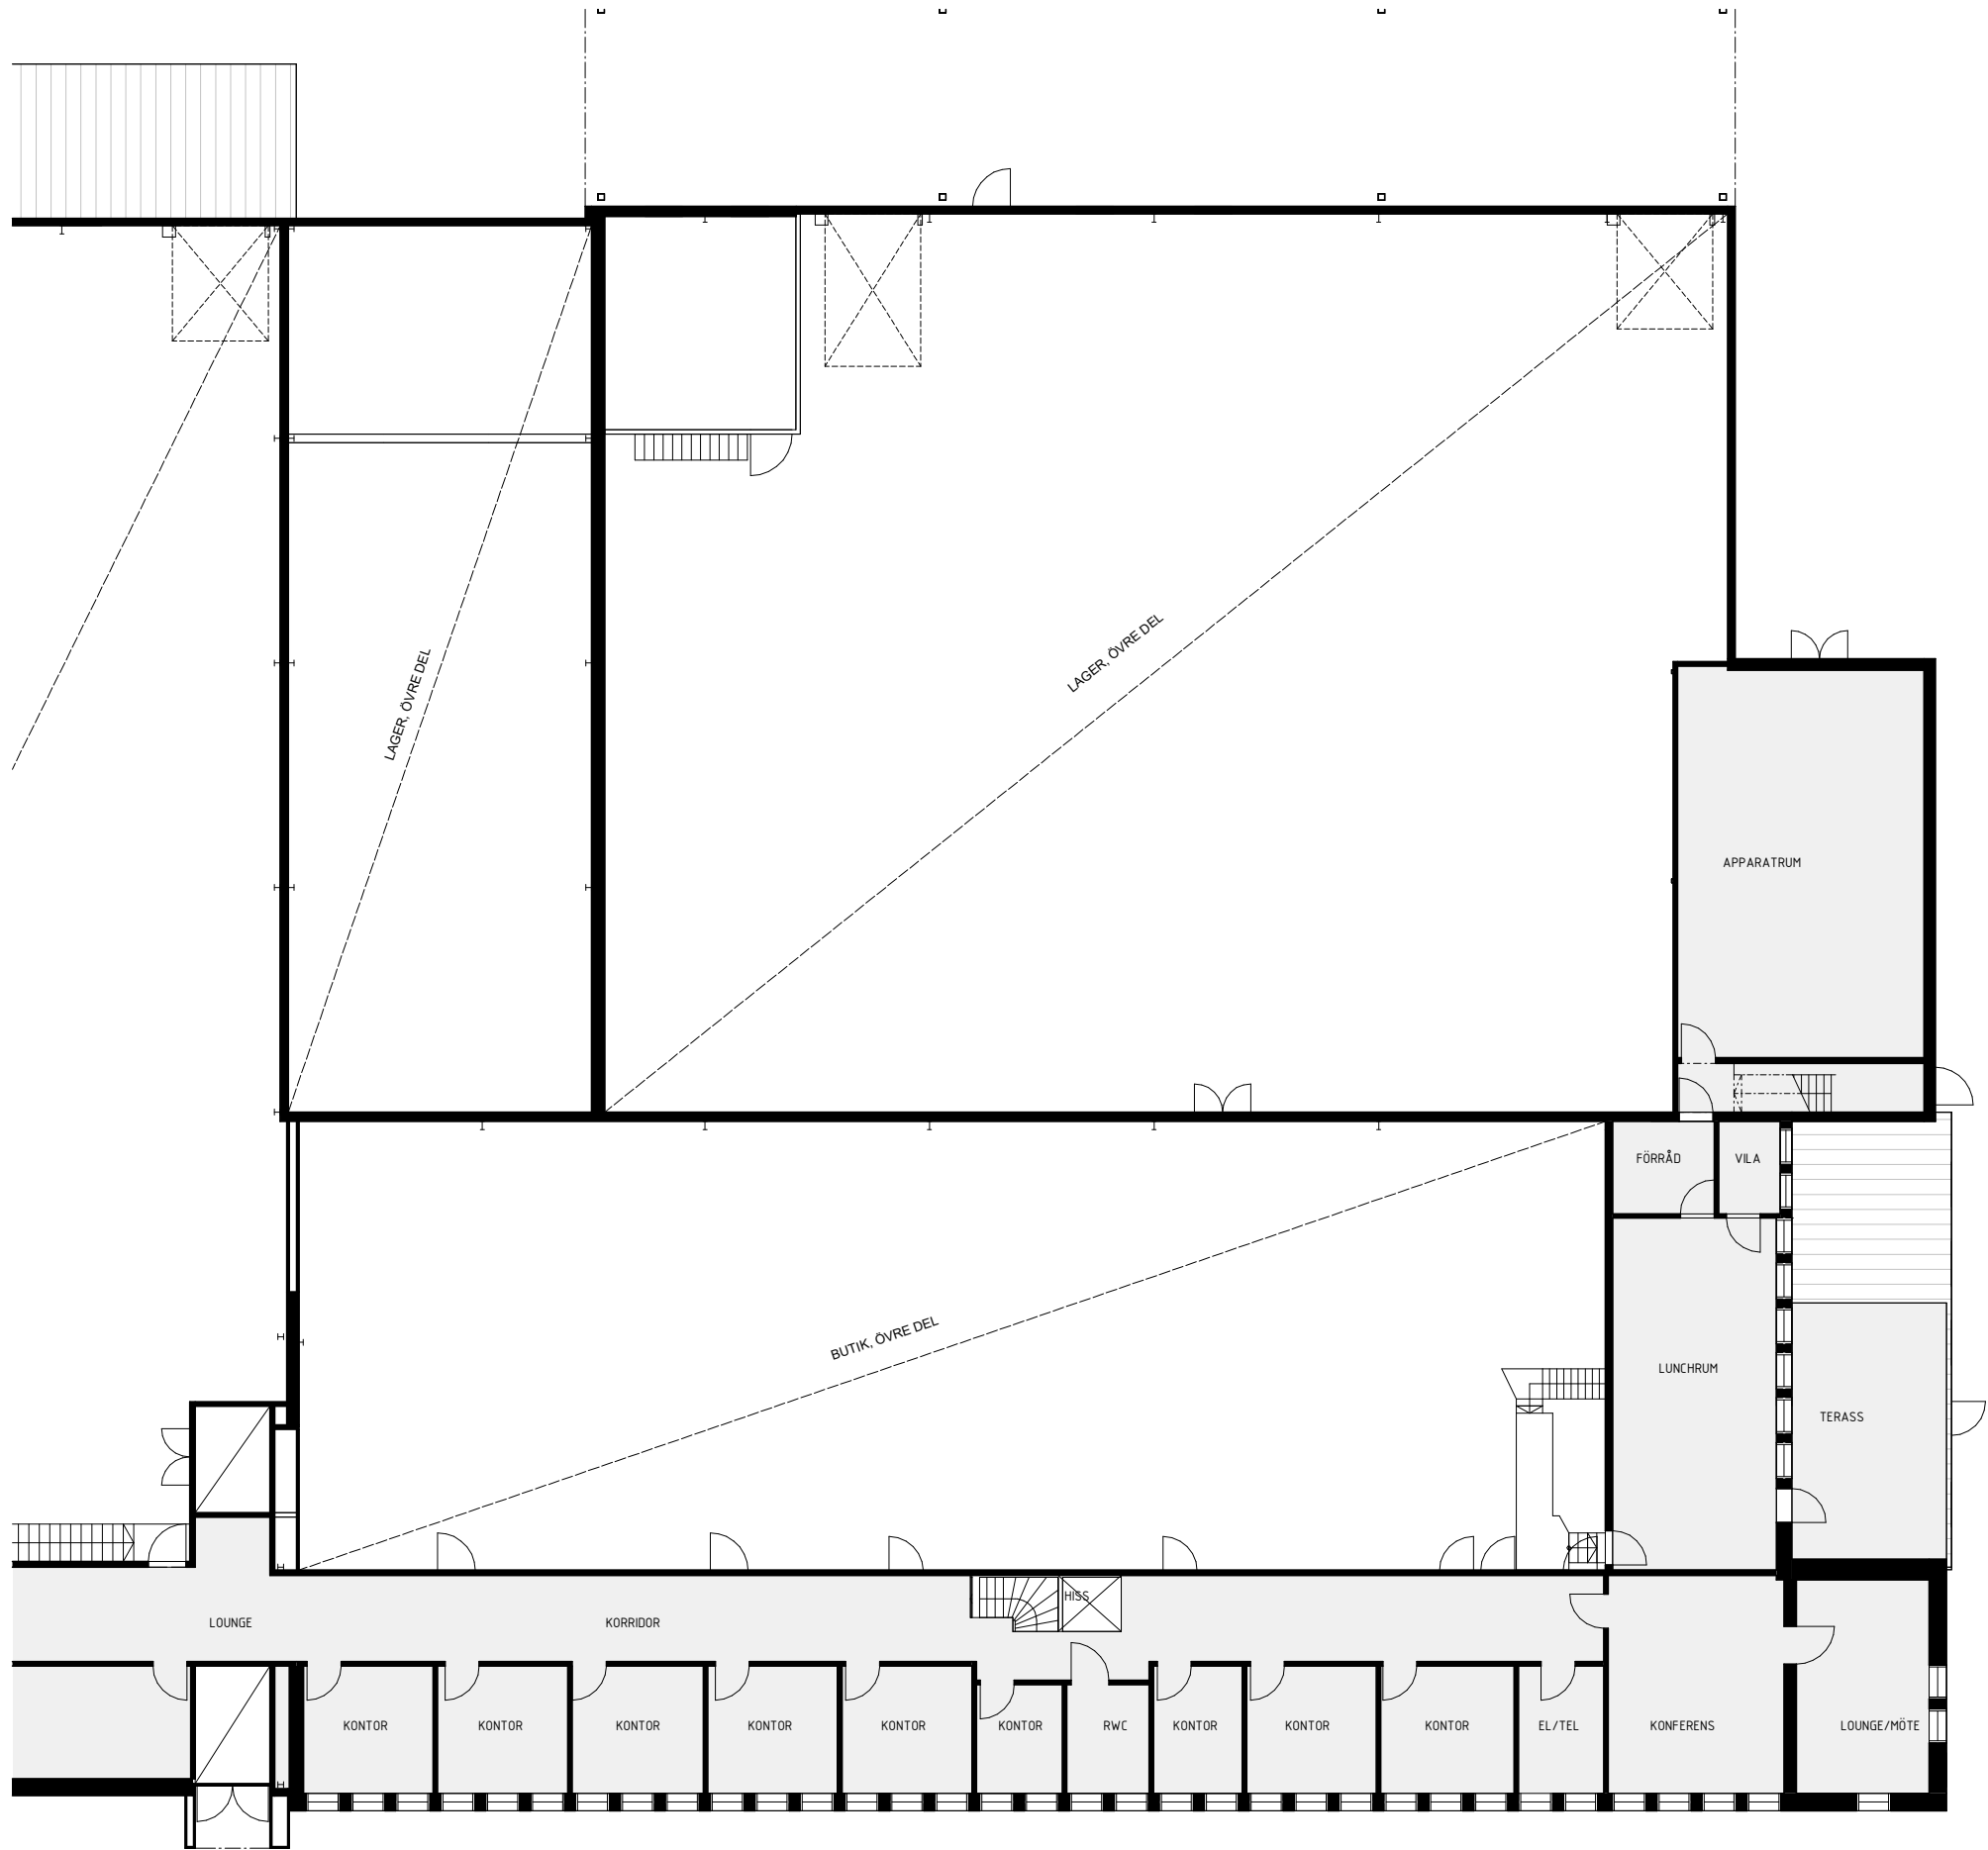

GASLYKTAN 14-15

PLAN 2, DEL 2

BFINTLIGT UTSEENDE
2025-04-10

A1 1:100

A3 1:200