


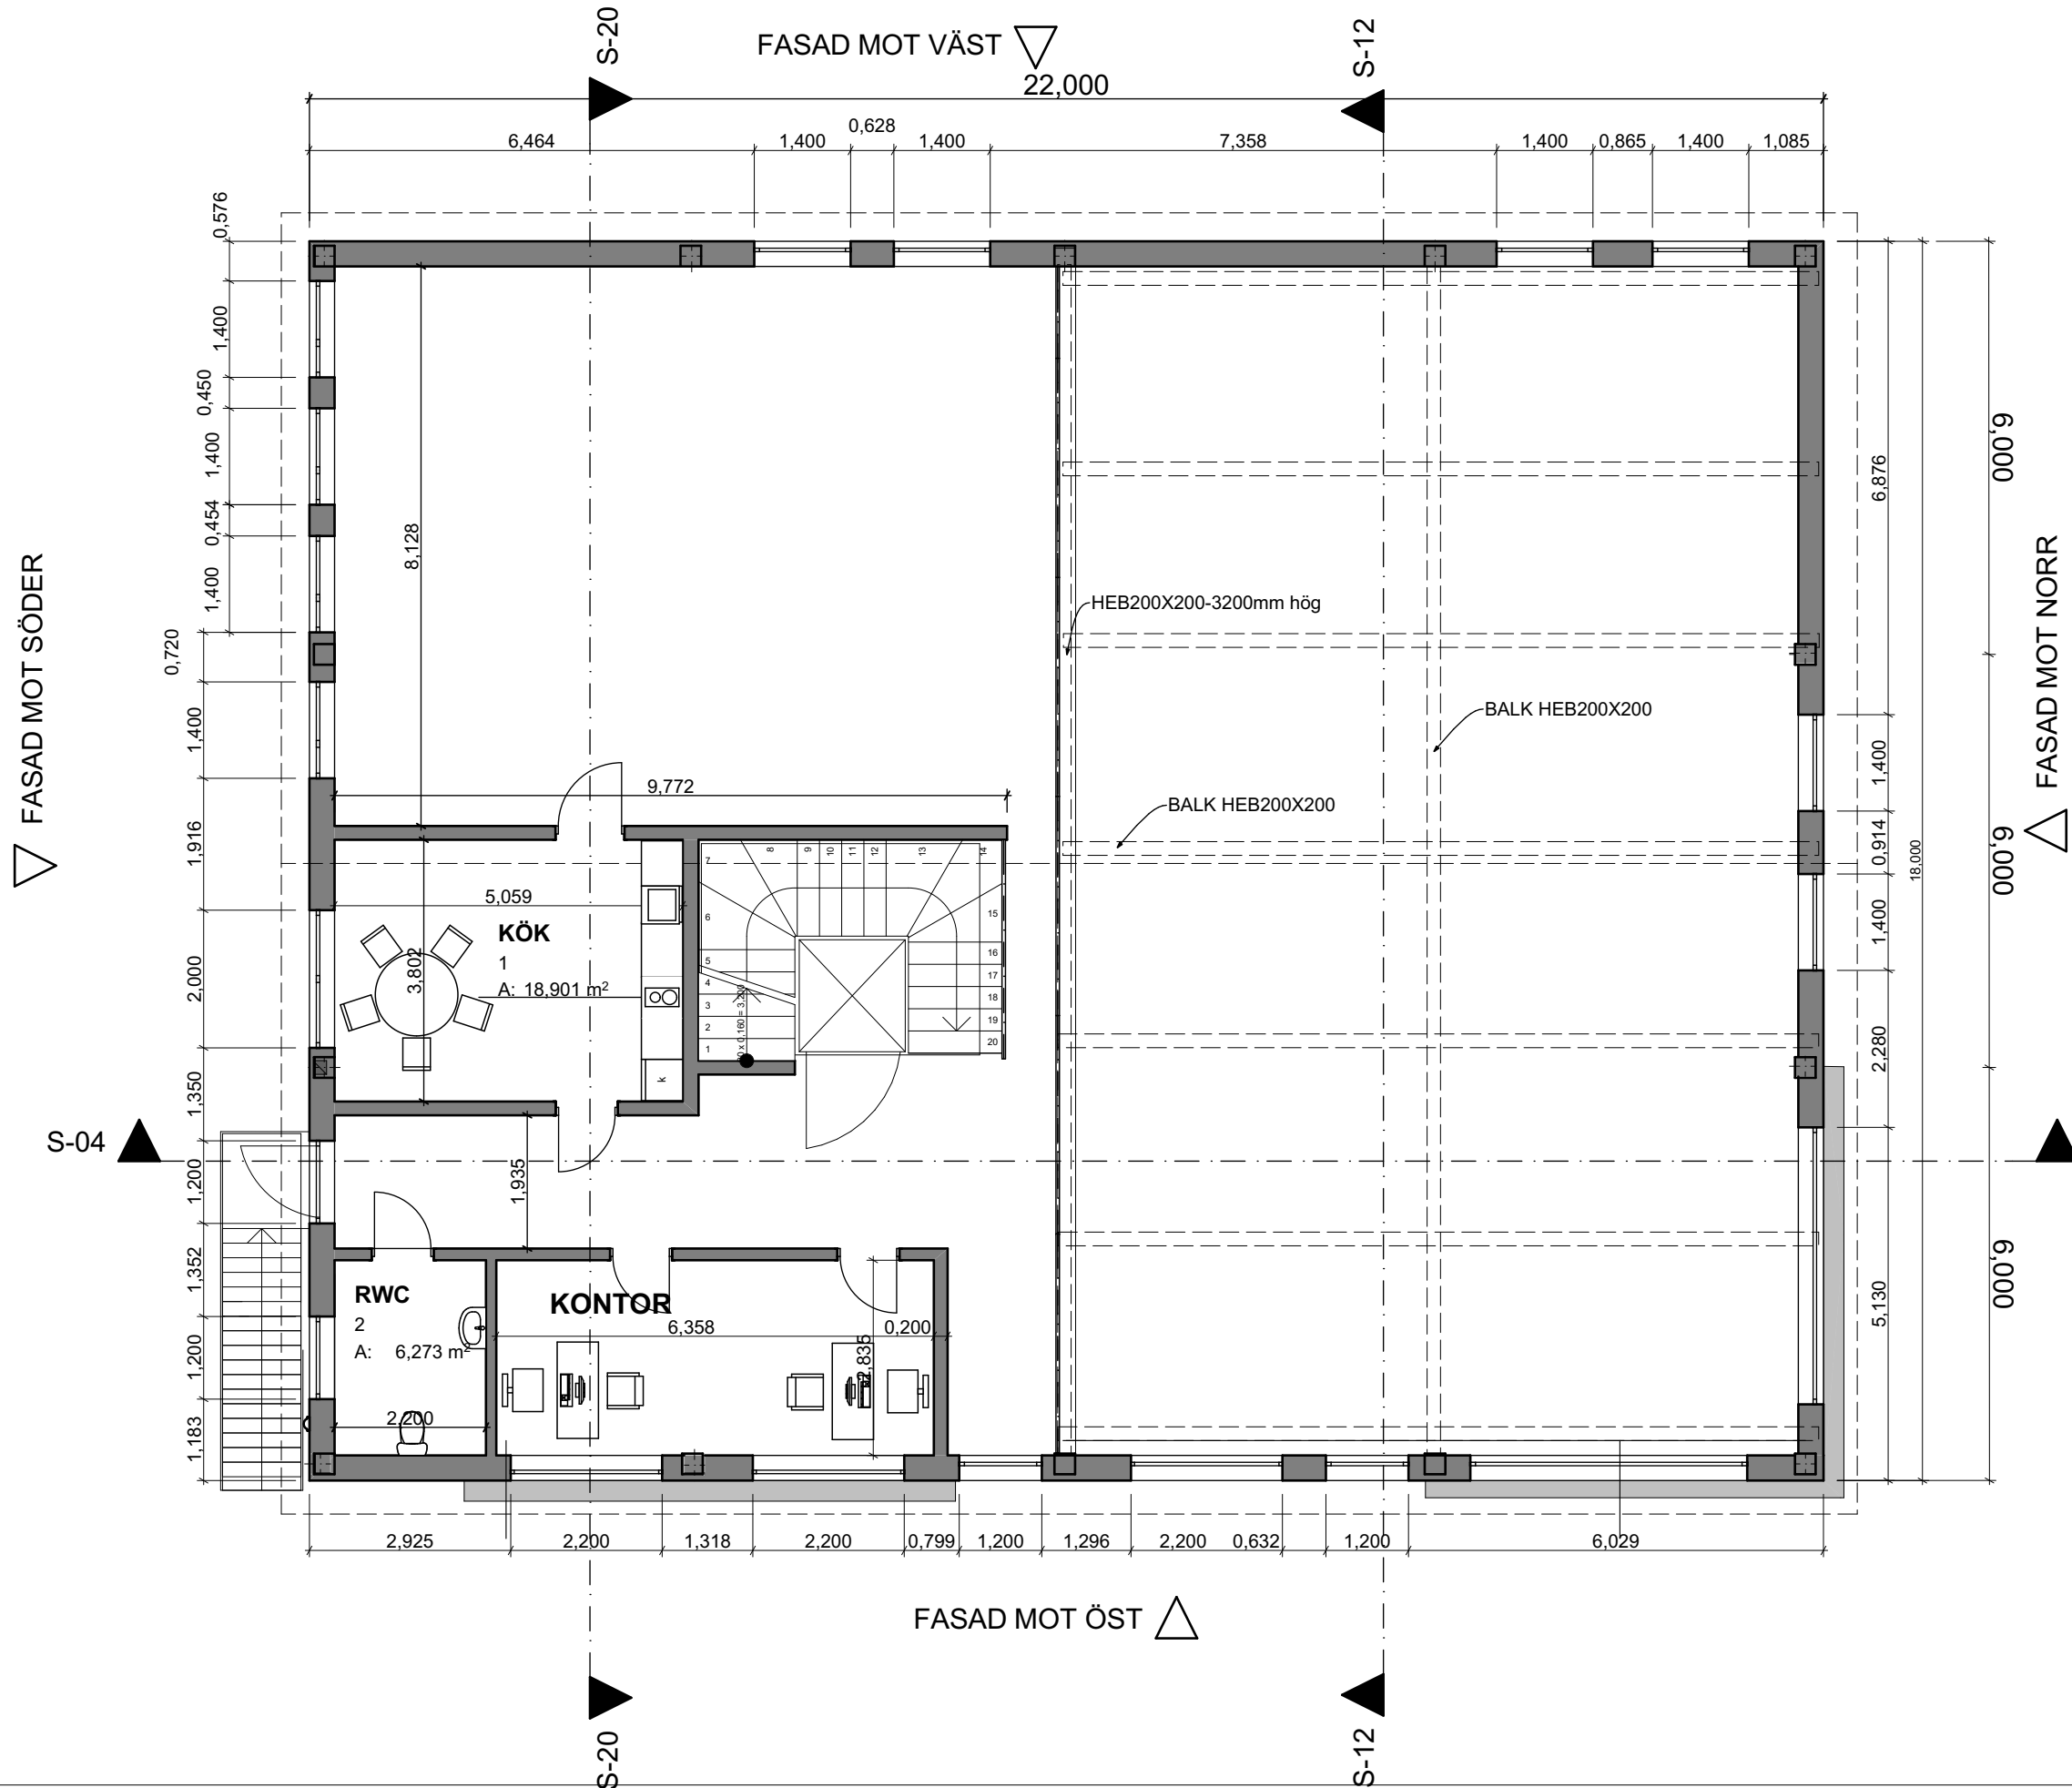

RELATIONSRITNIG
2024-05-29

Job Title	RÖRPOSTEN 1	
SIAV ARKITEKT AB #Contact City #Contact Country #Contact Postcode		
Drawing Name	VÅNING 1	
Drawing Status	#Project Status	
Drawn by SHAHO GORAN	Date	
Checked by SIAV ARKITEKT AB TEL-0700928885	Date	
Drawing Scale	1:100	
Layout ID A.01.3	Status	Revision