


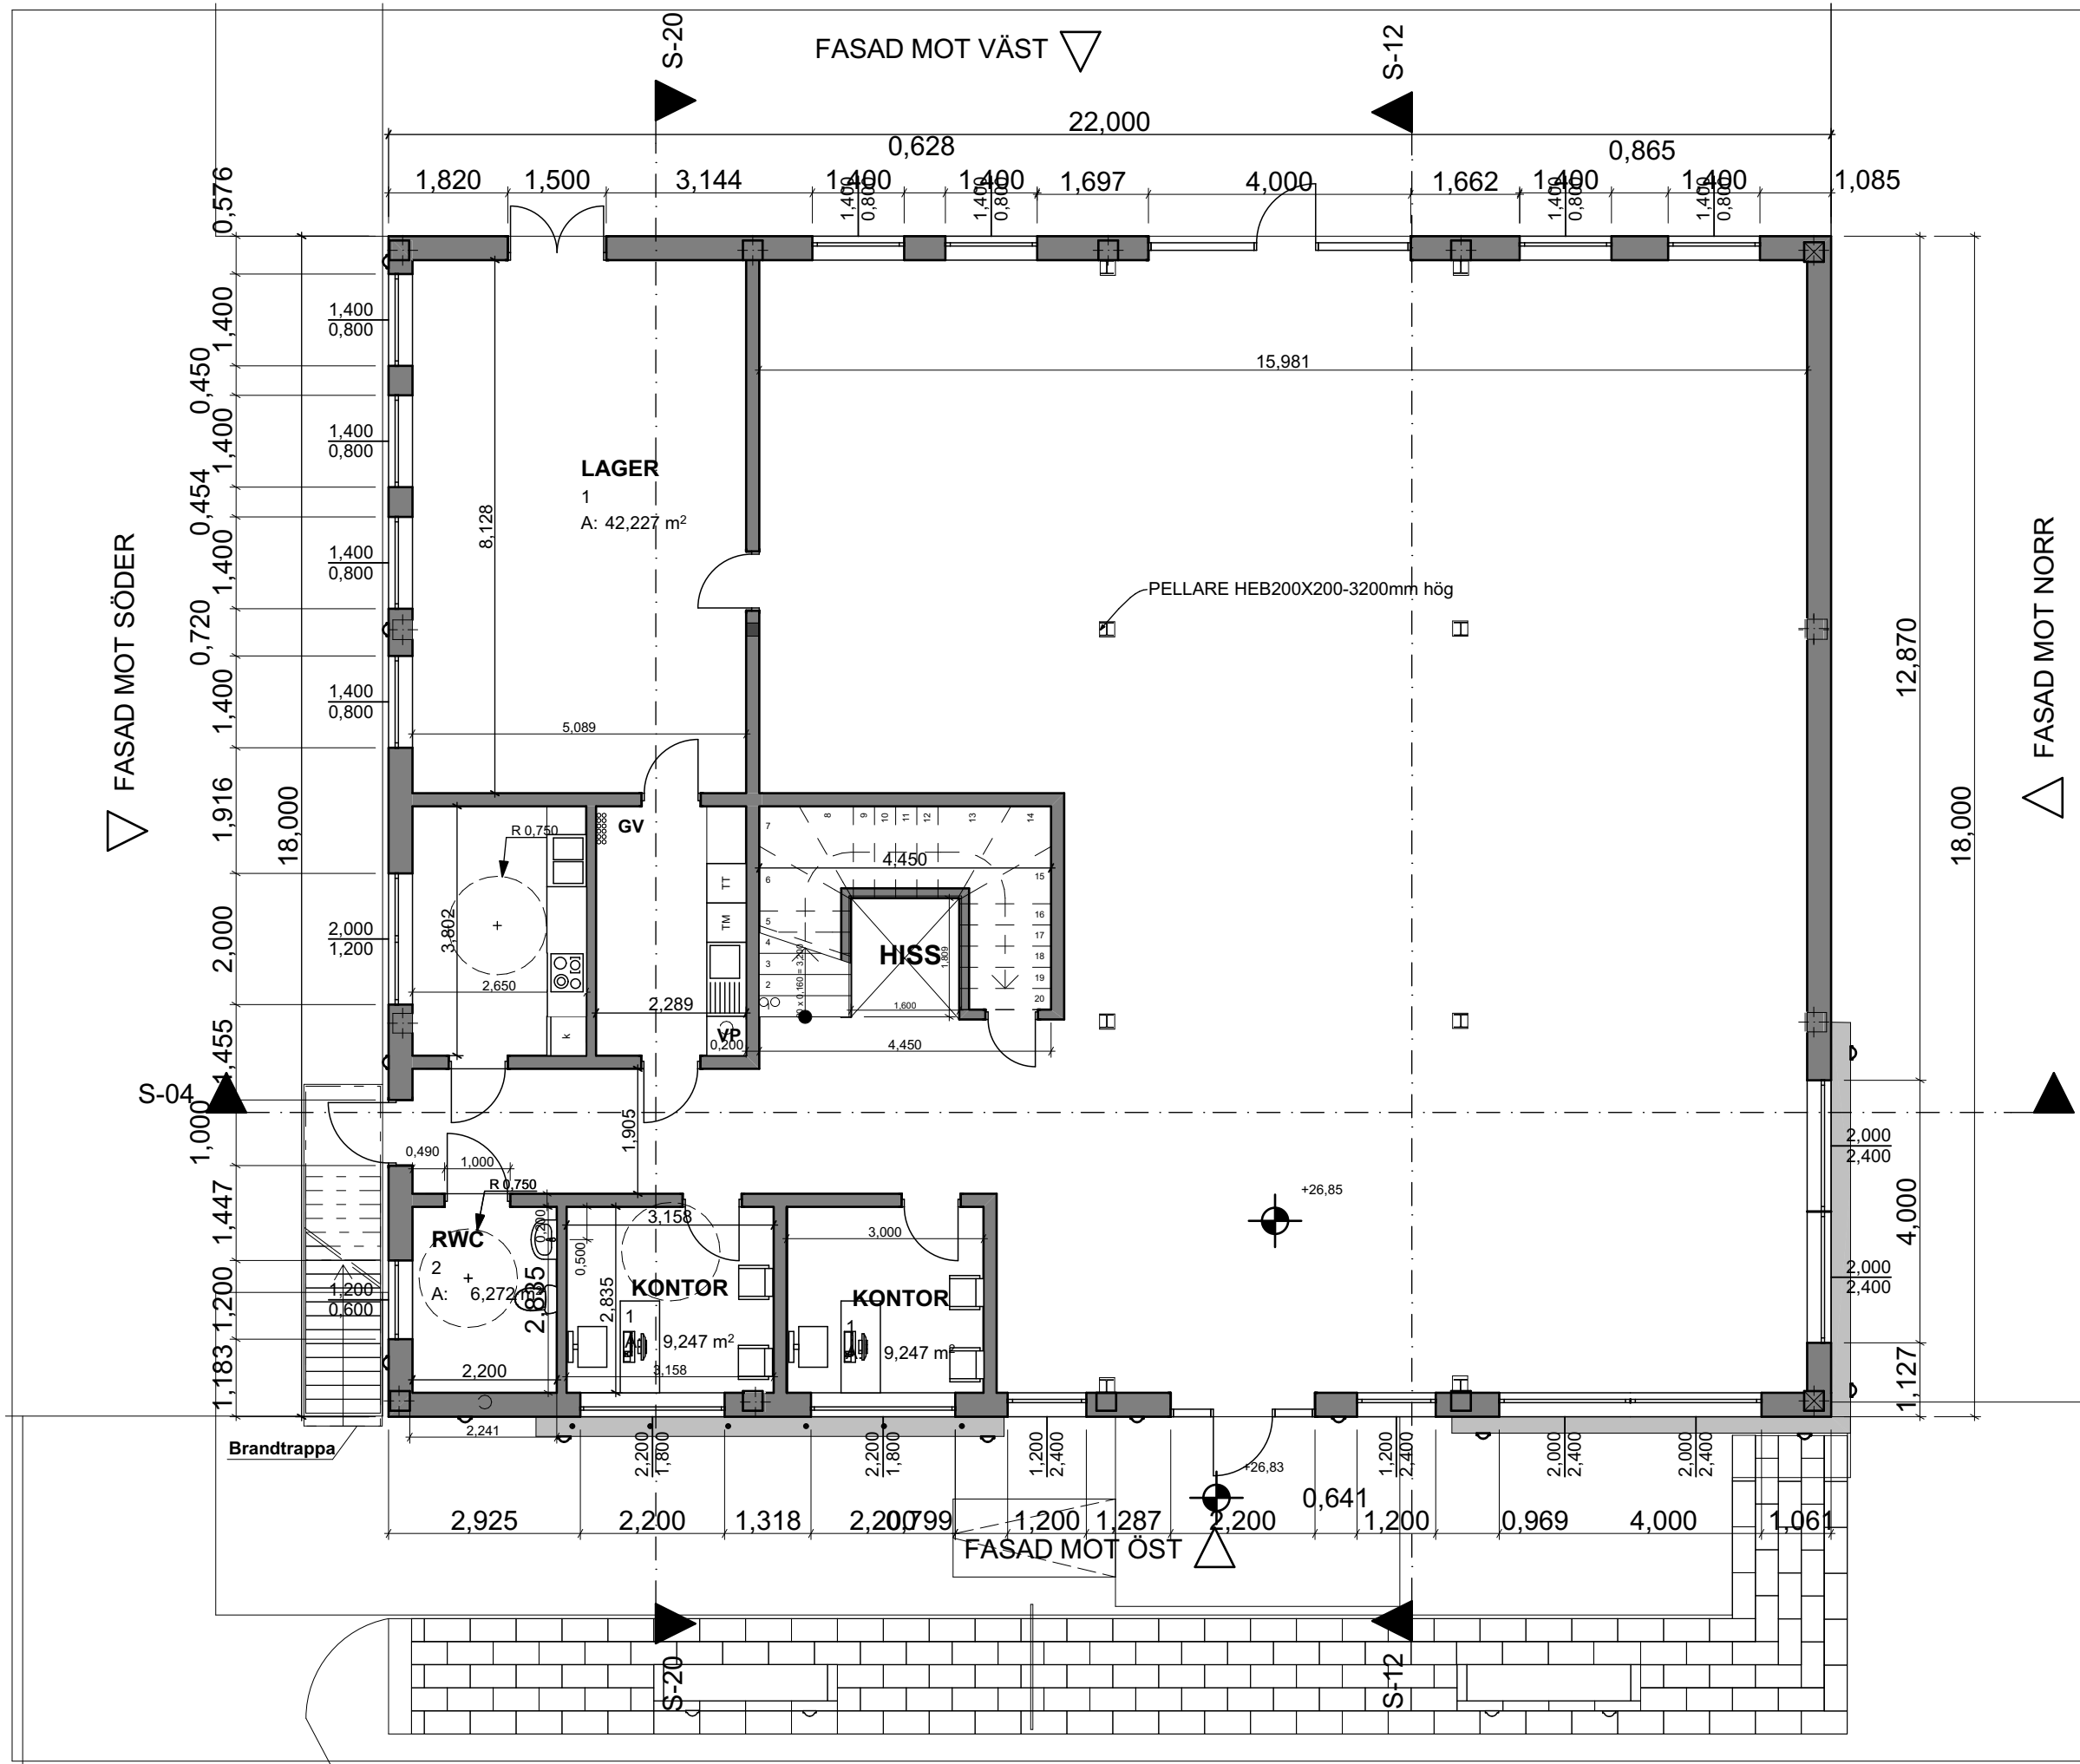

RELATIONSRITNIG 2024-05-29		
Job Title	RÖRPOSTEN 1	
SIAV ARKITEKT AB		
#Contact City		
#Contact Country		
#Contact Postcode		
Drawing Name	GRUNDPLAN (1)	
Drawing Status	#Project Status	
Drawn by	SHAHO GORAN	Date
Checked by	SIAV ARKITEKT AB TEL-0700928885	Date
Drawing Scale	1:100	
Layout ID	Status	Revision
A.01.1		