

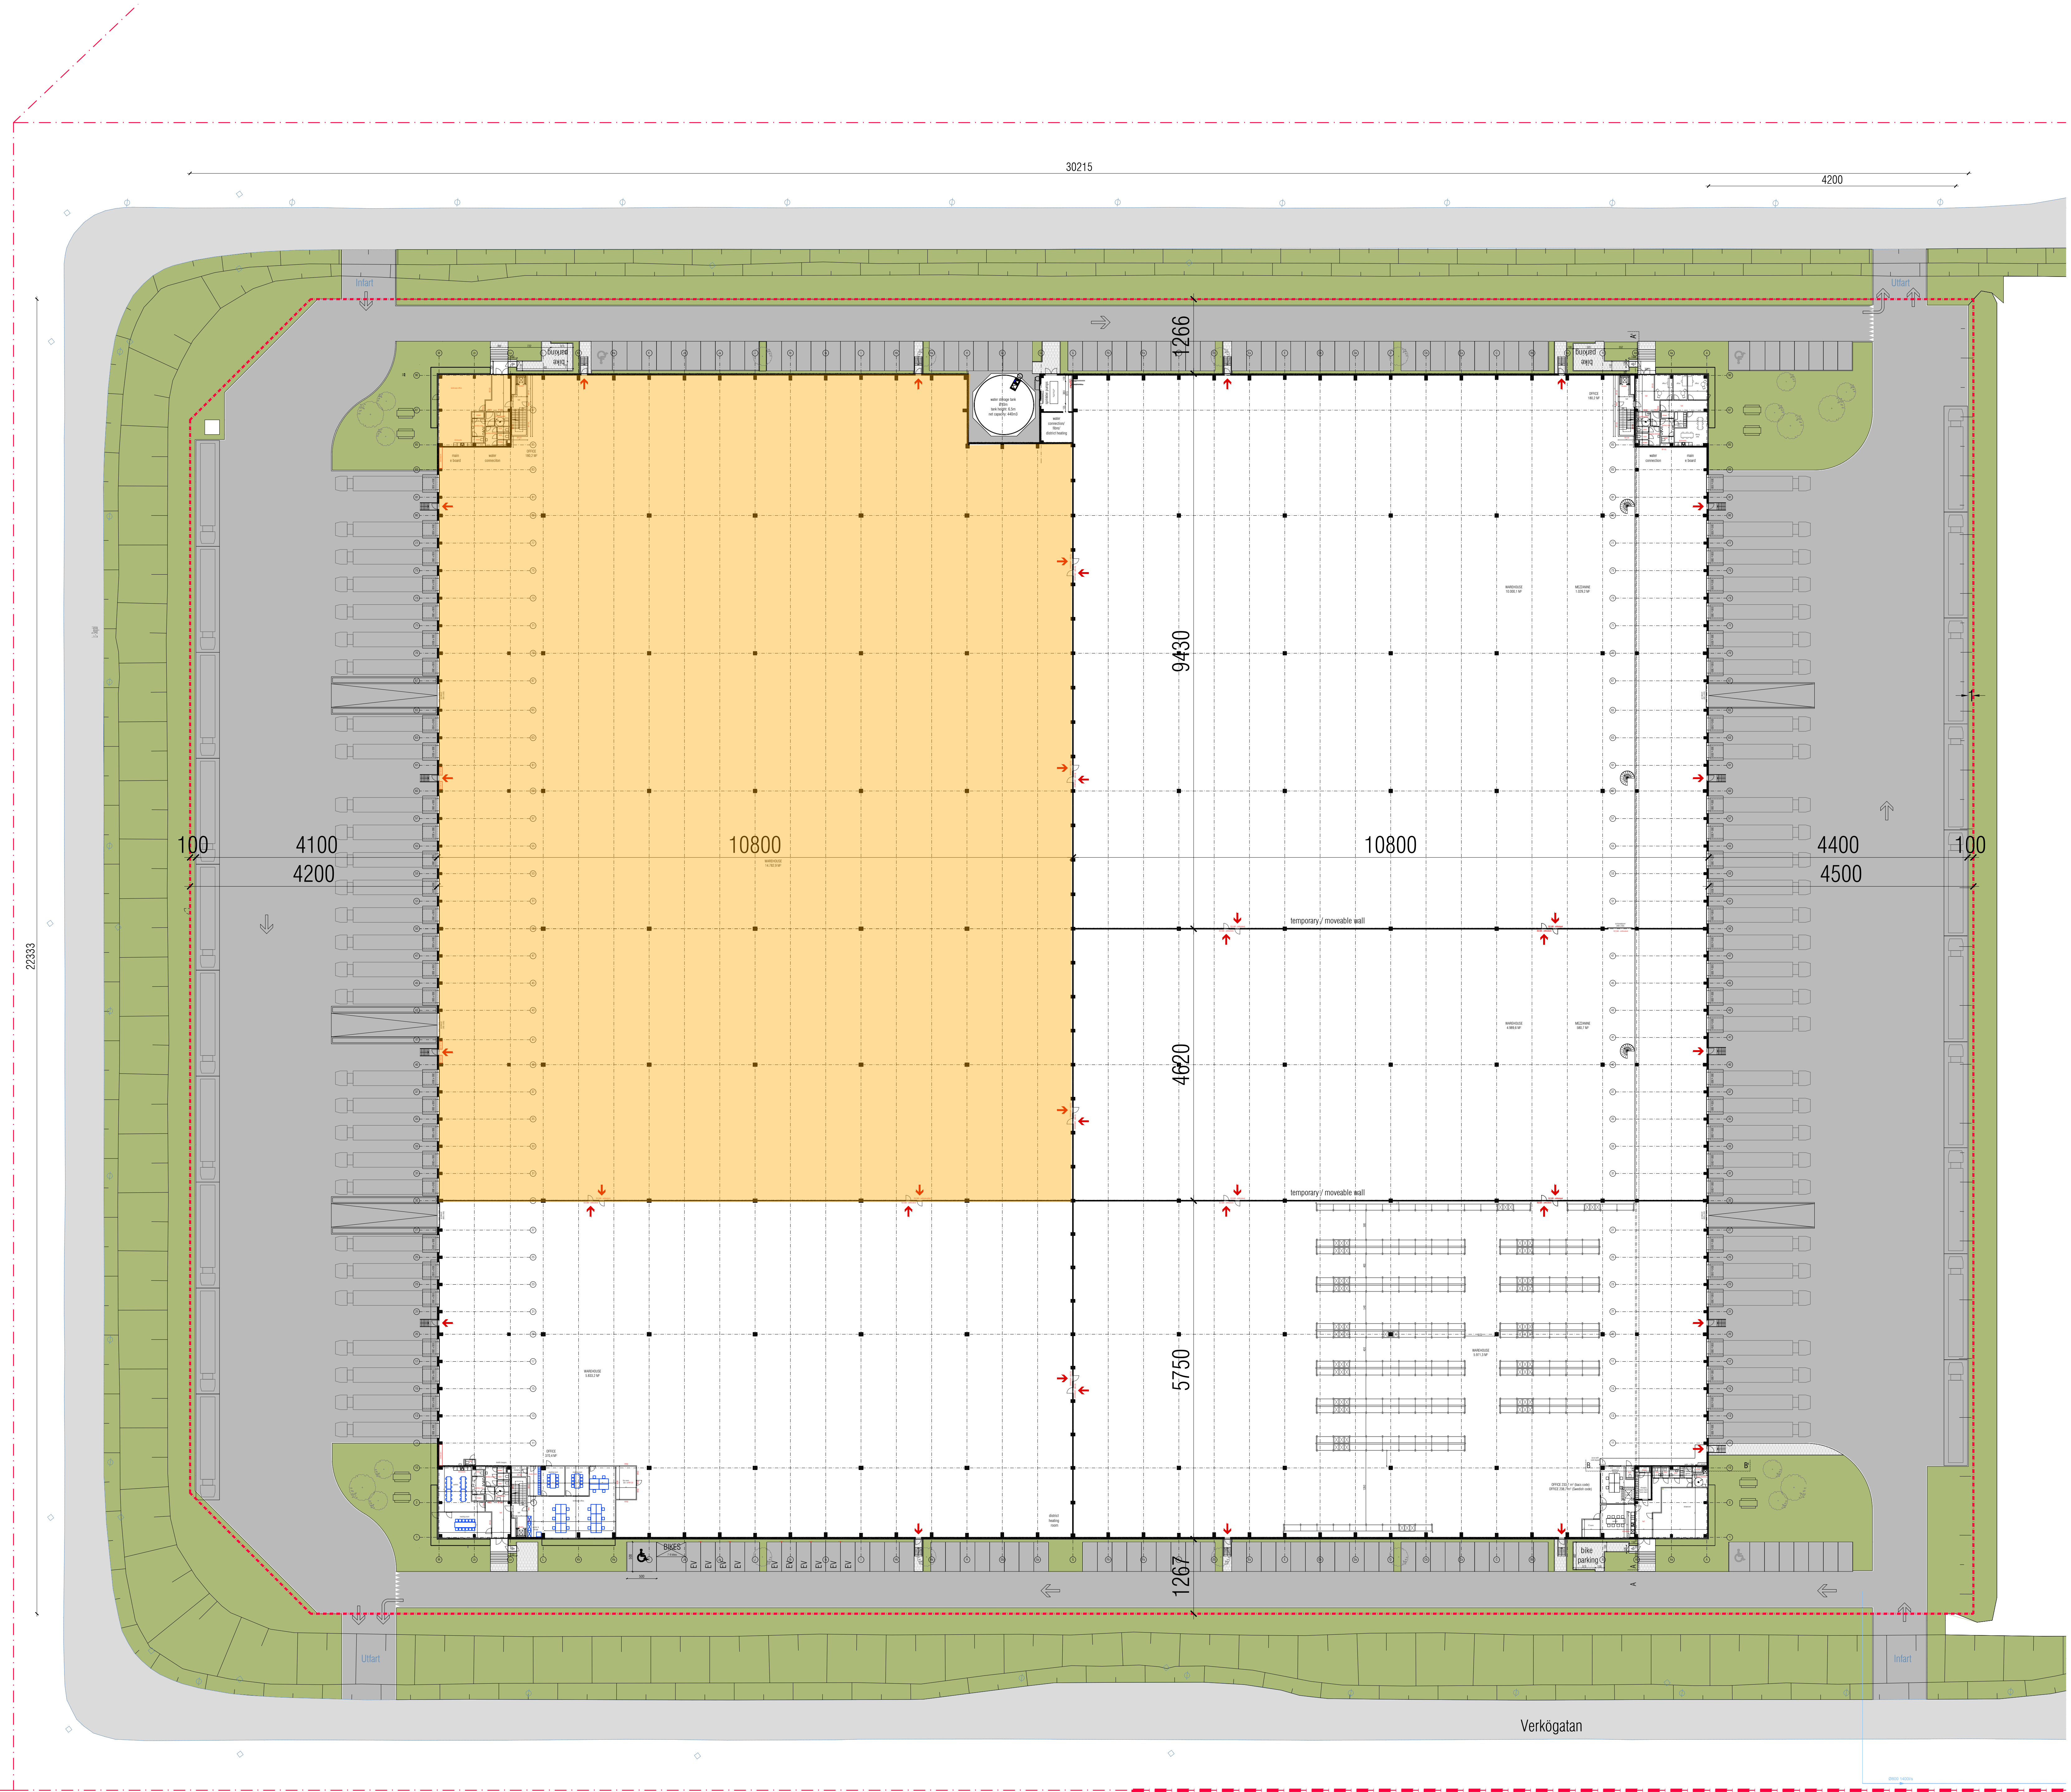


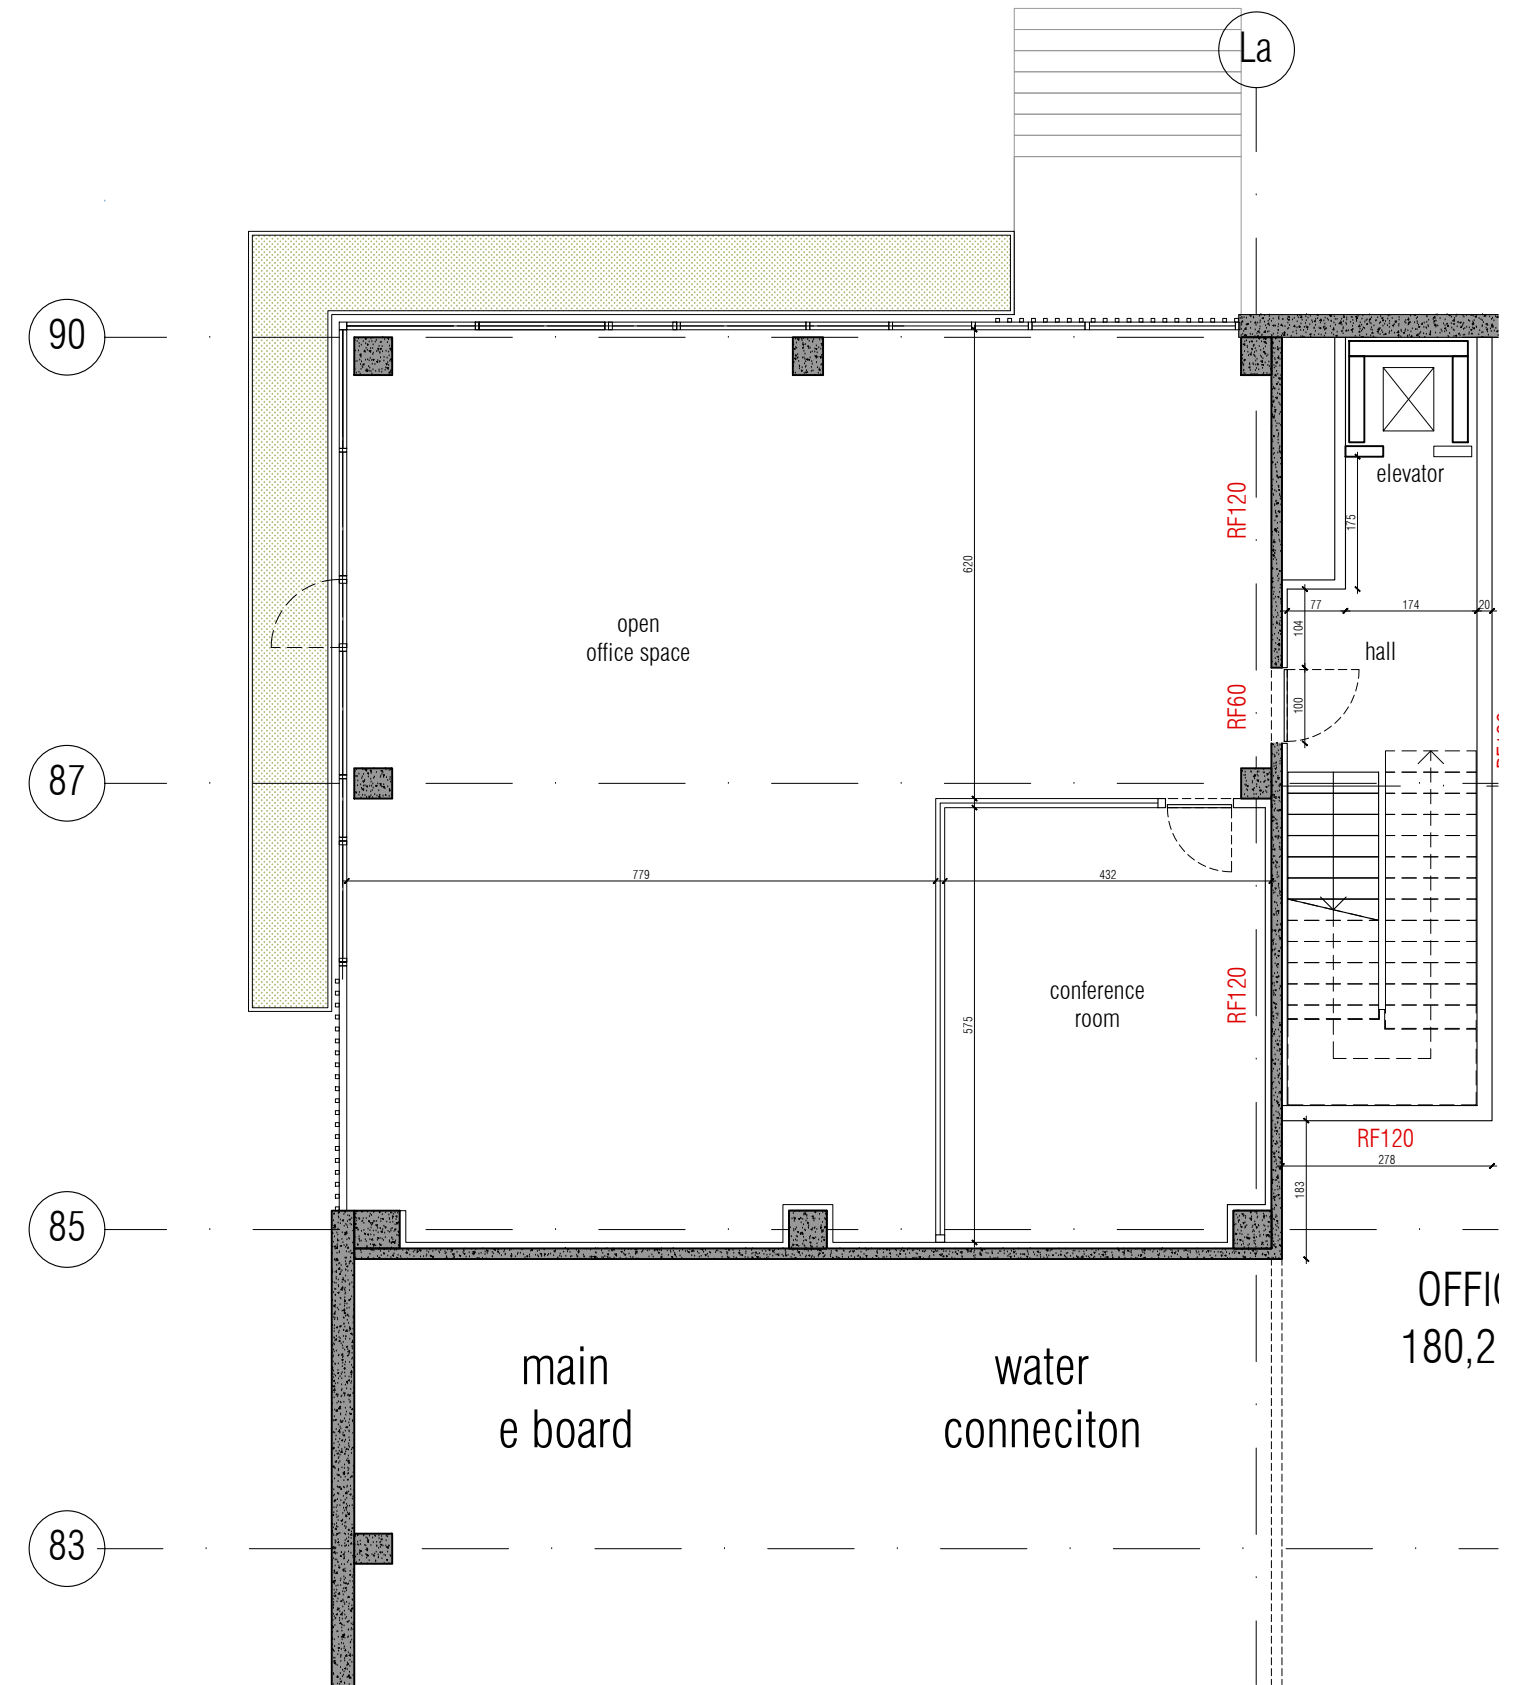

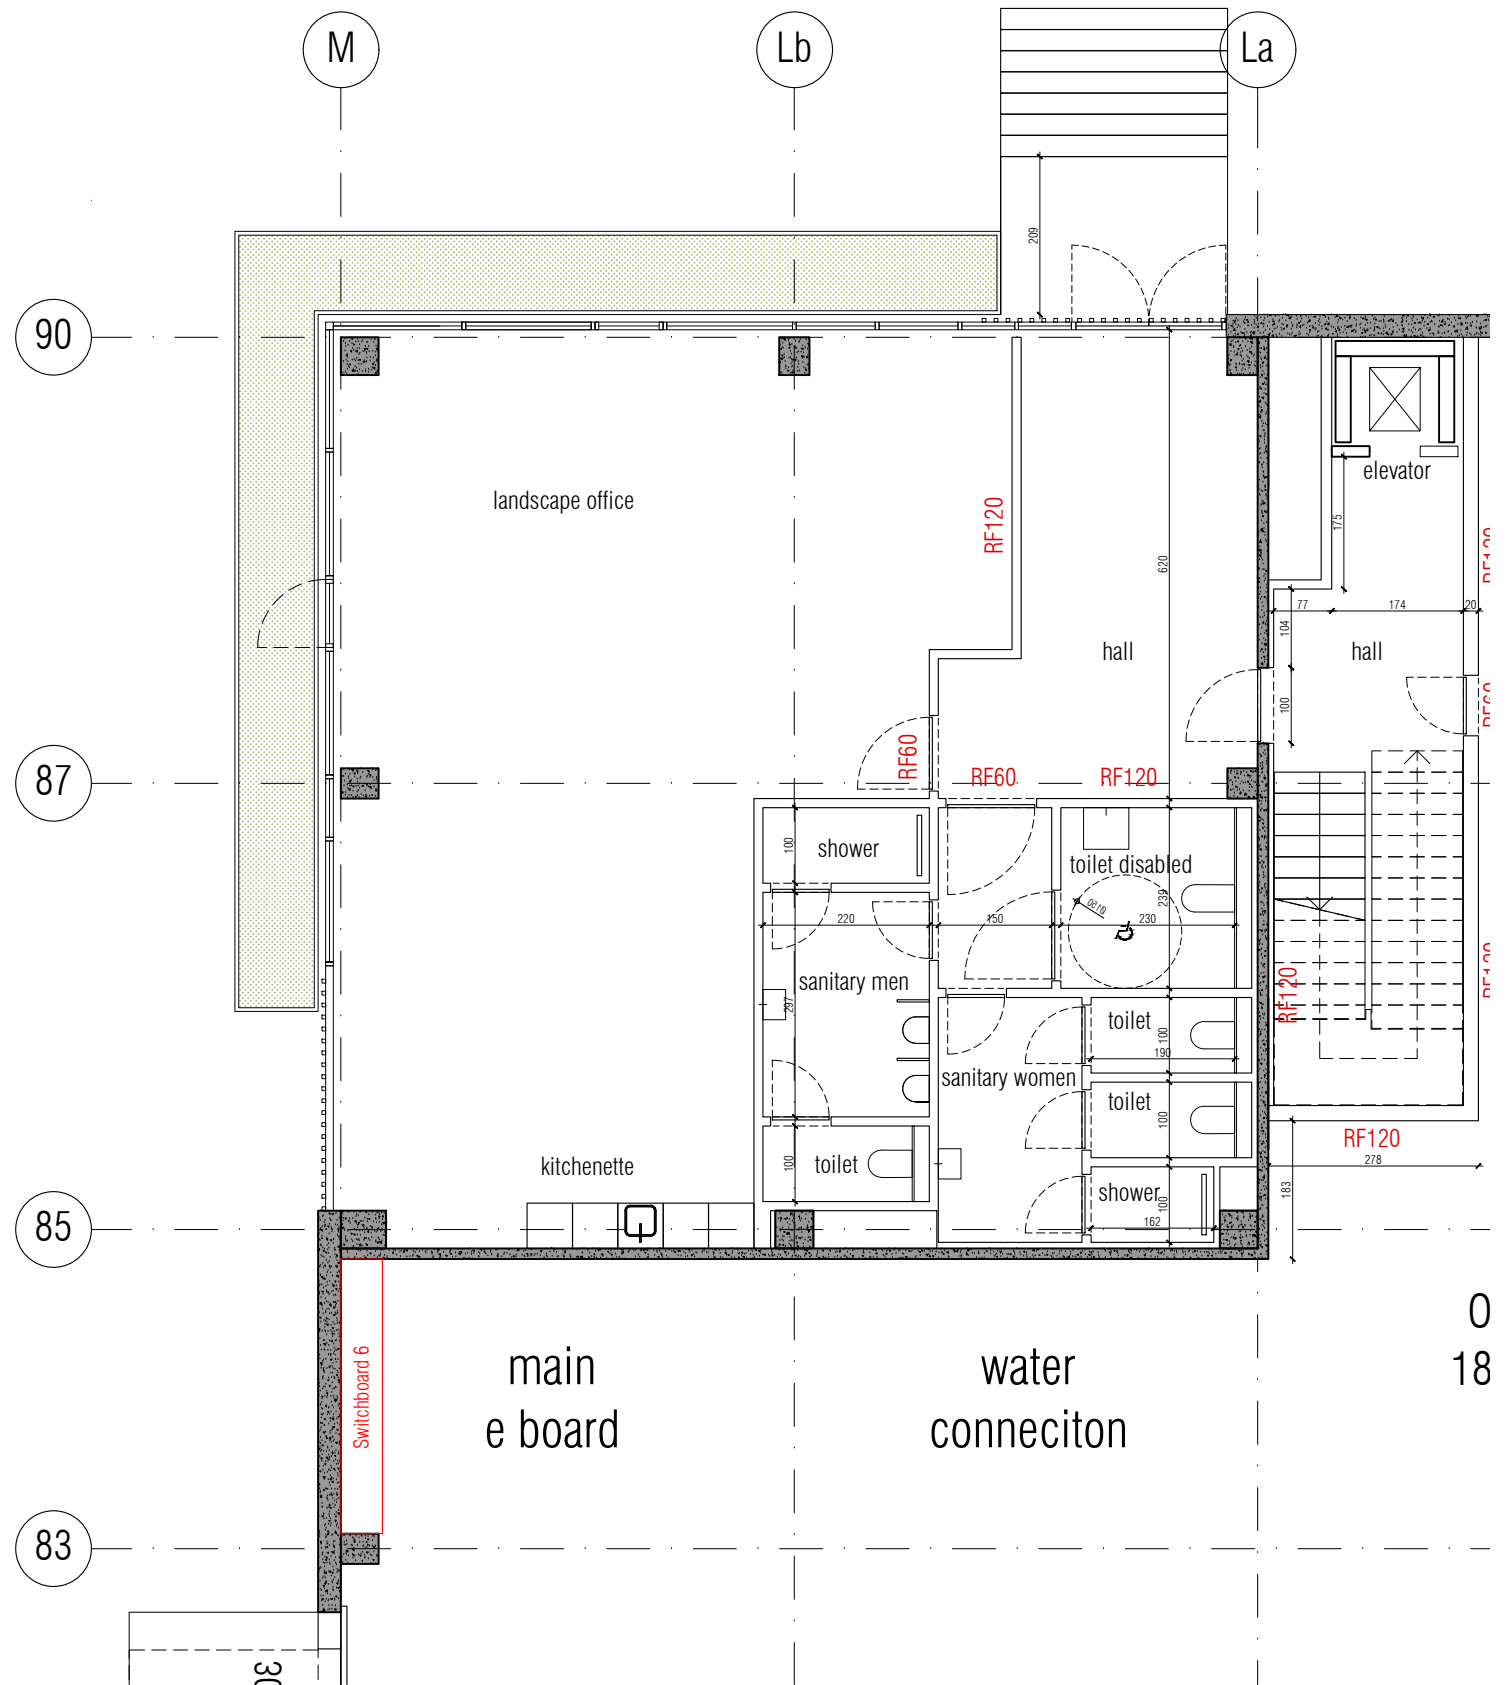

PLANTITLE:
U4 - AS-BUILT - OFFICE
GROUND FLOOR & FIRST FLOOR

SCALE:
1/100

DATE:
25/10/2023

OFFICE
180,2