


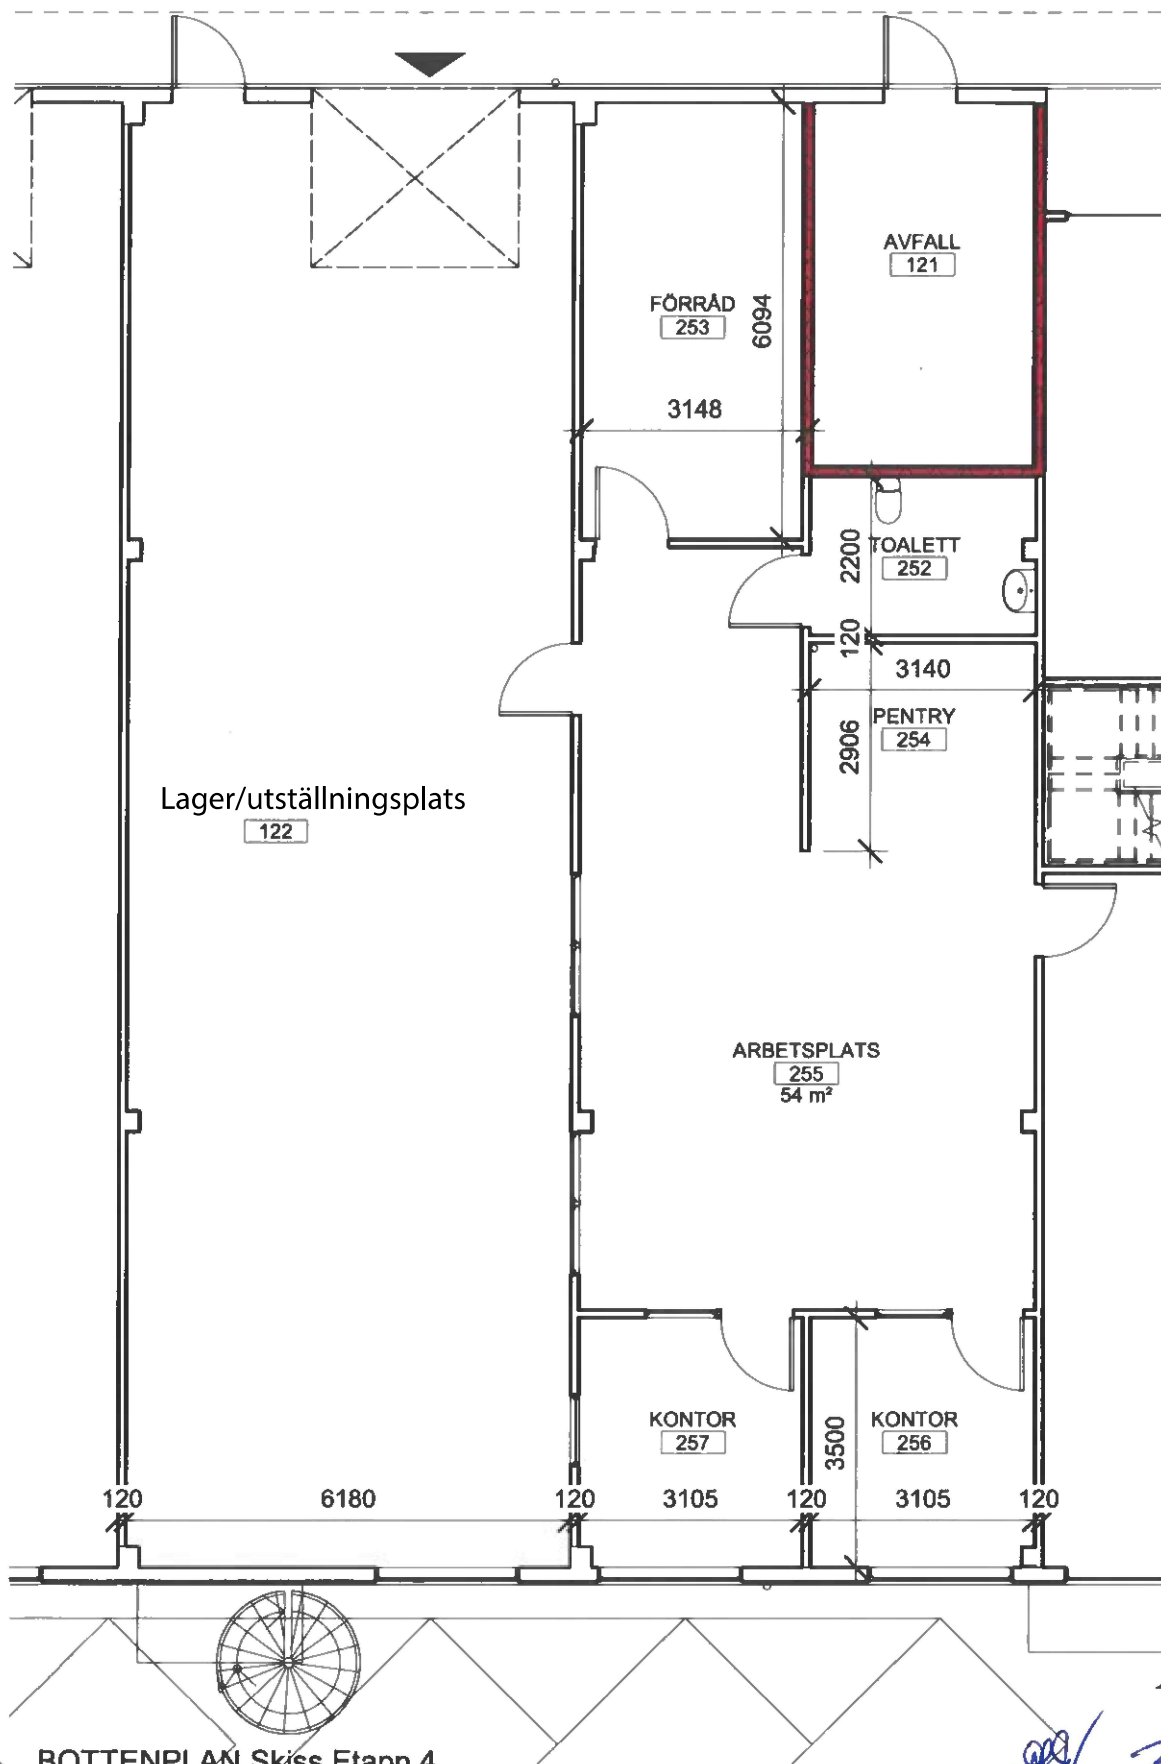

Handwritten signatures and initials.

1

BOTTENPLAN Skiss Etapp 4

1 : 100

DESSDE AB
info@dessde.com

Arlov 3:35

Projekt num. 2021_09_B
Datum Issue Date

A-40-1-106
Skala 1 : 100