


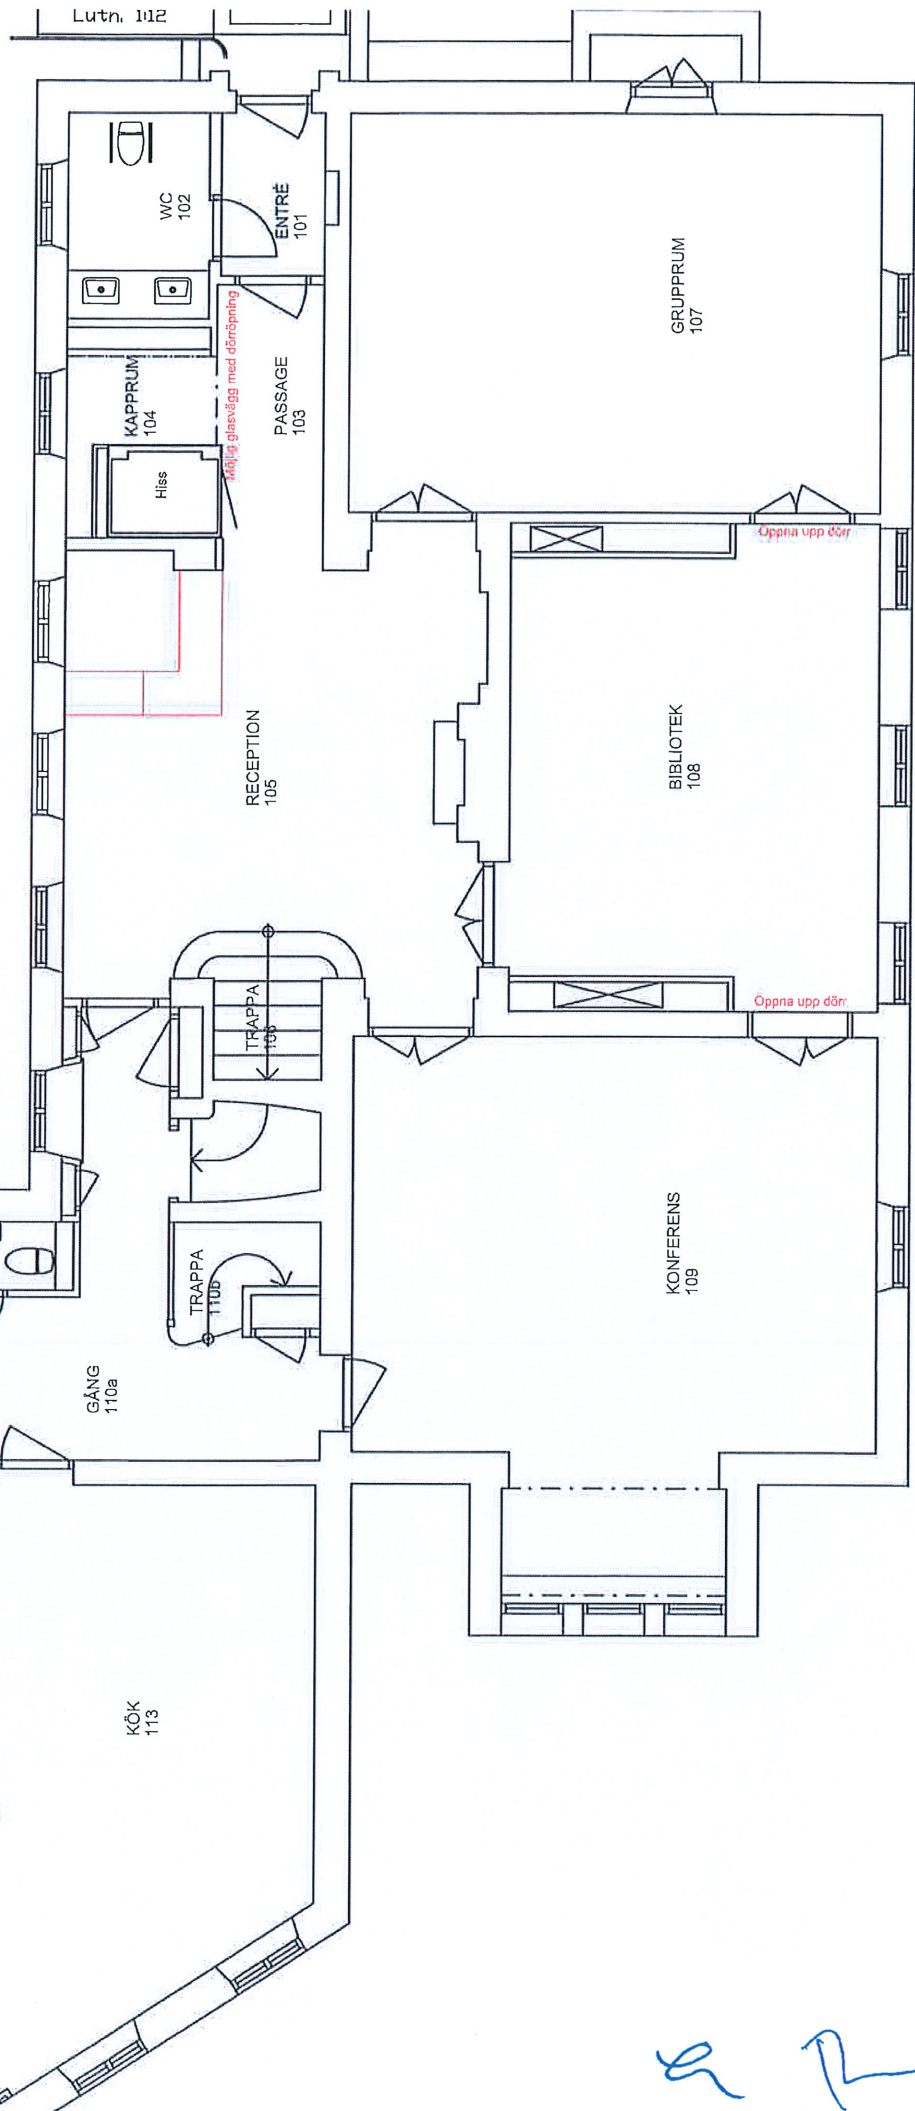

Handwritten signature or initials in blue ink.