


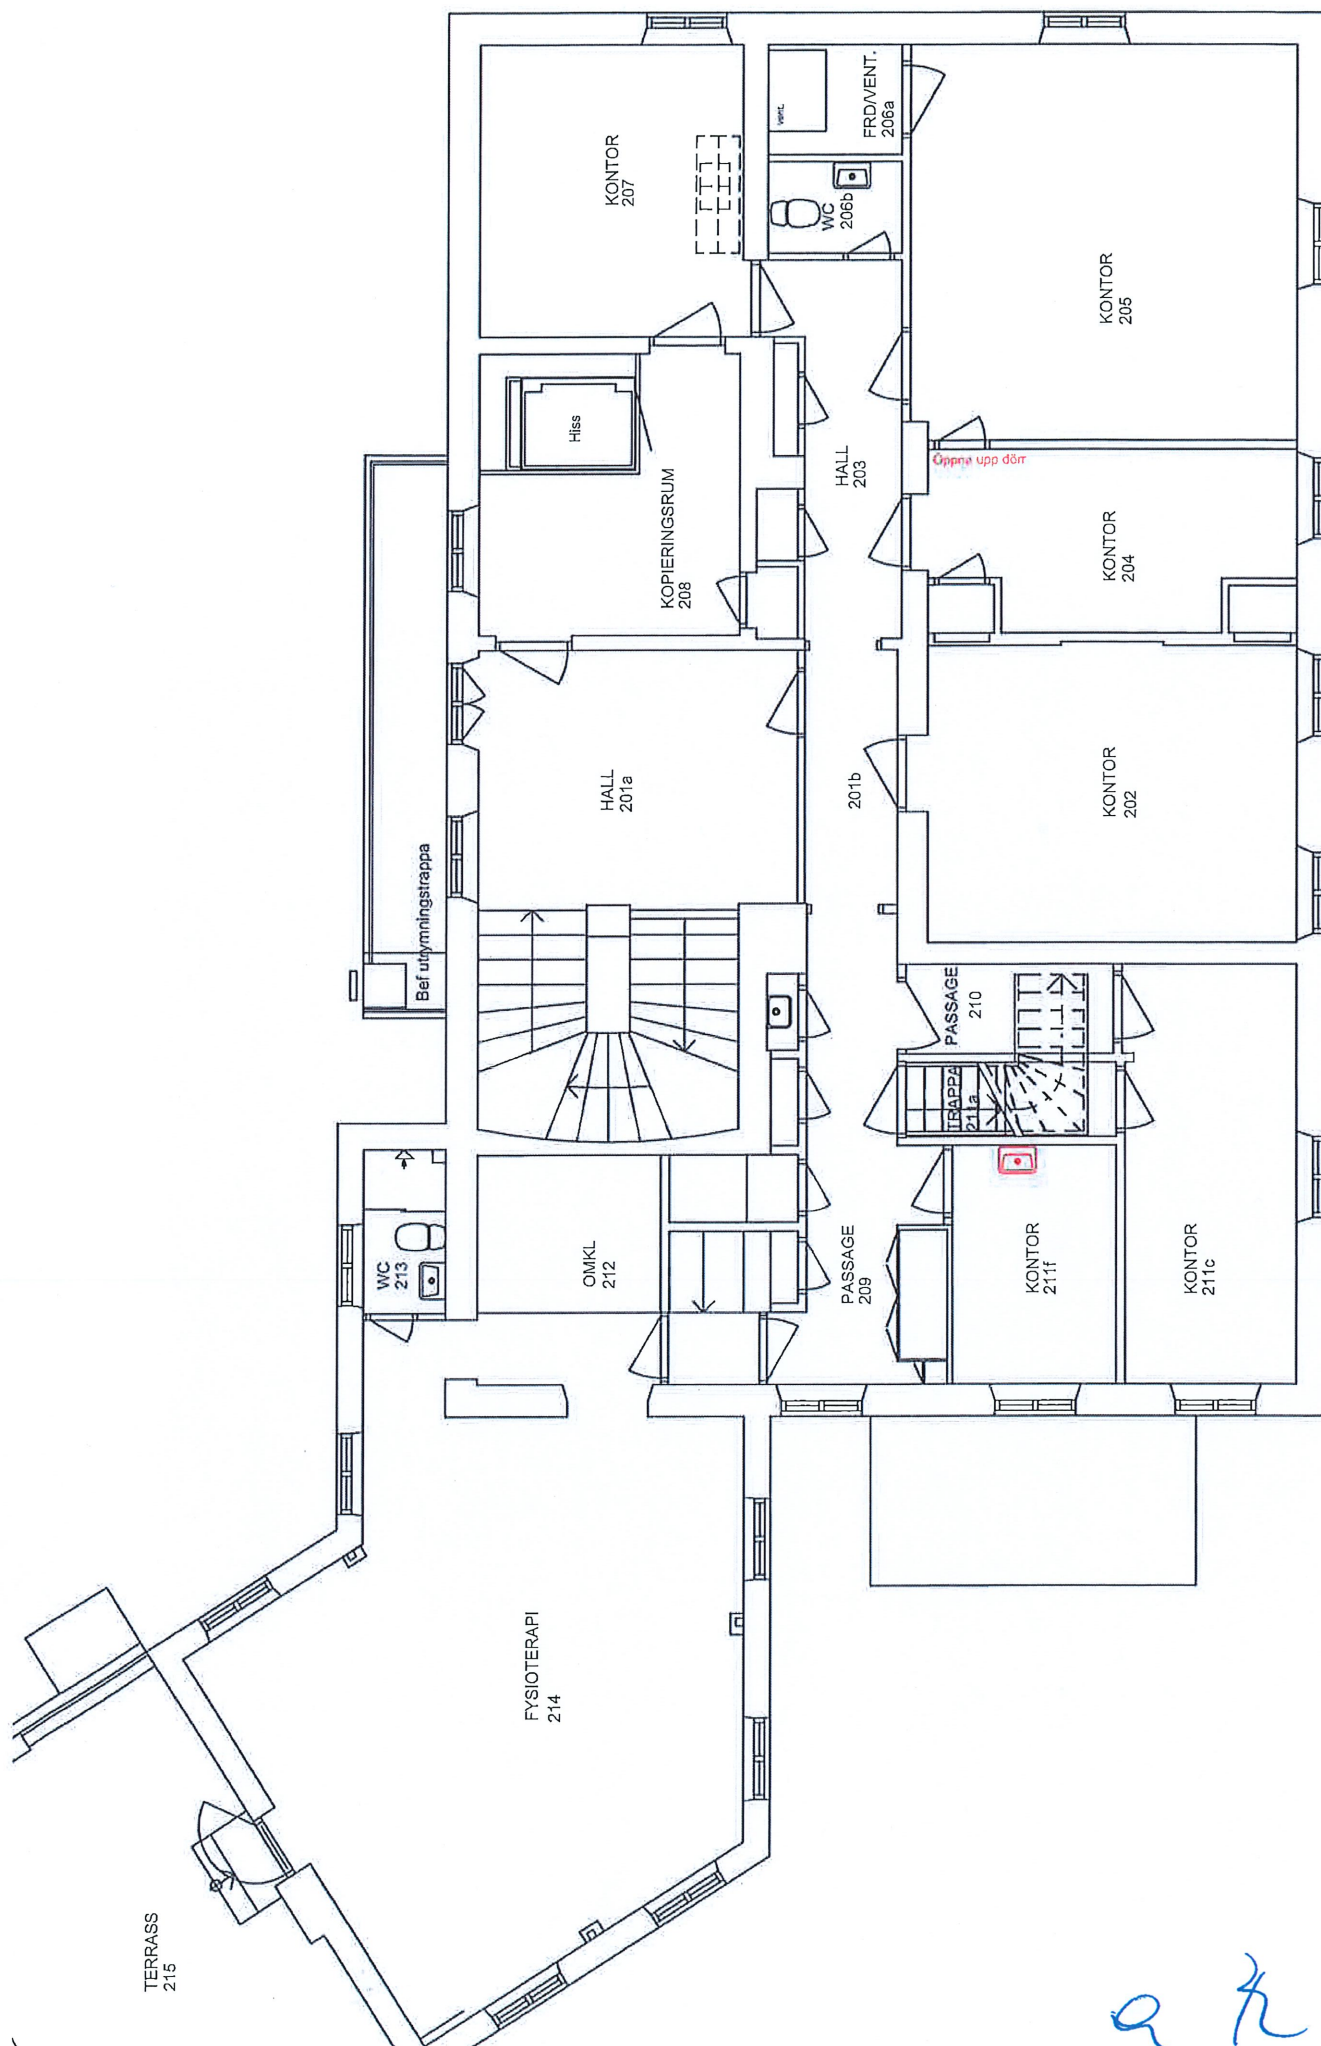

2 12 2