


30020UTV SOCKEL

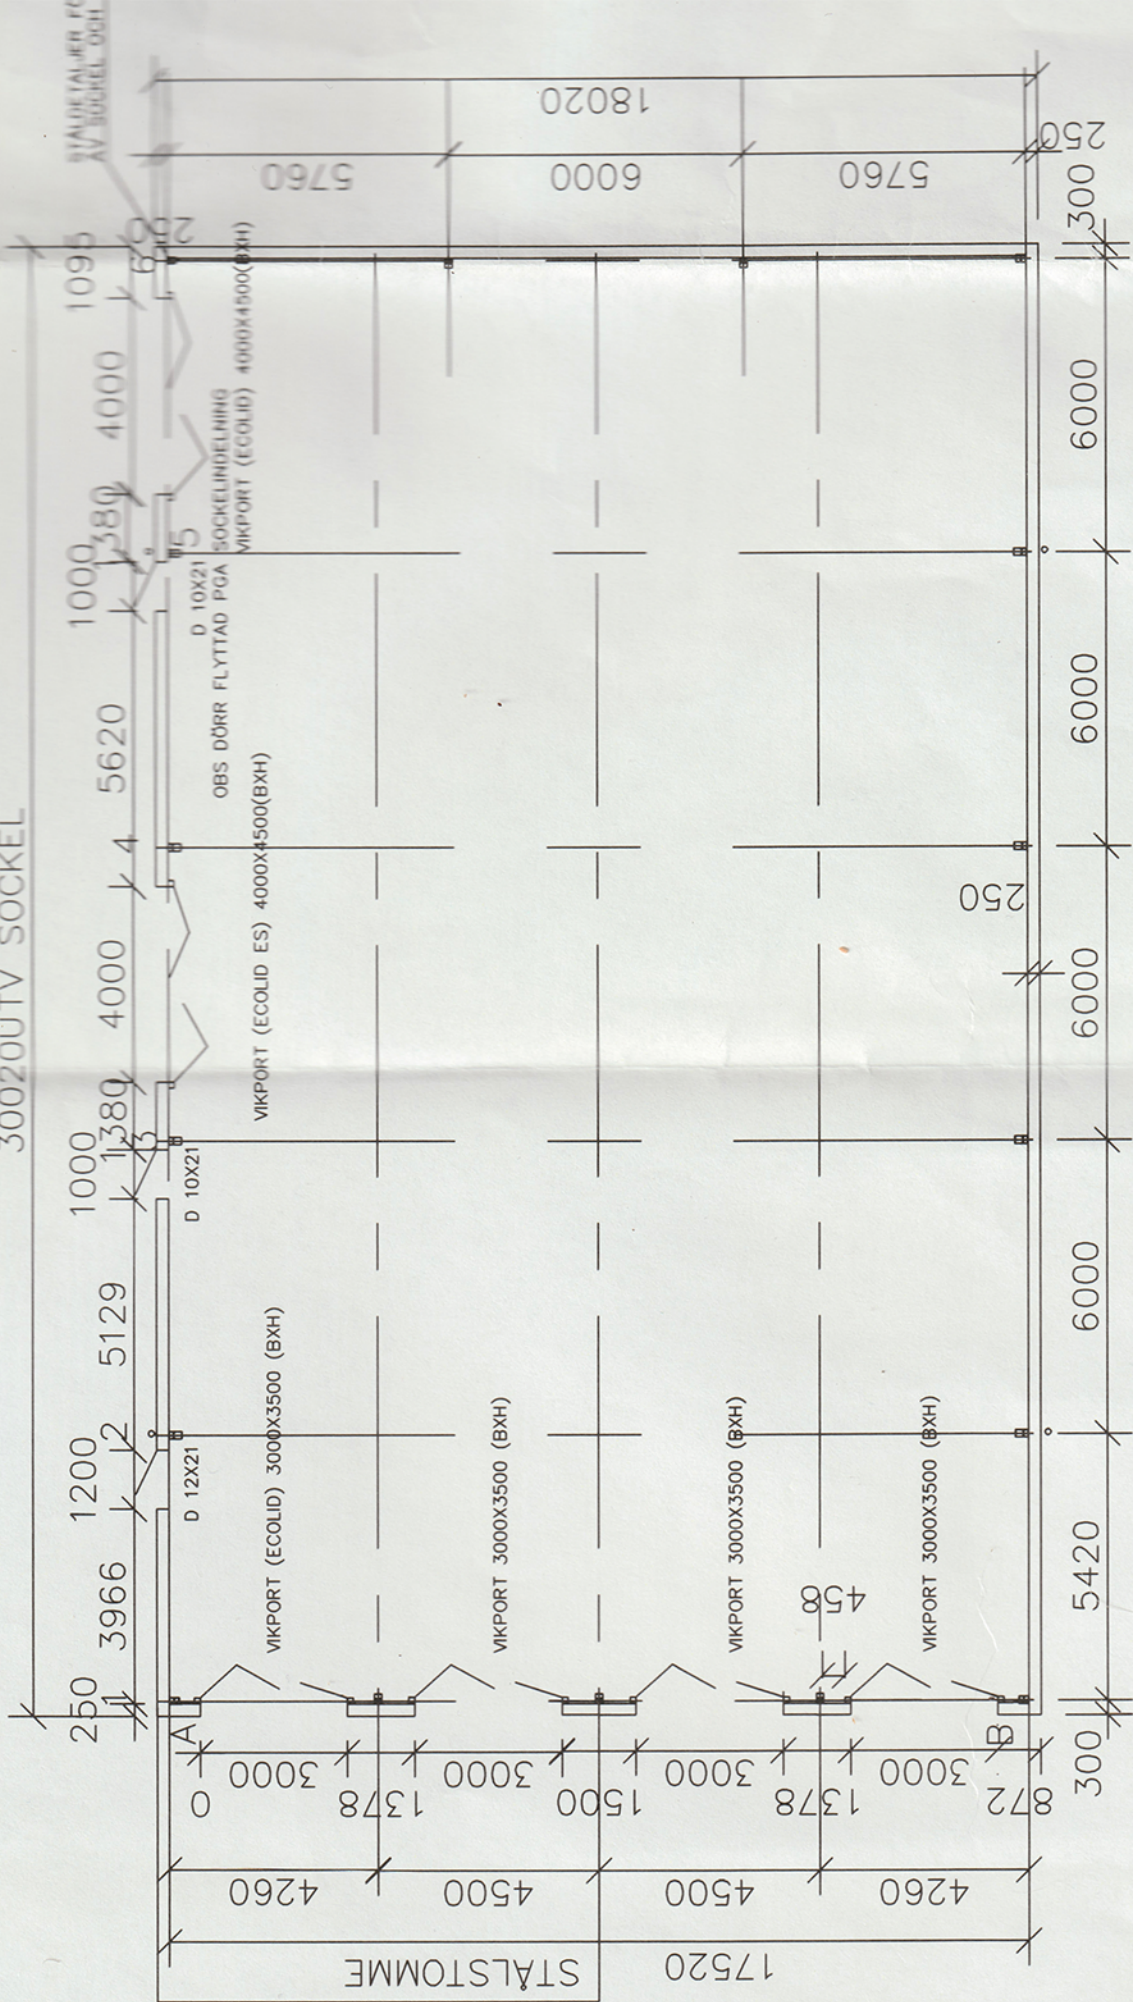

PLANRITNING