


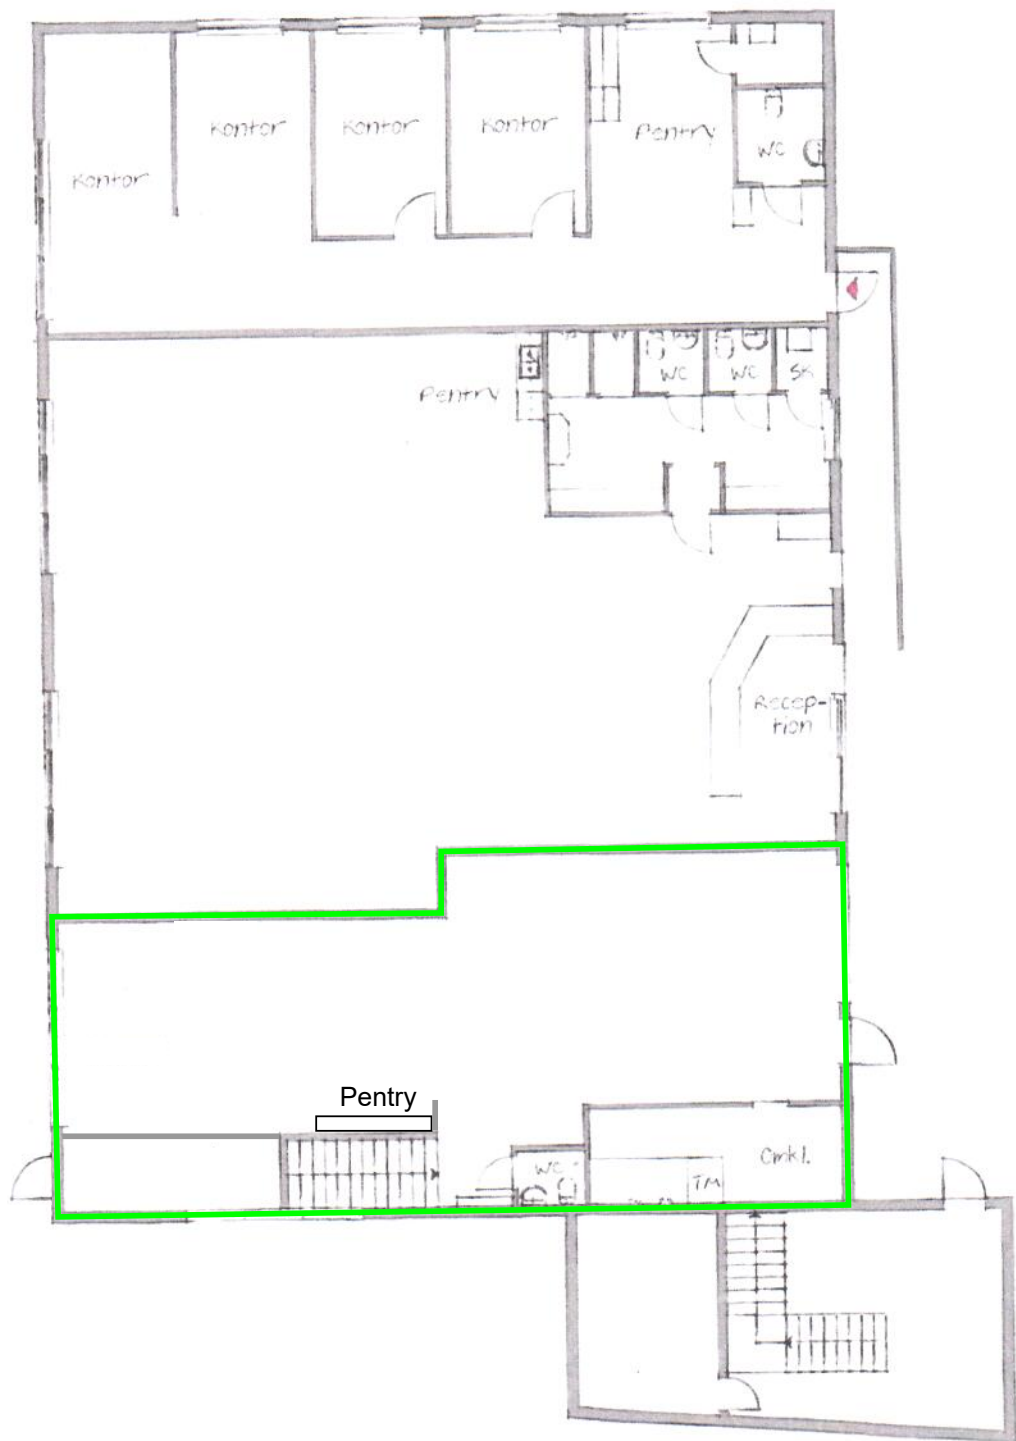

Plan 2