



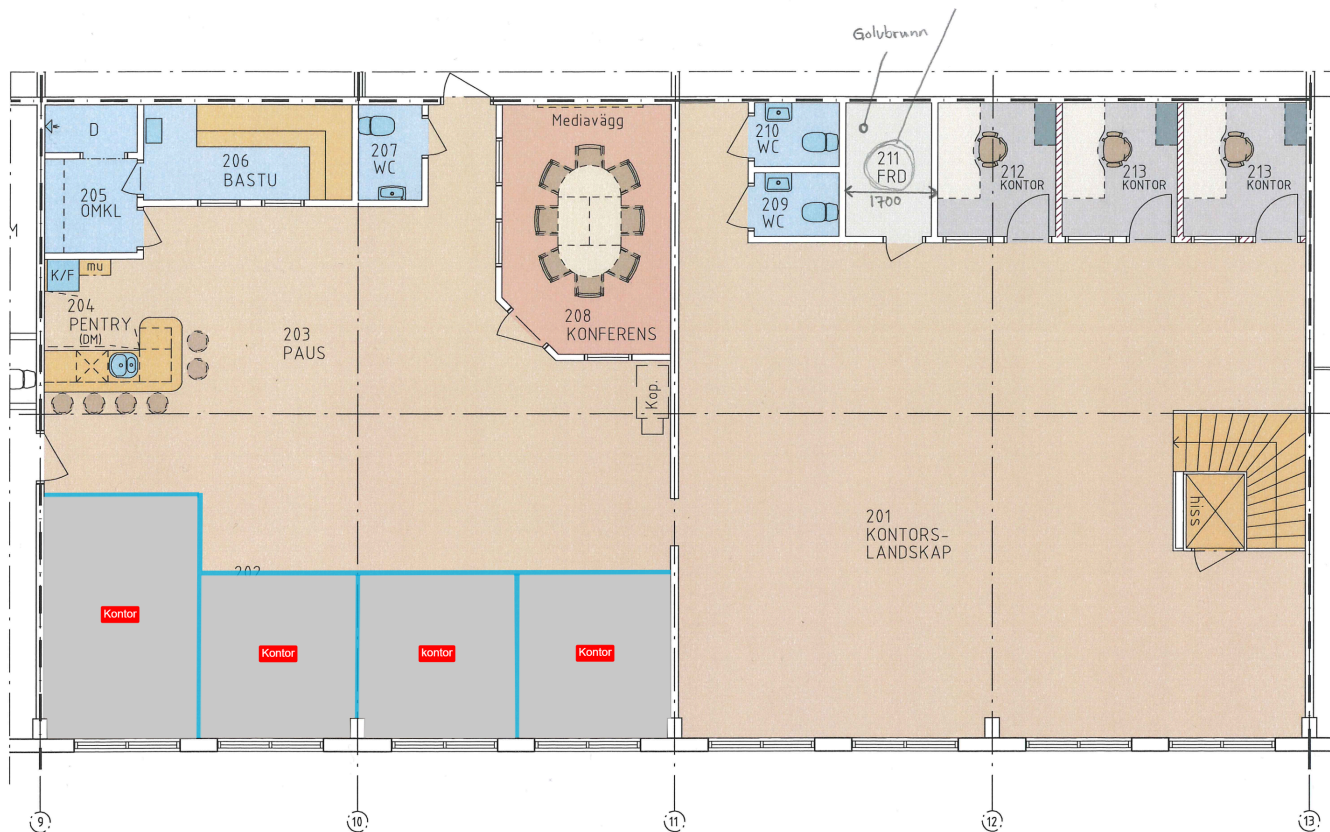


PLAN, VÅN 1 TR →

Meter skala 1:100/A3

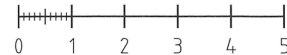

ORIENTERINGSFIGUR
EJ SKALENLIG →

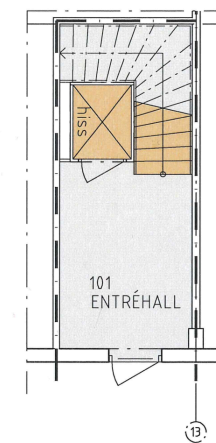

PLAN, BV →

EGERYDS