


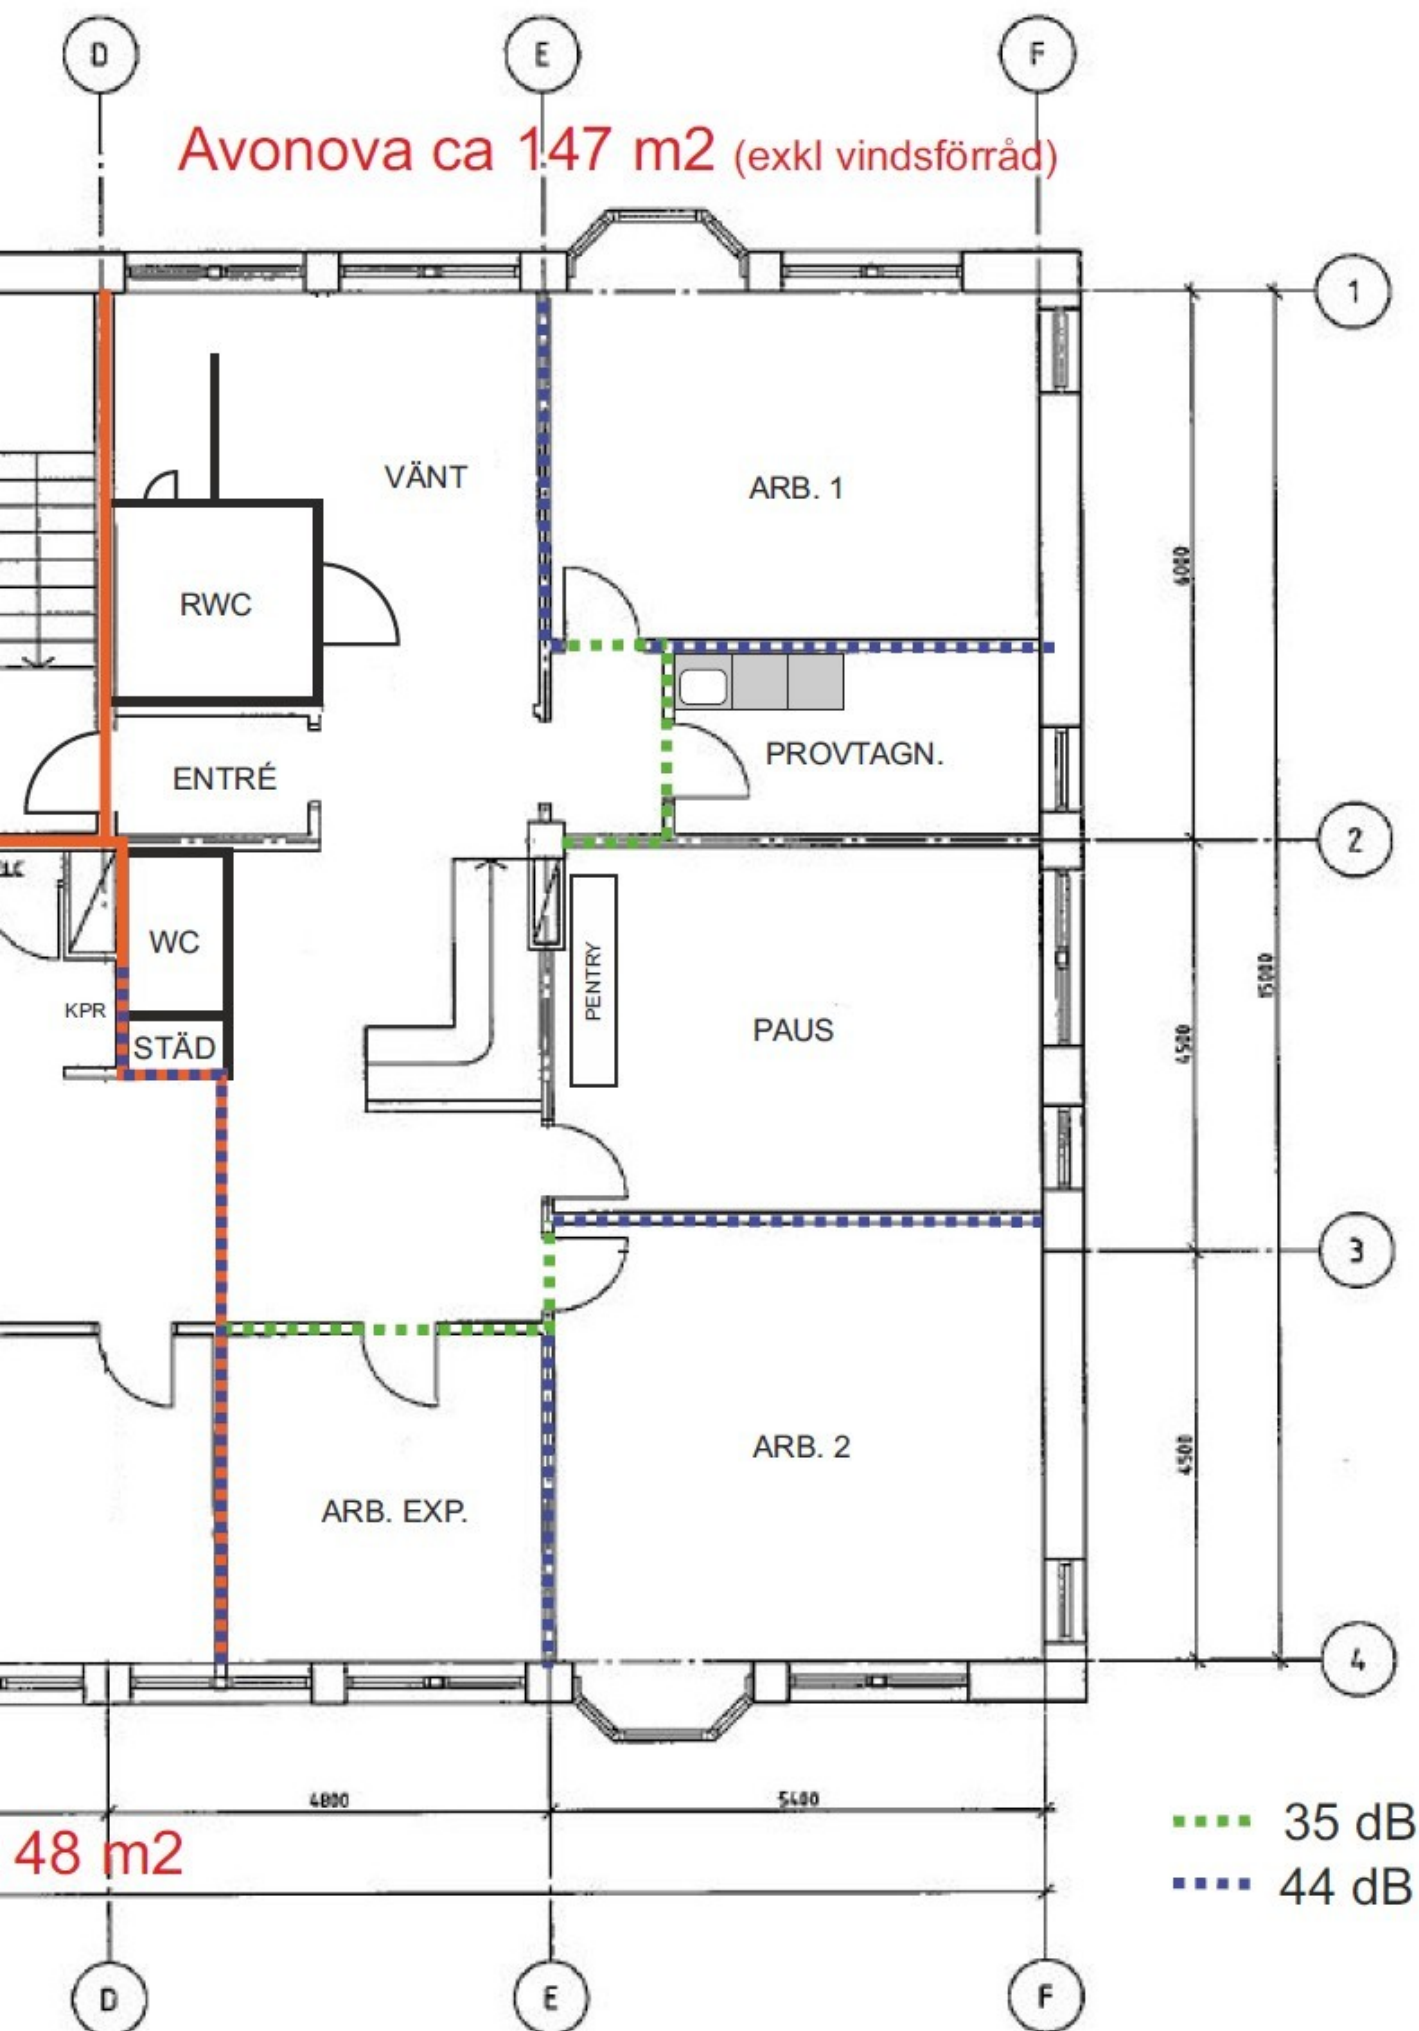

Plan 4