




1:200
METER, SKALA 1:200


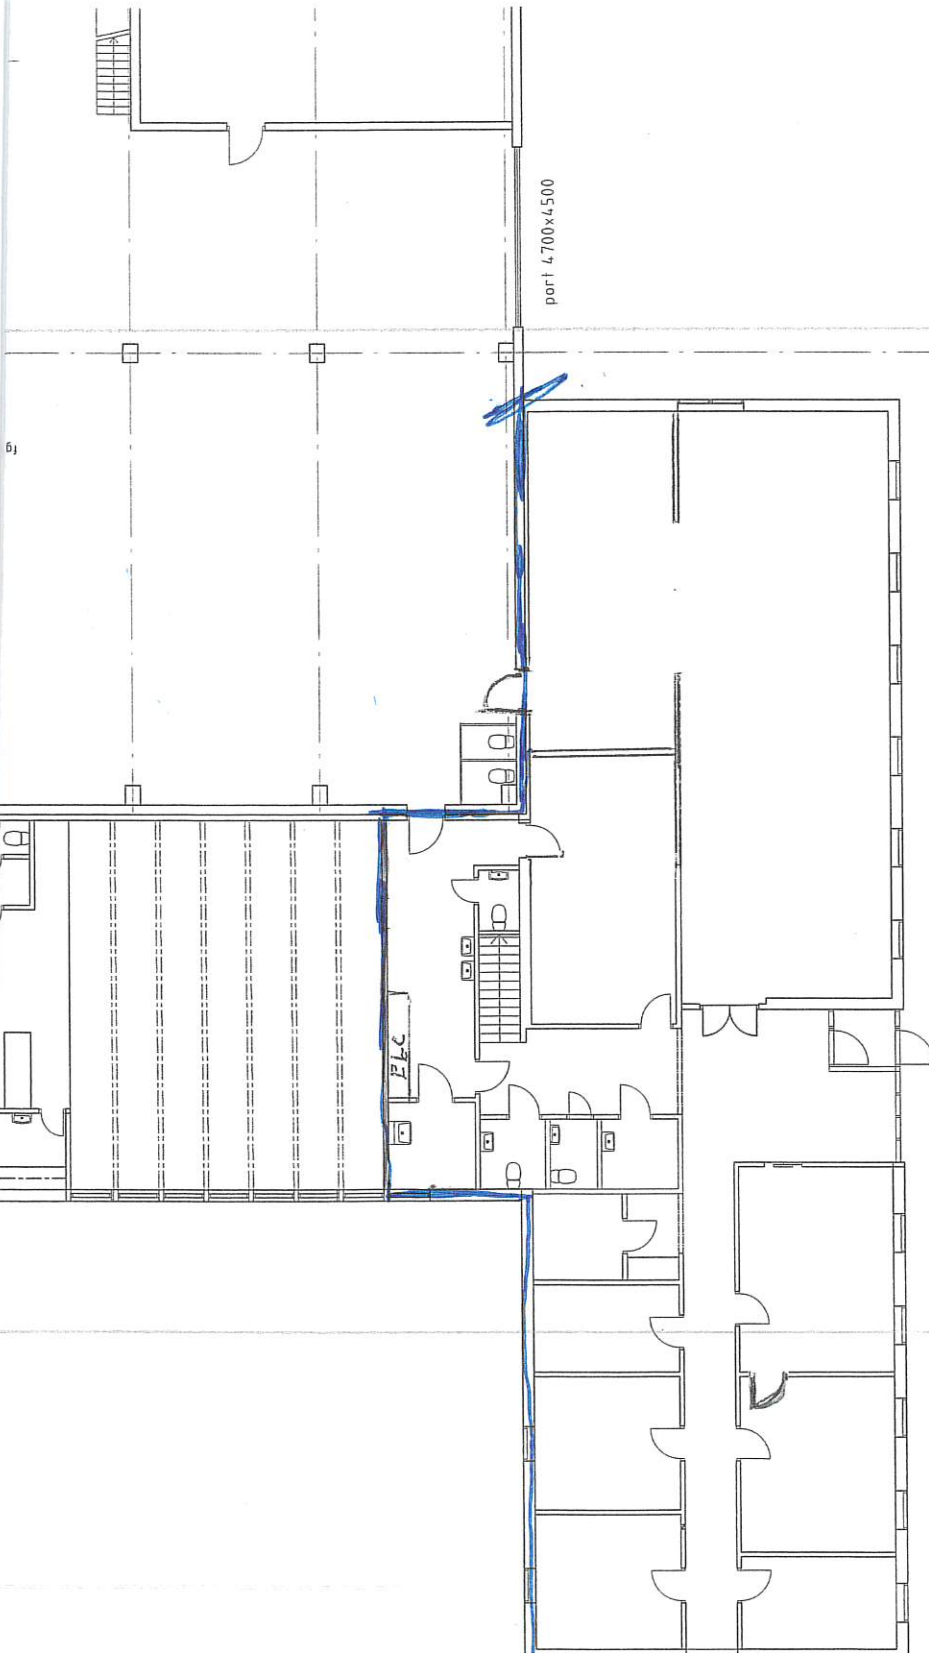

10