


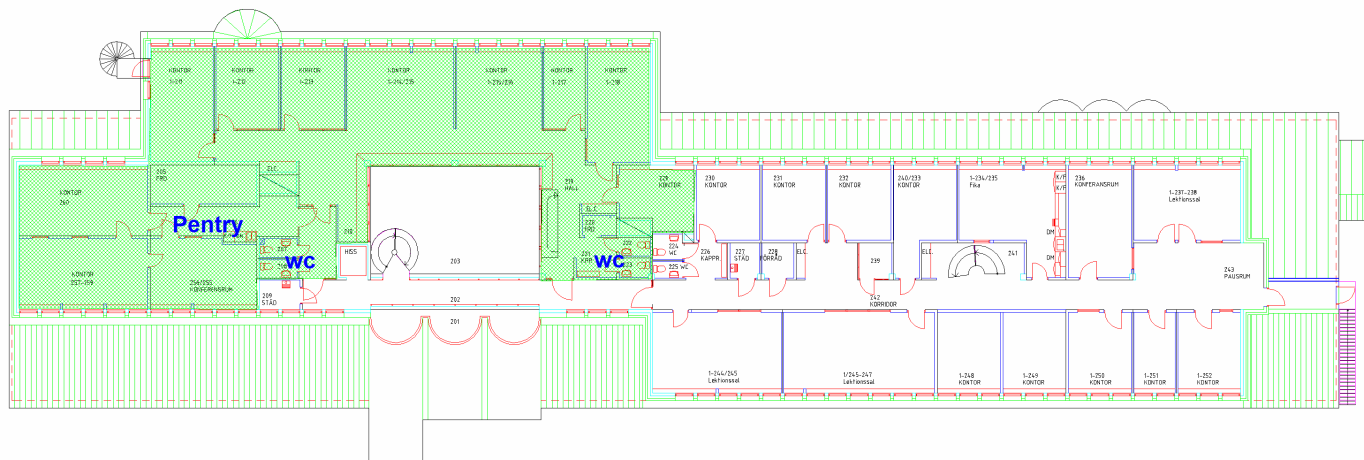

PLAN 2

D	SEFI söder	MMe	20180906
C	Ombyggnad SWL	MMe	20071217
B	Ombyggnad Cenara	MMe	20040120
A	Allmän revidering	MMe	20030401
Rev.	Revideringen avser	Sign.	Datum

RELATIONSRTNING

Soft Center

RONNEBY

1

Plan 2

Ritad Fogelberg	Datum 1987	Skala 1:200	Ritn.nr A:120	Rev. D
--------------------	---------------	----------------	------------------	-----------

