


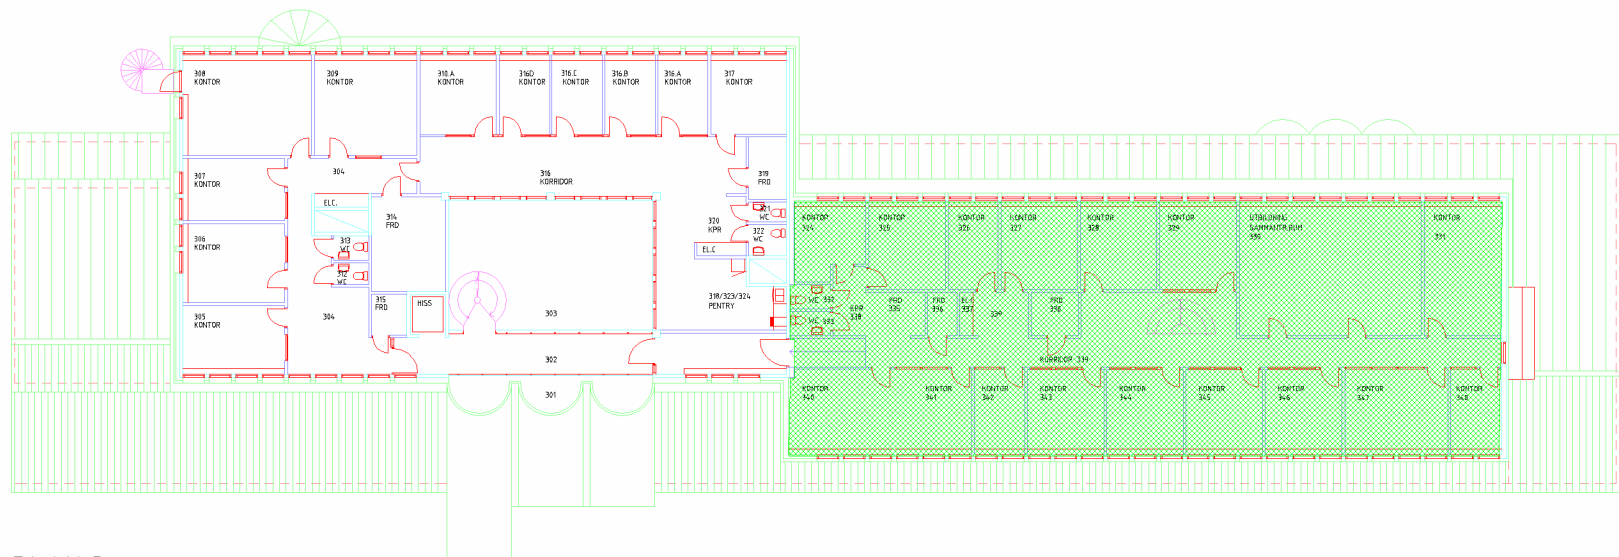

PLAN 3

B	NovaCast	MMe	20190401
A	Allmän revidering	MMe	20030401
Rev.	Revideringen avser	Sign.	Datum

RELATIONSRTNING

Soft Center

RONNEBY

1

Plan 3

Ritad Fogelberg	Datum 1987	Skala 1:200	Ritn.nr A:130	Rev. B
--------------------	---------------	----------------	------------------	-----------