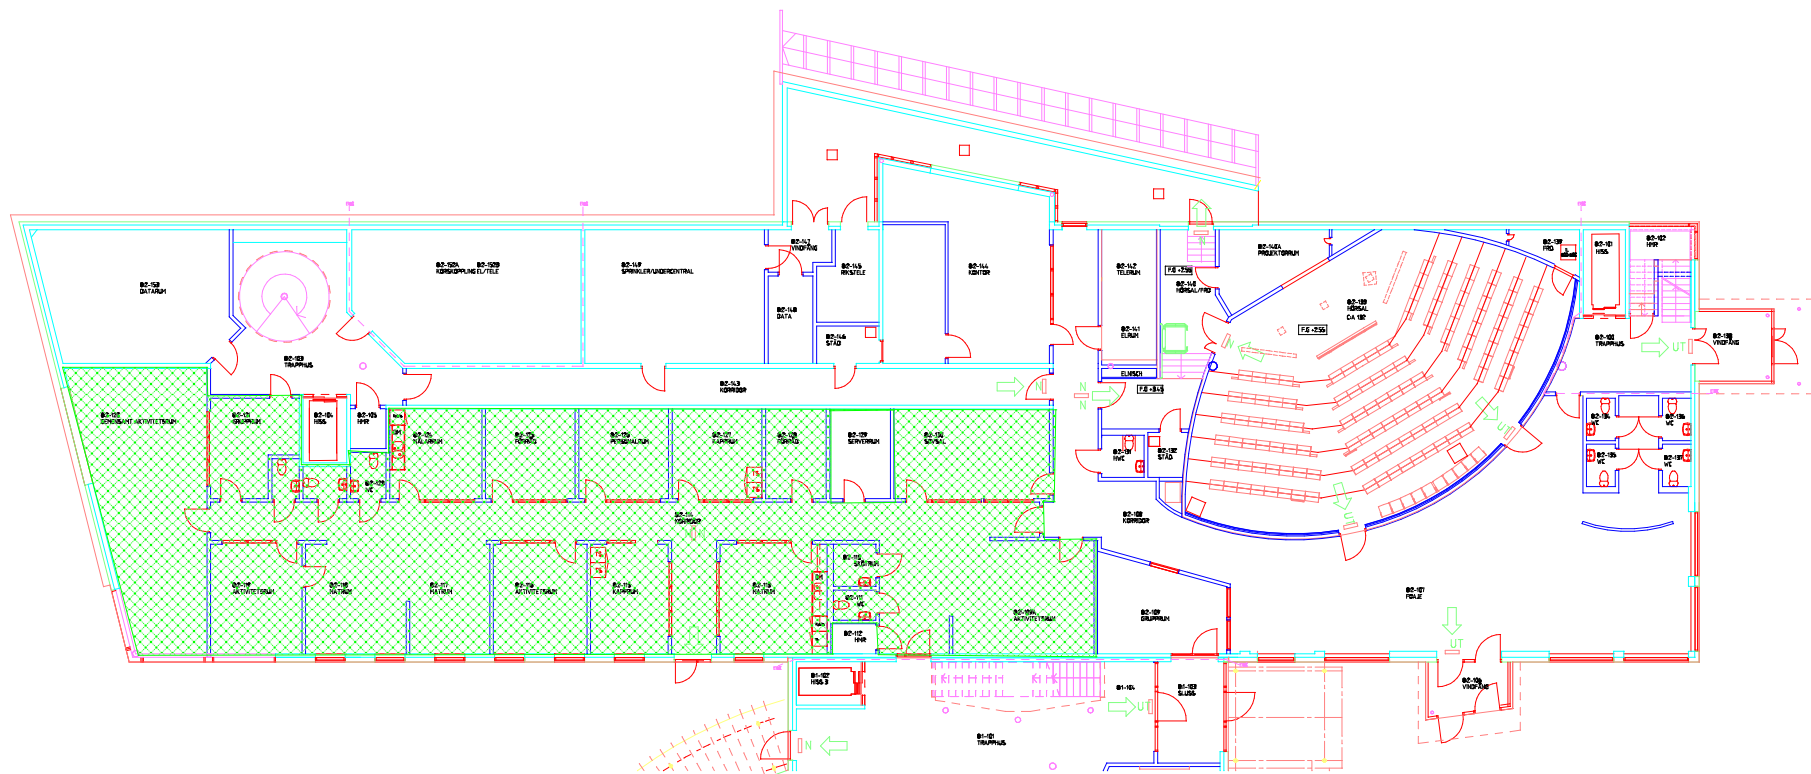


B	Fridhems Förskola	MMe	20160301
A	Allmän revidering	MMe	20030401
Rev.	Revideringen avser	Sign.	Datum

RELATIONSRTNING

Soft Center **8:2**
RONNEBY **Plan 1**

Ritad	Datum	Skala	Ritn.nr	Rev.
Fogelberg	2000	1:200	A 8:2 100	B