


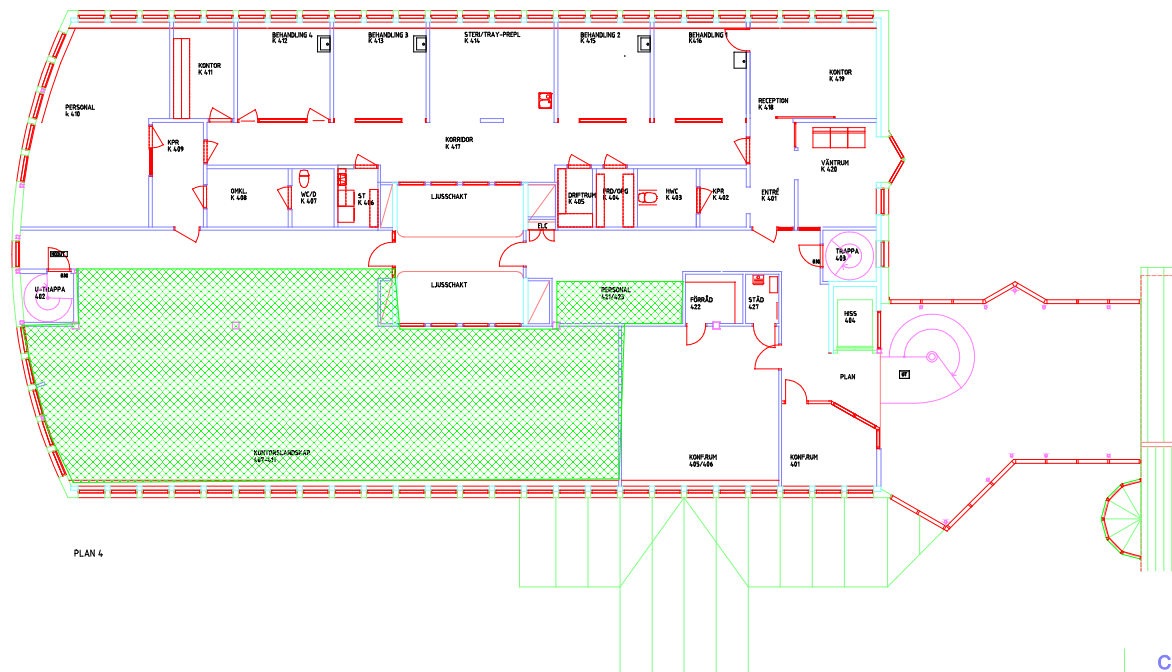

PLAN 4

C	Tandläkarna	MMe	20160101
B	Eniro	MMe	20070807
A	Allmän revidering	MMe	20030401
Rev.	Revideringen avser	Sign.	Datum

RELATIONSRTNING

Soft Center
RONNEBY

5

Plan 4

Ritad Fogelberg	Datum 1995	Skala 1:200	Ritn.nr A:540	Rev. C
--------------------	---------------	----------------	------------------	-----------