


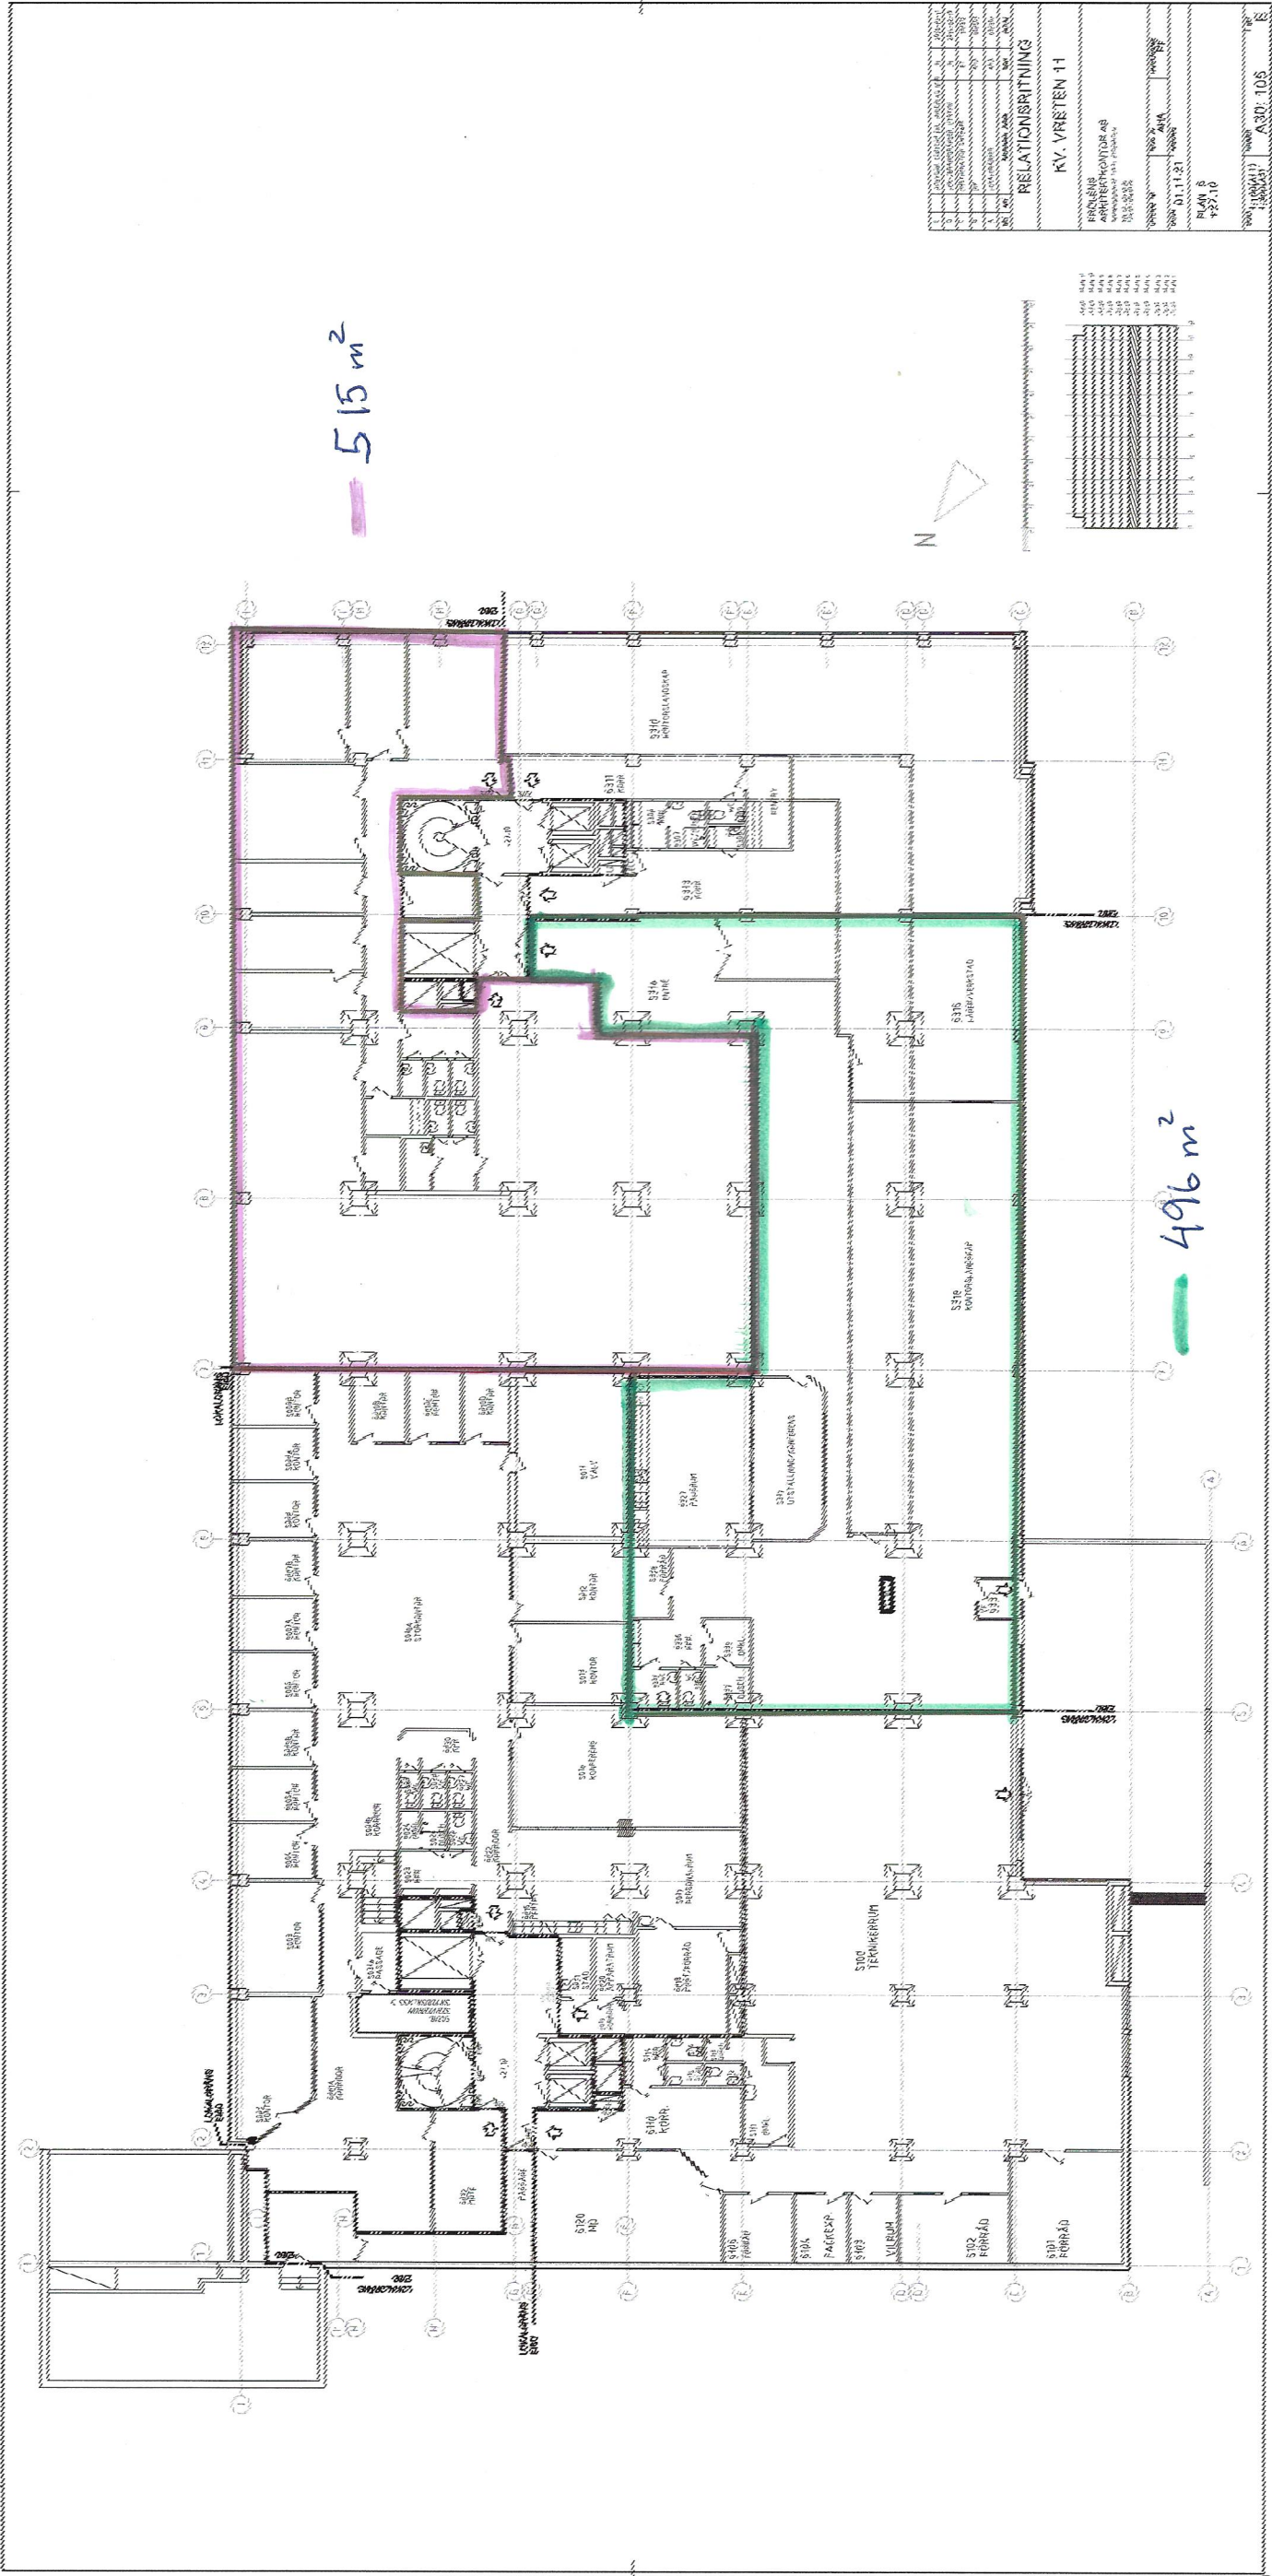

515 m²

496 m²

RELATIONSBITNING		KV. VRETN 11	

