

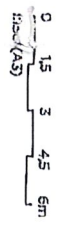


KV. EKEN 3, SUNDBYBERG
Plan 4
445 kvm

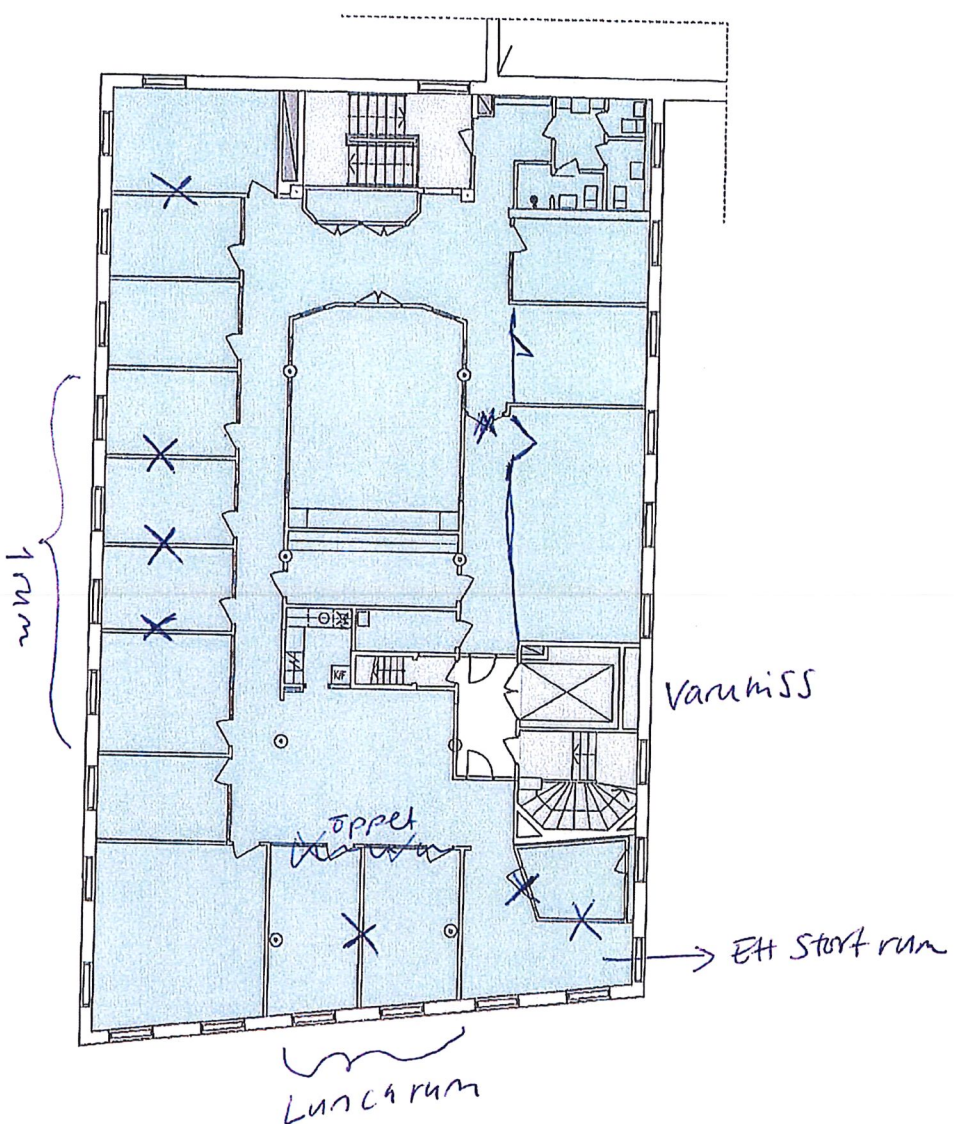

KV. EKEN 3, SUNDBYBERG
Skala 1:150 (A3)
2021-06-14

Studio Stockholm
Arkitekt

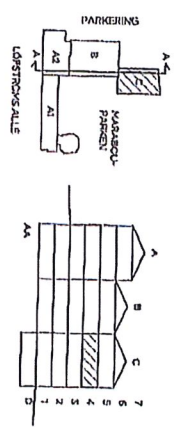

ATRUM LUNDBERG