


Lokal 4
459 kvm

Industrivägen 14, Tyresö

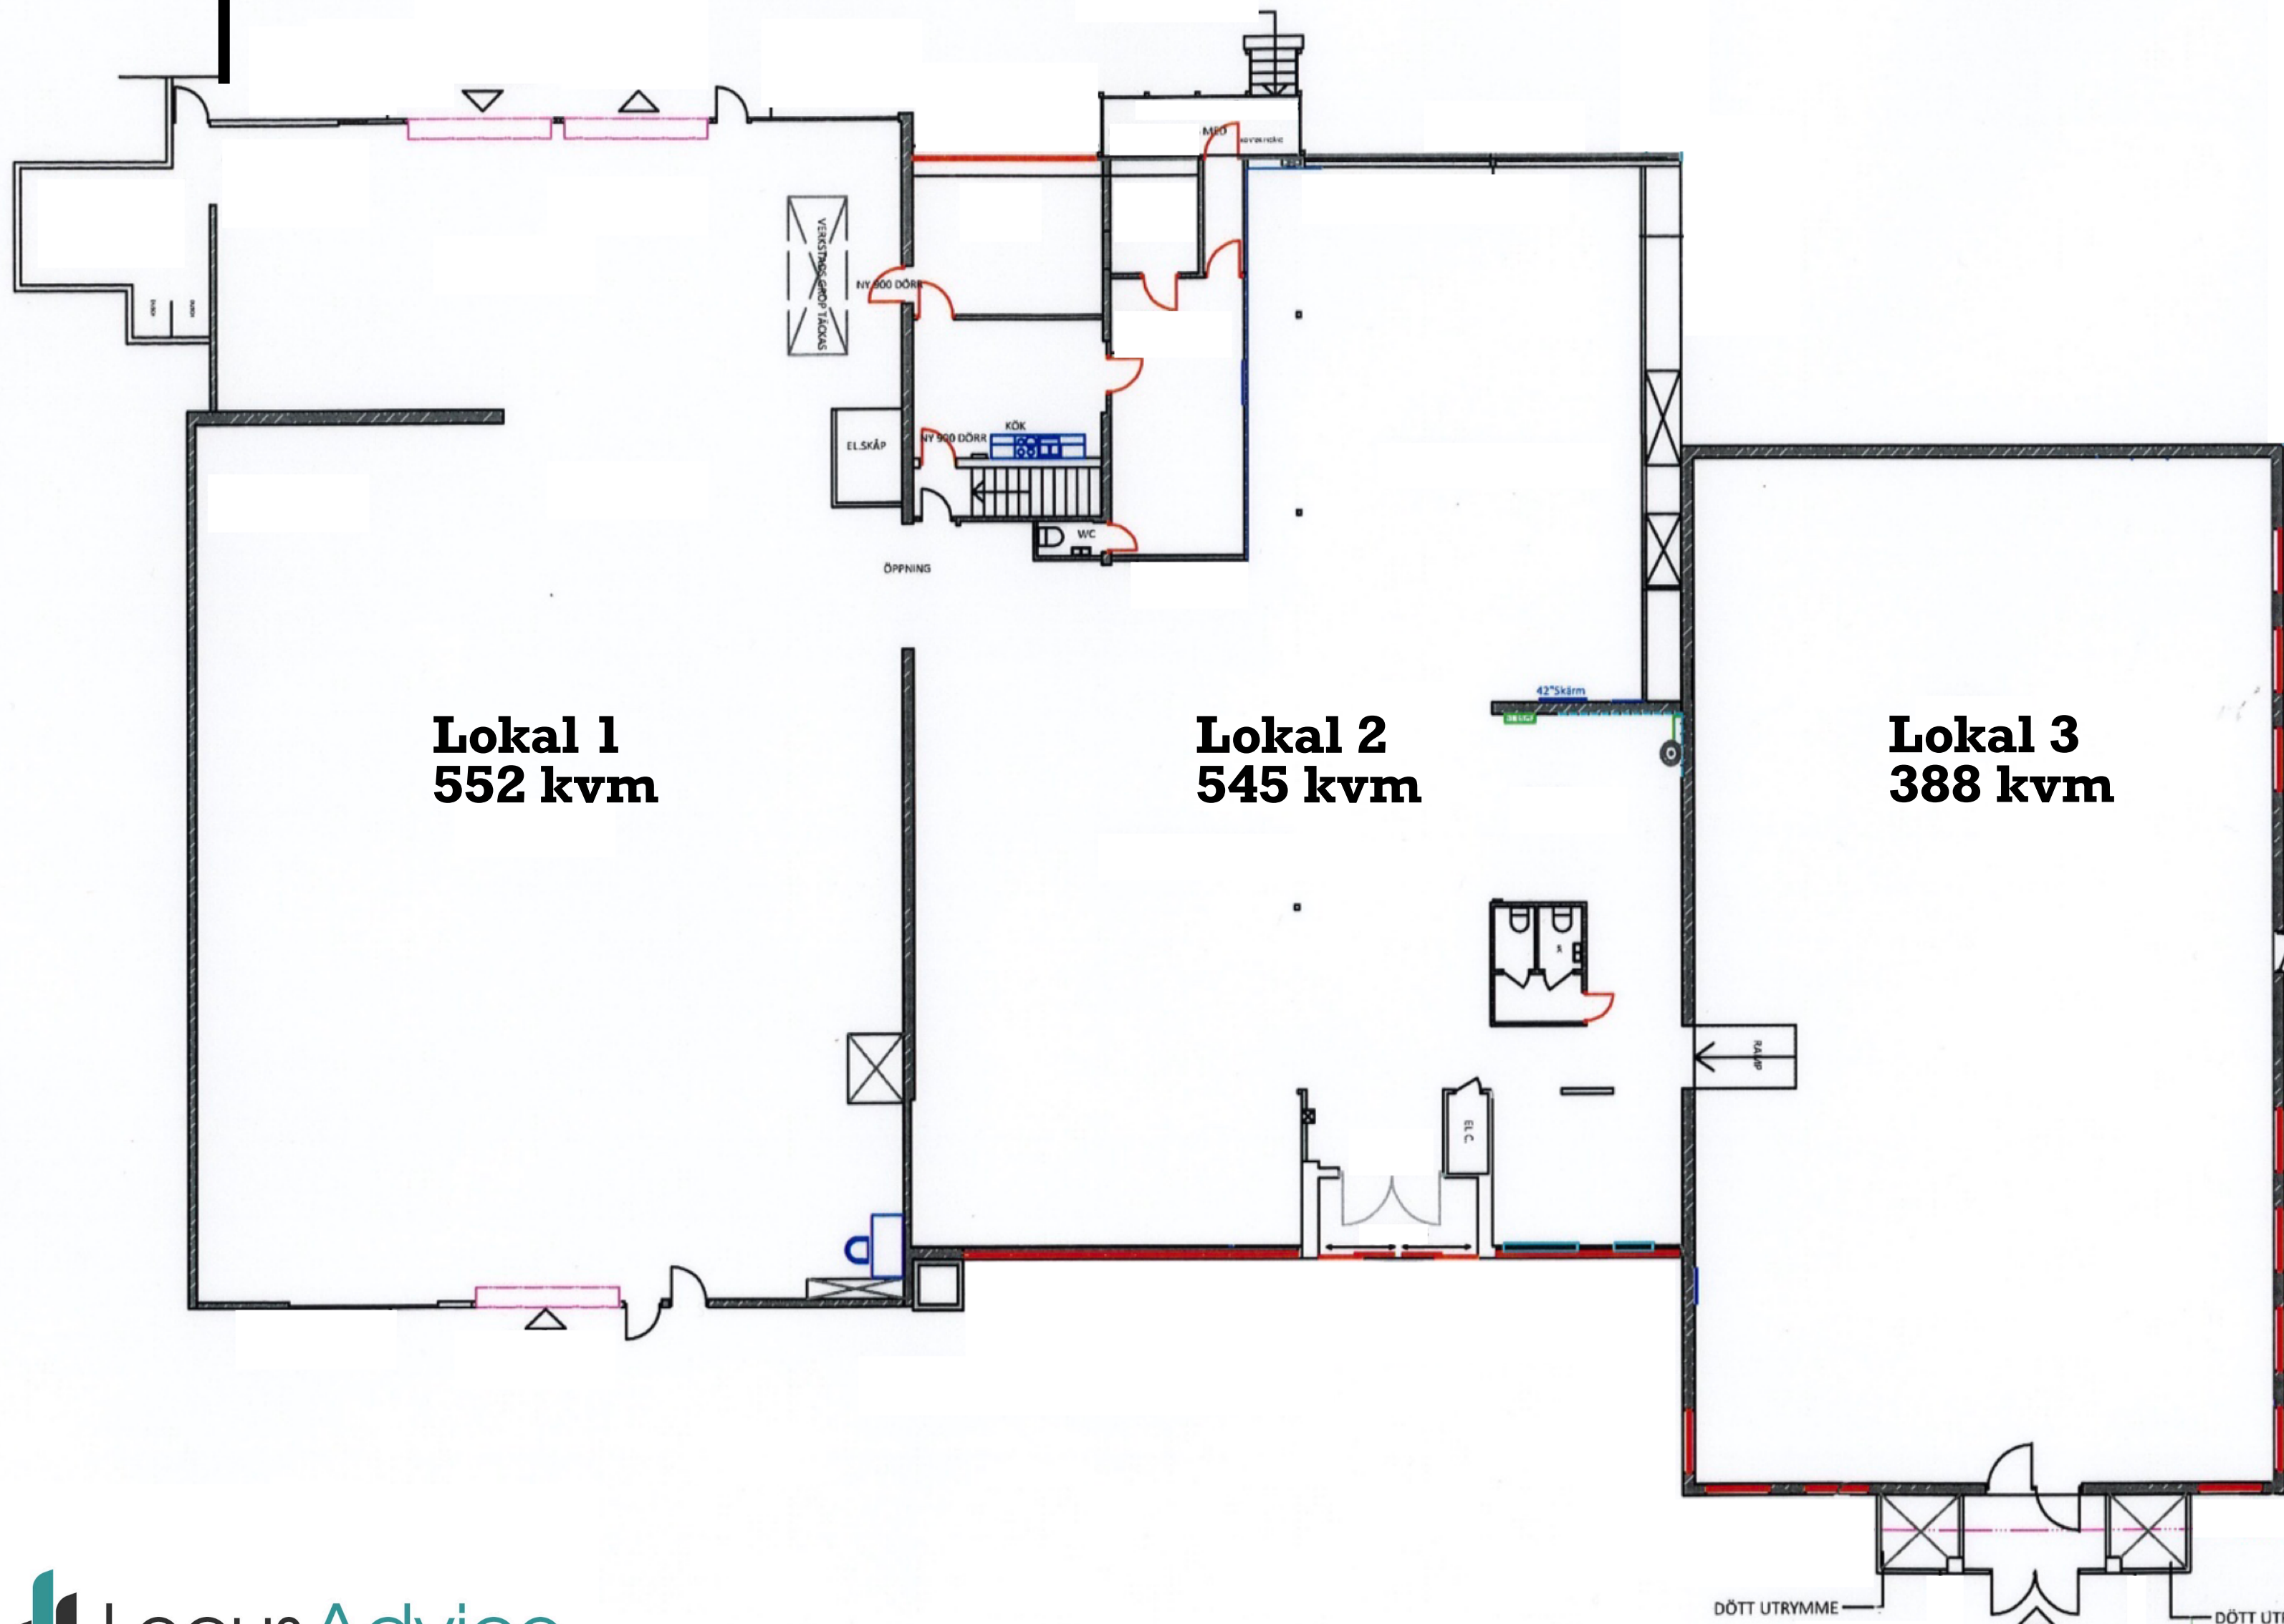

Lokal 1
552 kvm

Lokal 2
545 kvm

Lokal 3
388 kvm