



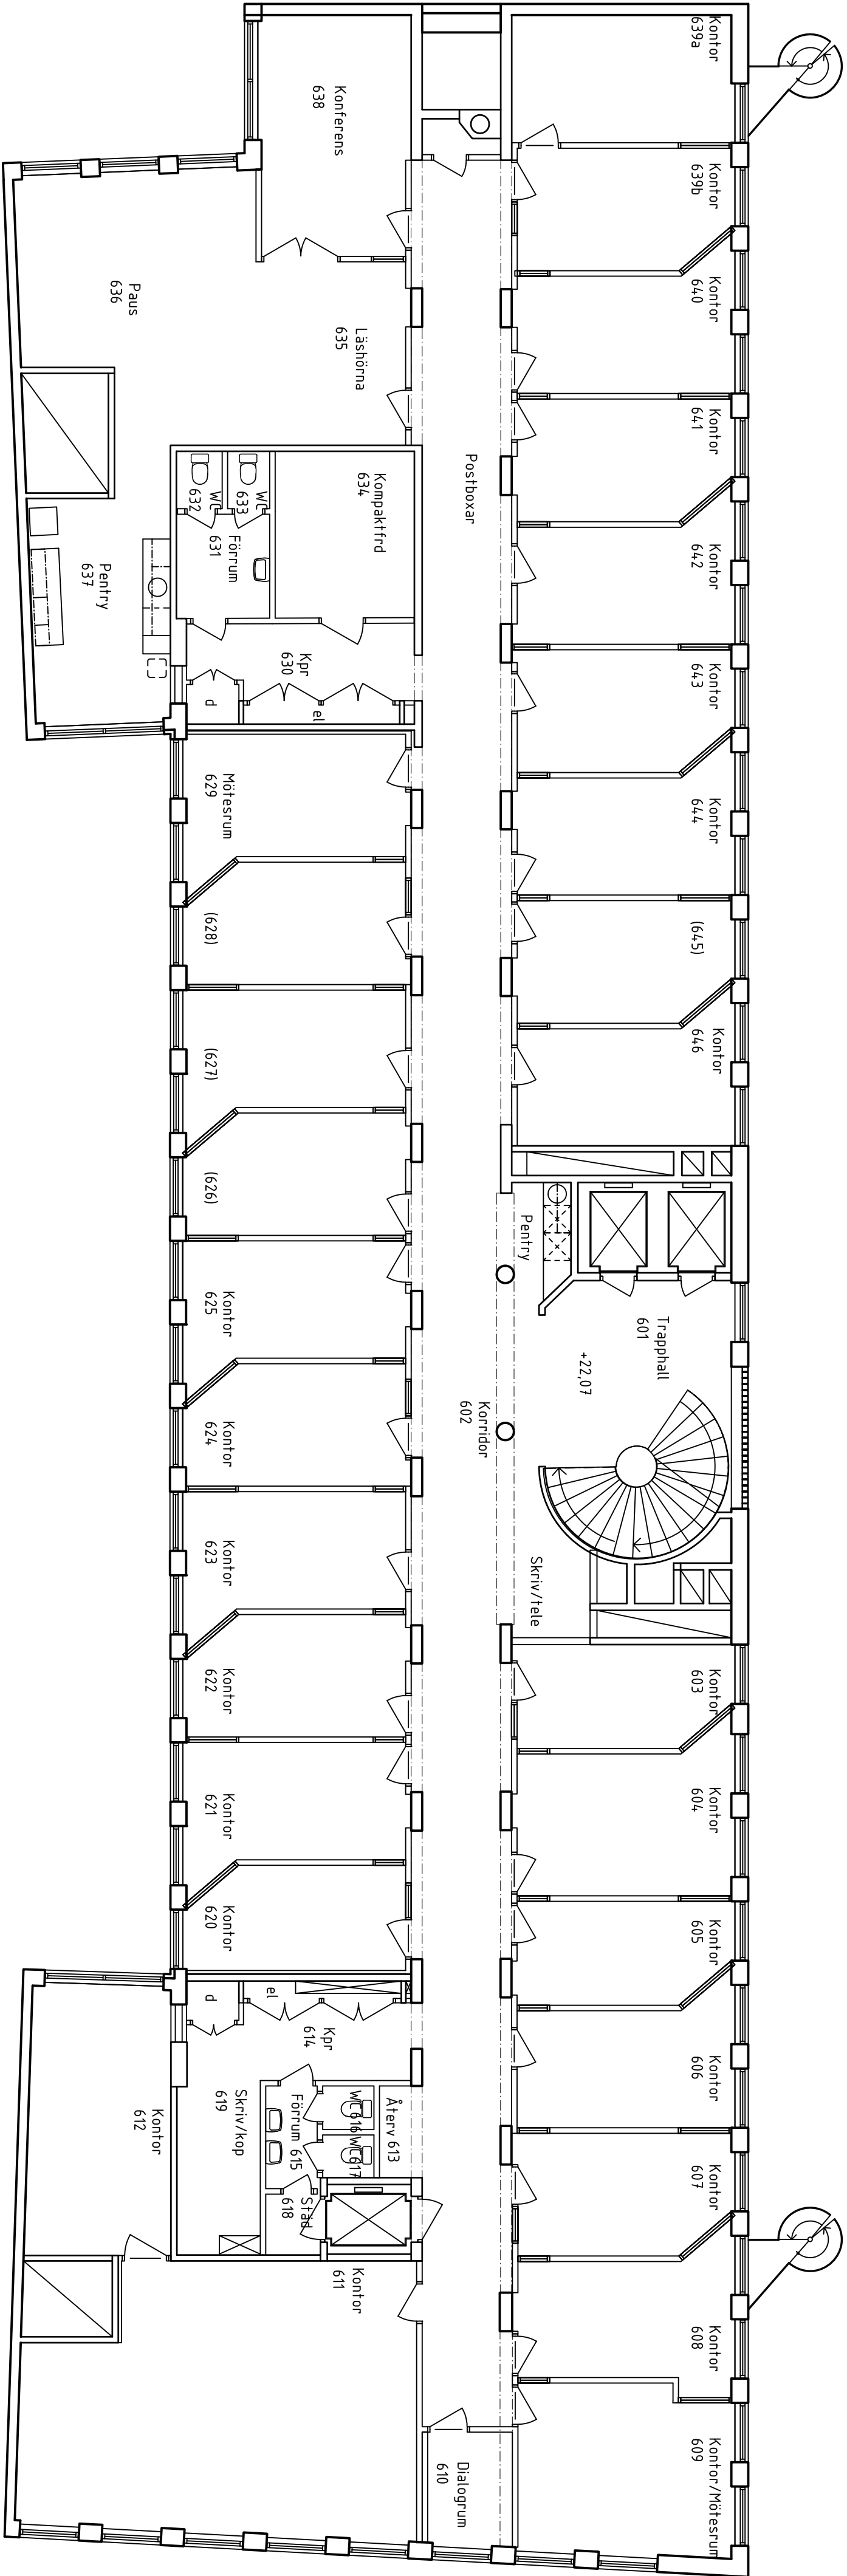

GULDFISKEN 31
PLAN 03, 3tr

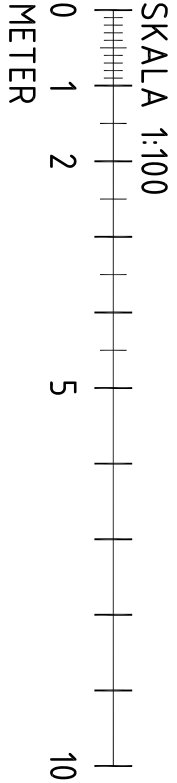

REF:	LAGER: SB11
RELATIONSRTNING	
BET: ANDRINGSKÄR	SKALA
RELATIONSRTNING	
OBJEKT NR: 1009	PROJEKT NR: 1009
PROJEKTLEDARE: FREDRIKA	
20.01.29	
GULDFISKEN 31	
NYBROGATAN 55	
PLAN 03 3tr	
SKALA: 1:100 (A3) 1:200 (A4)	
REF:	

GULDFISKEN 31	
NYBROGATAN 55	
PLAN 03 3tr	
SKALA: 1:100 (A3) 1:200 (A4)	
REF:	