


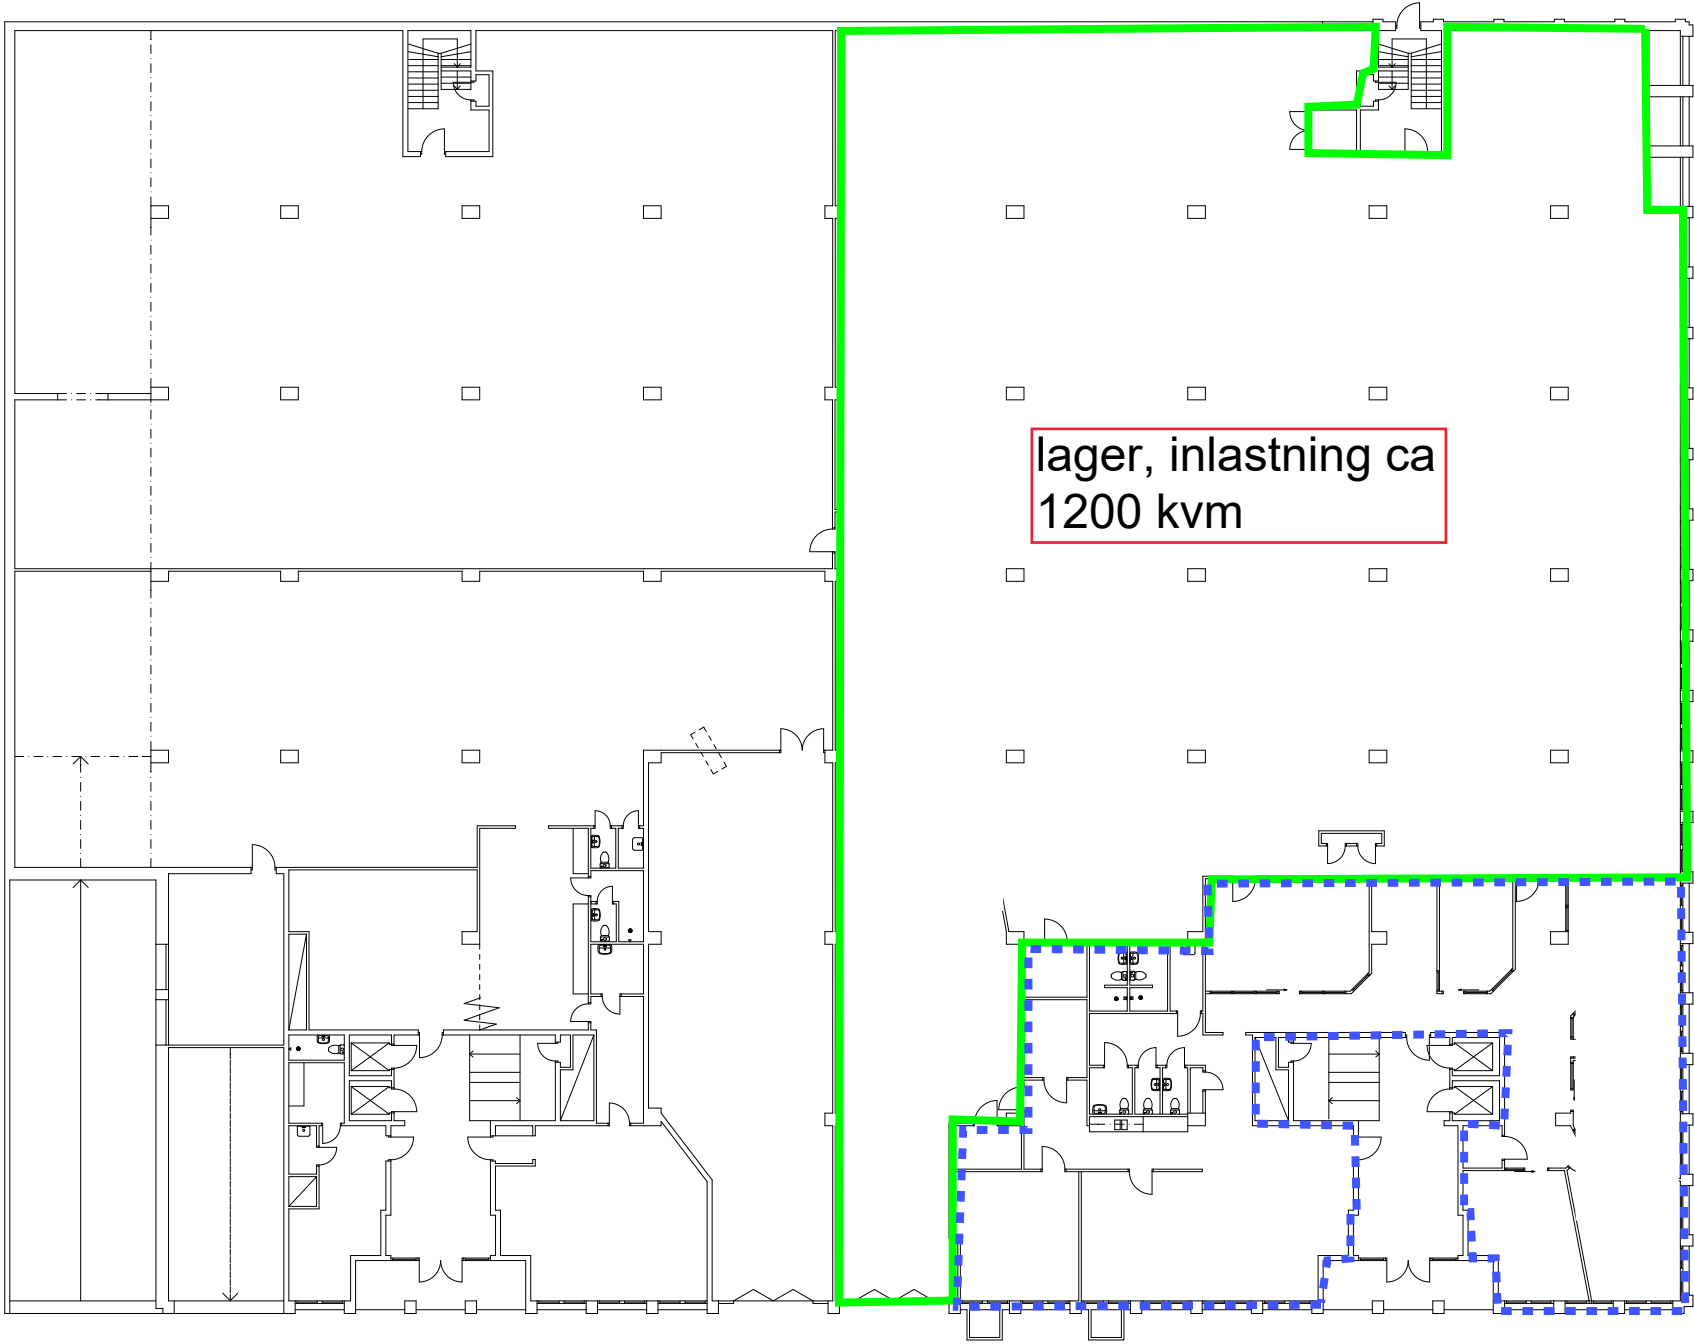

lager, inlastning ca
1200 kvm

kontor ca 390 kvm

BET	ANT	ÄNDRINGEN AVSER	DATUM	SIGN
-----	-----	-----------------	-------	------

RELATIONSRTNING 120309

gws arkitekter

FOLKUNGGAGATAN 53 116 22 STOCKHOLM T. (08) 6416110 F. (08) 6416107
WWW.GWSK.SE

DATUM	RITAD AV	ANSVARIG ARKITEKT
	JH	T KARASALO

KV PROVÖRET 15, STHLM
Instrumentvögen 29 - 31

PLAN BV

SKALA	A1: 1:150 A3: 1:300	NUMMER	A30:02	BET
-------	------------------------	--------	--------	-----