


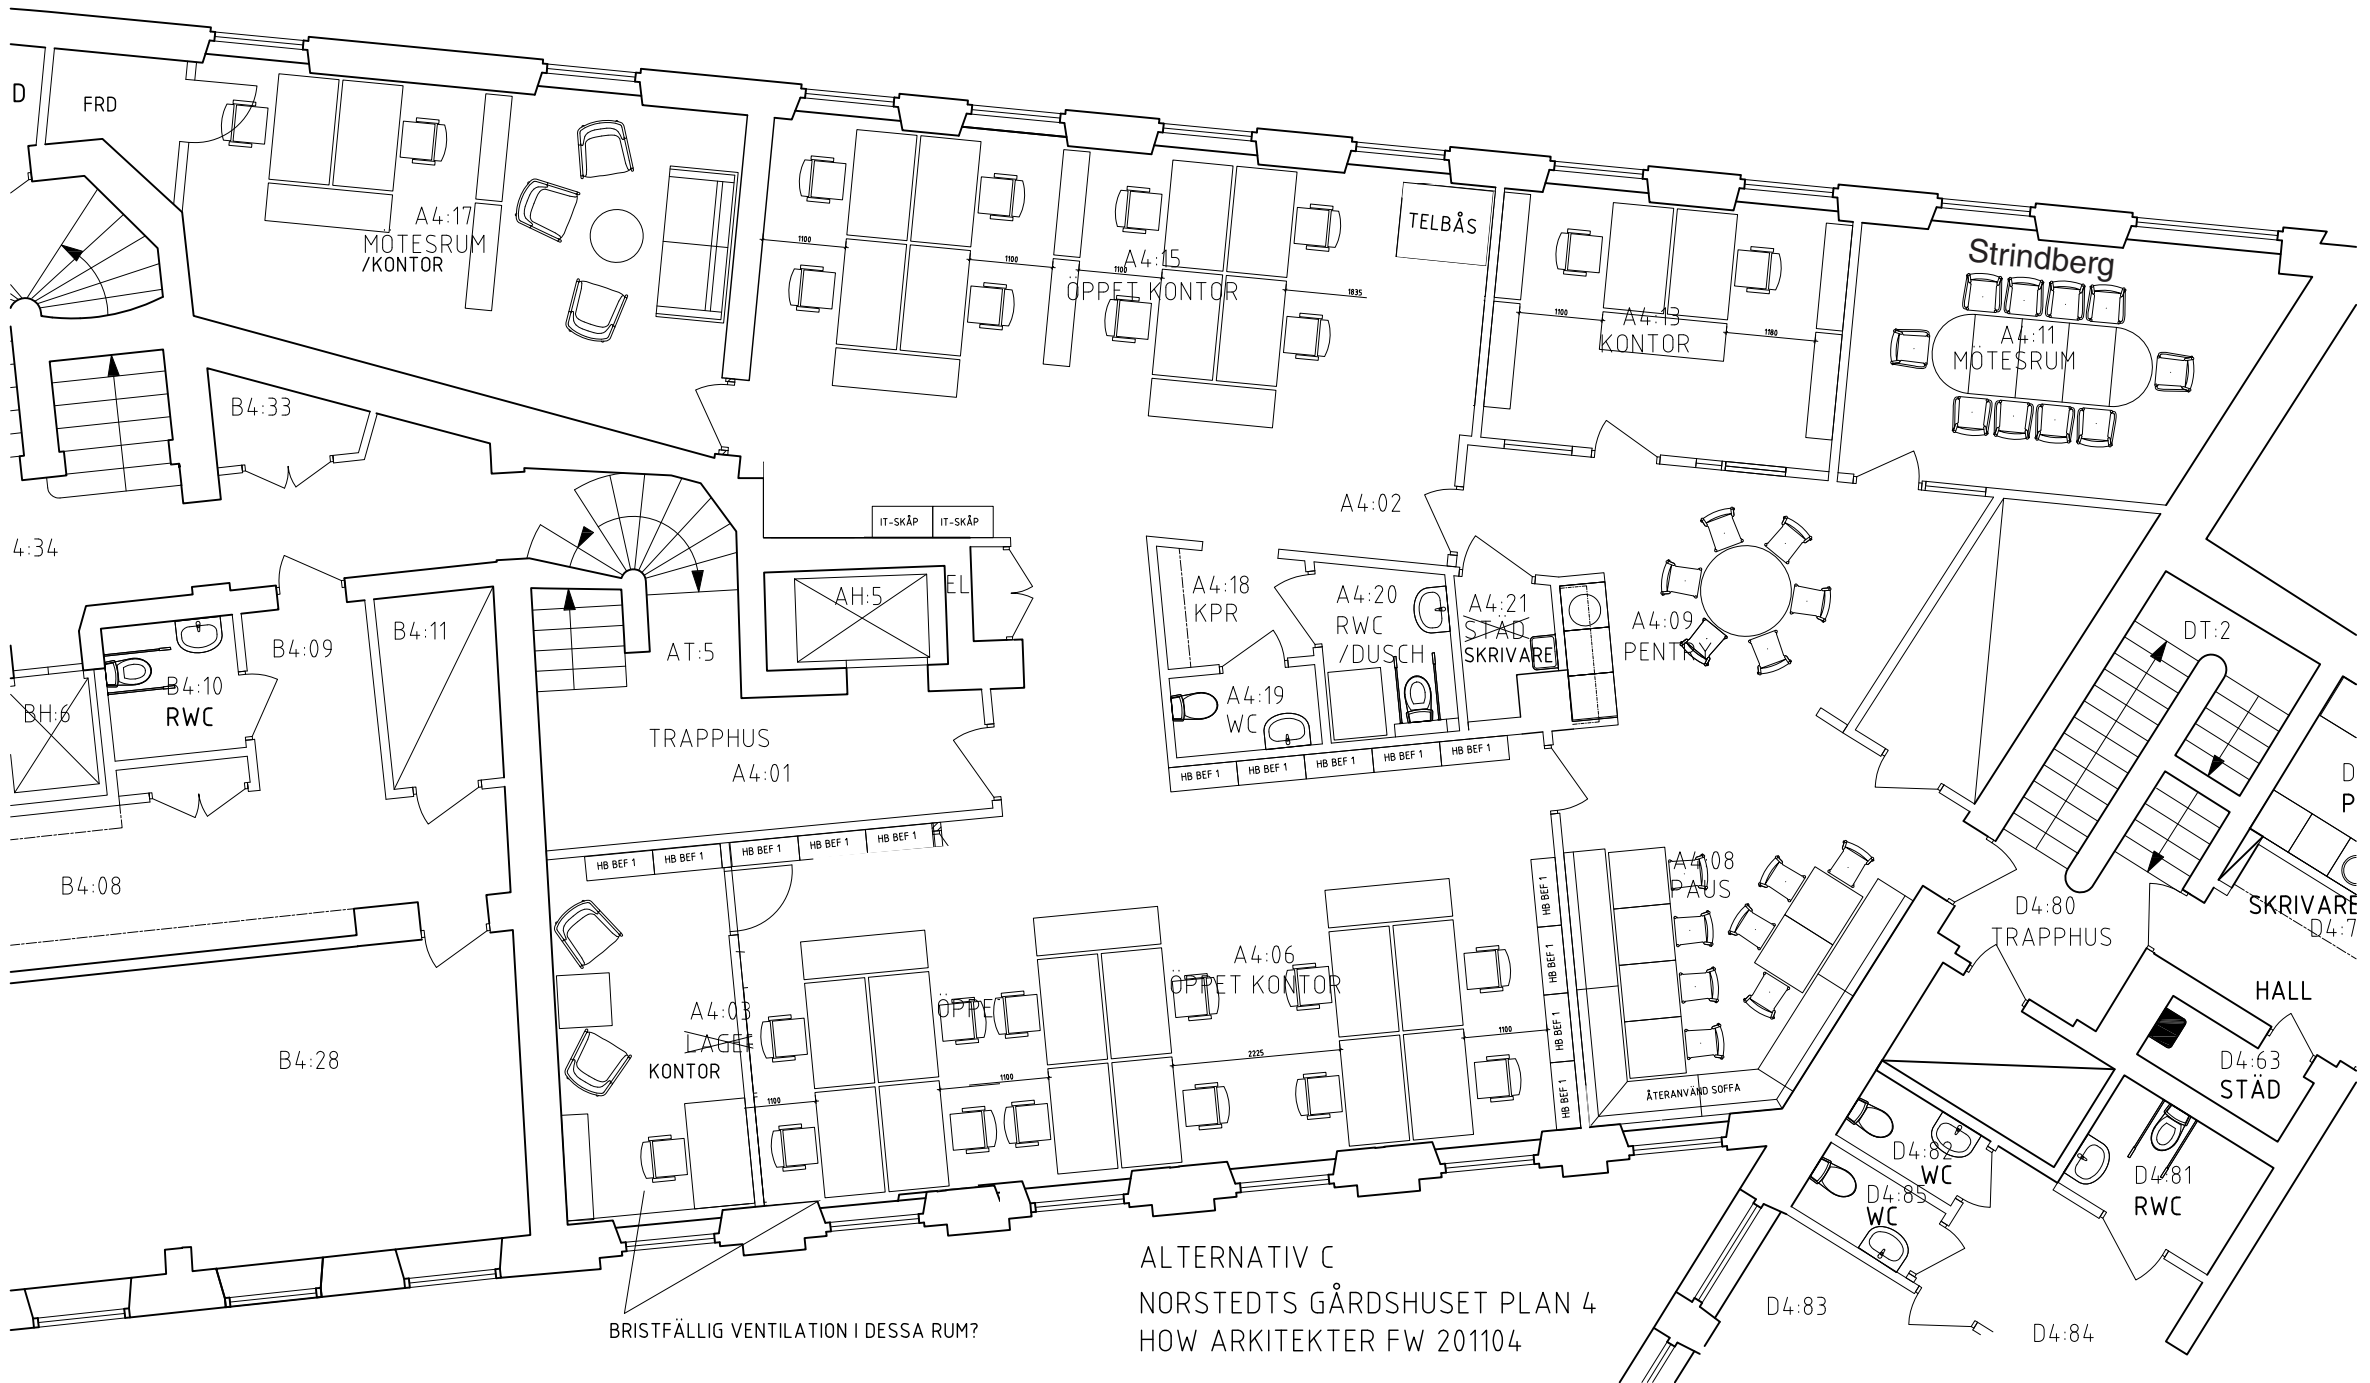

BRISTFÄLLIG VENTILATION I DESSA RUM?

ALTERNATIV C
NORSTEDTS GÅRDSHUSET PLAN 4
HOW ARKITEKTER FW 201104