


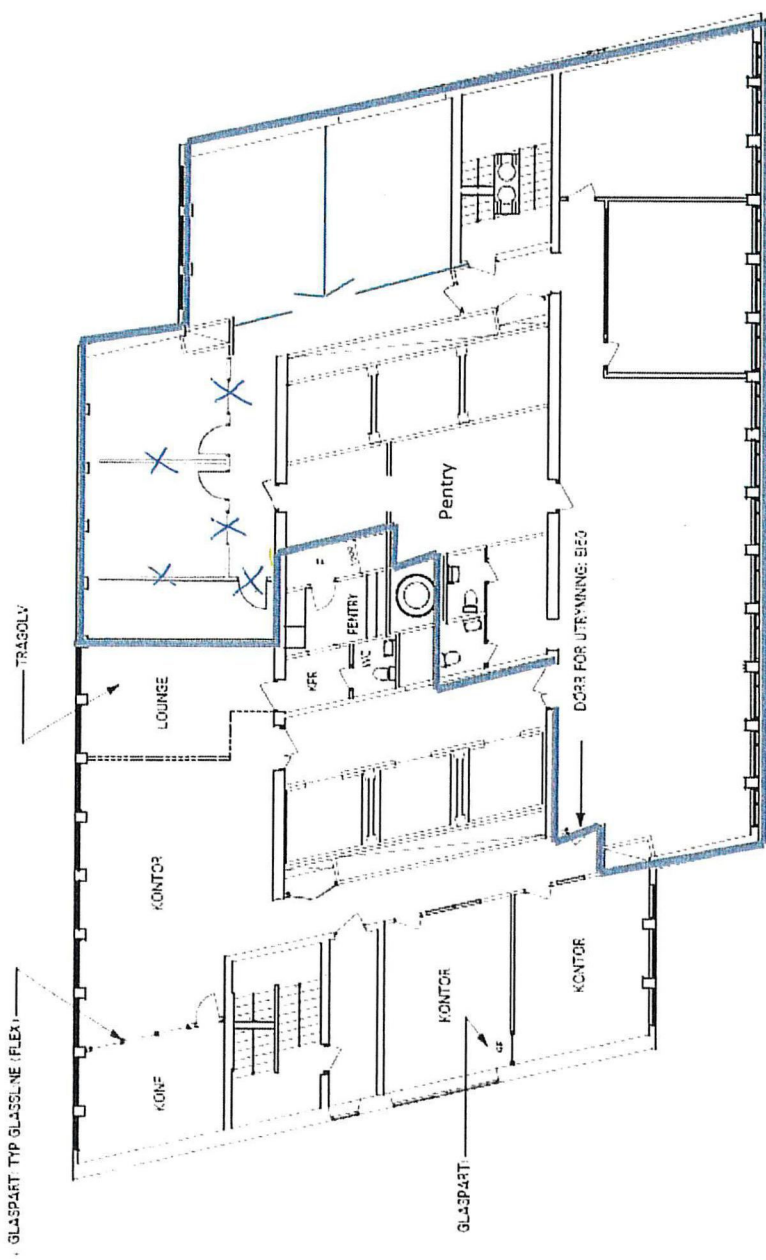

Megaron arkitekter AB

KV ORMTRÄSKET • PLAN 1 •

Fabege

*Handwritten signature and date '21'.*