


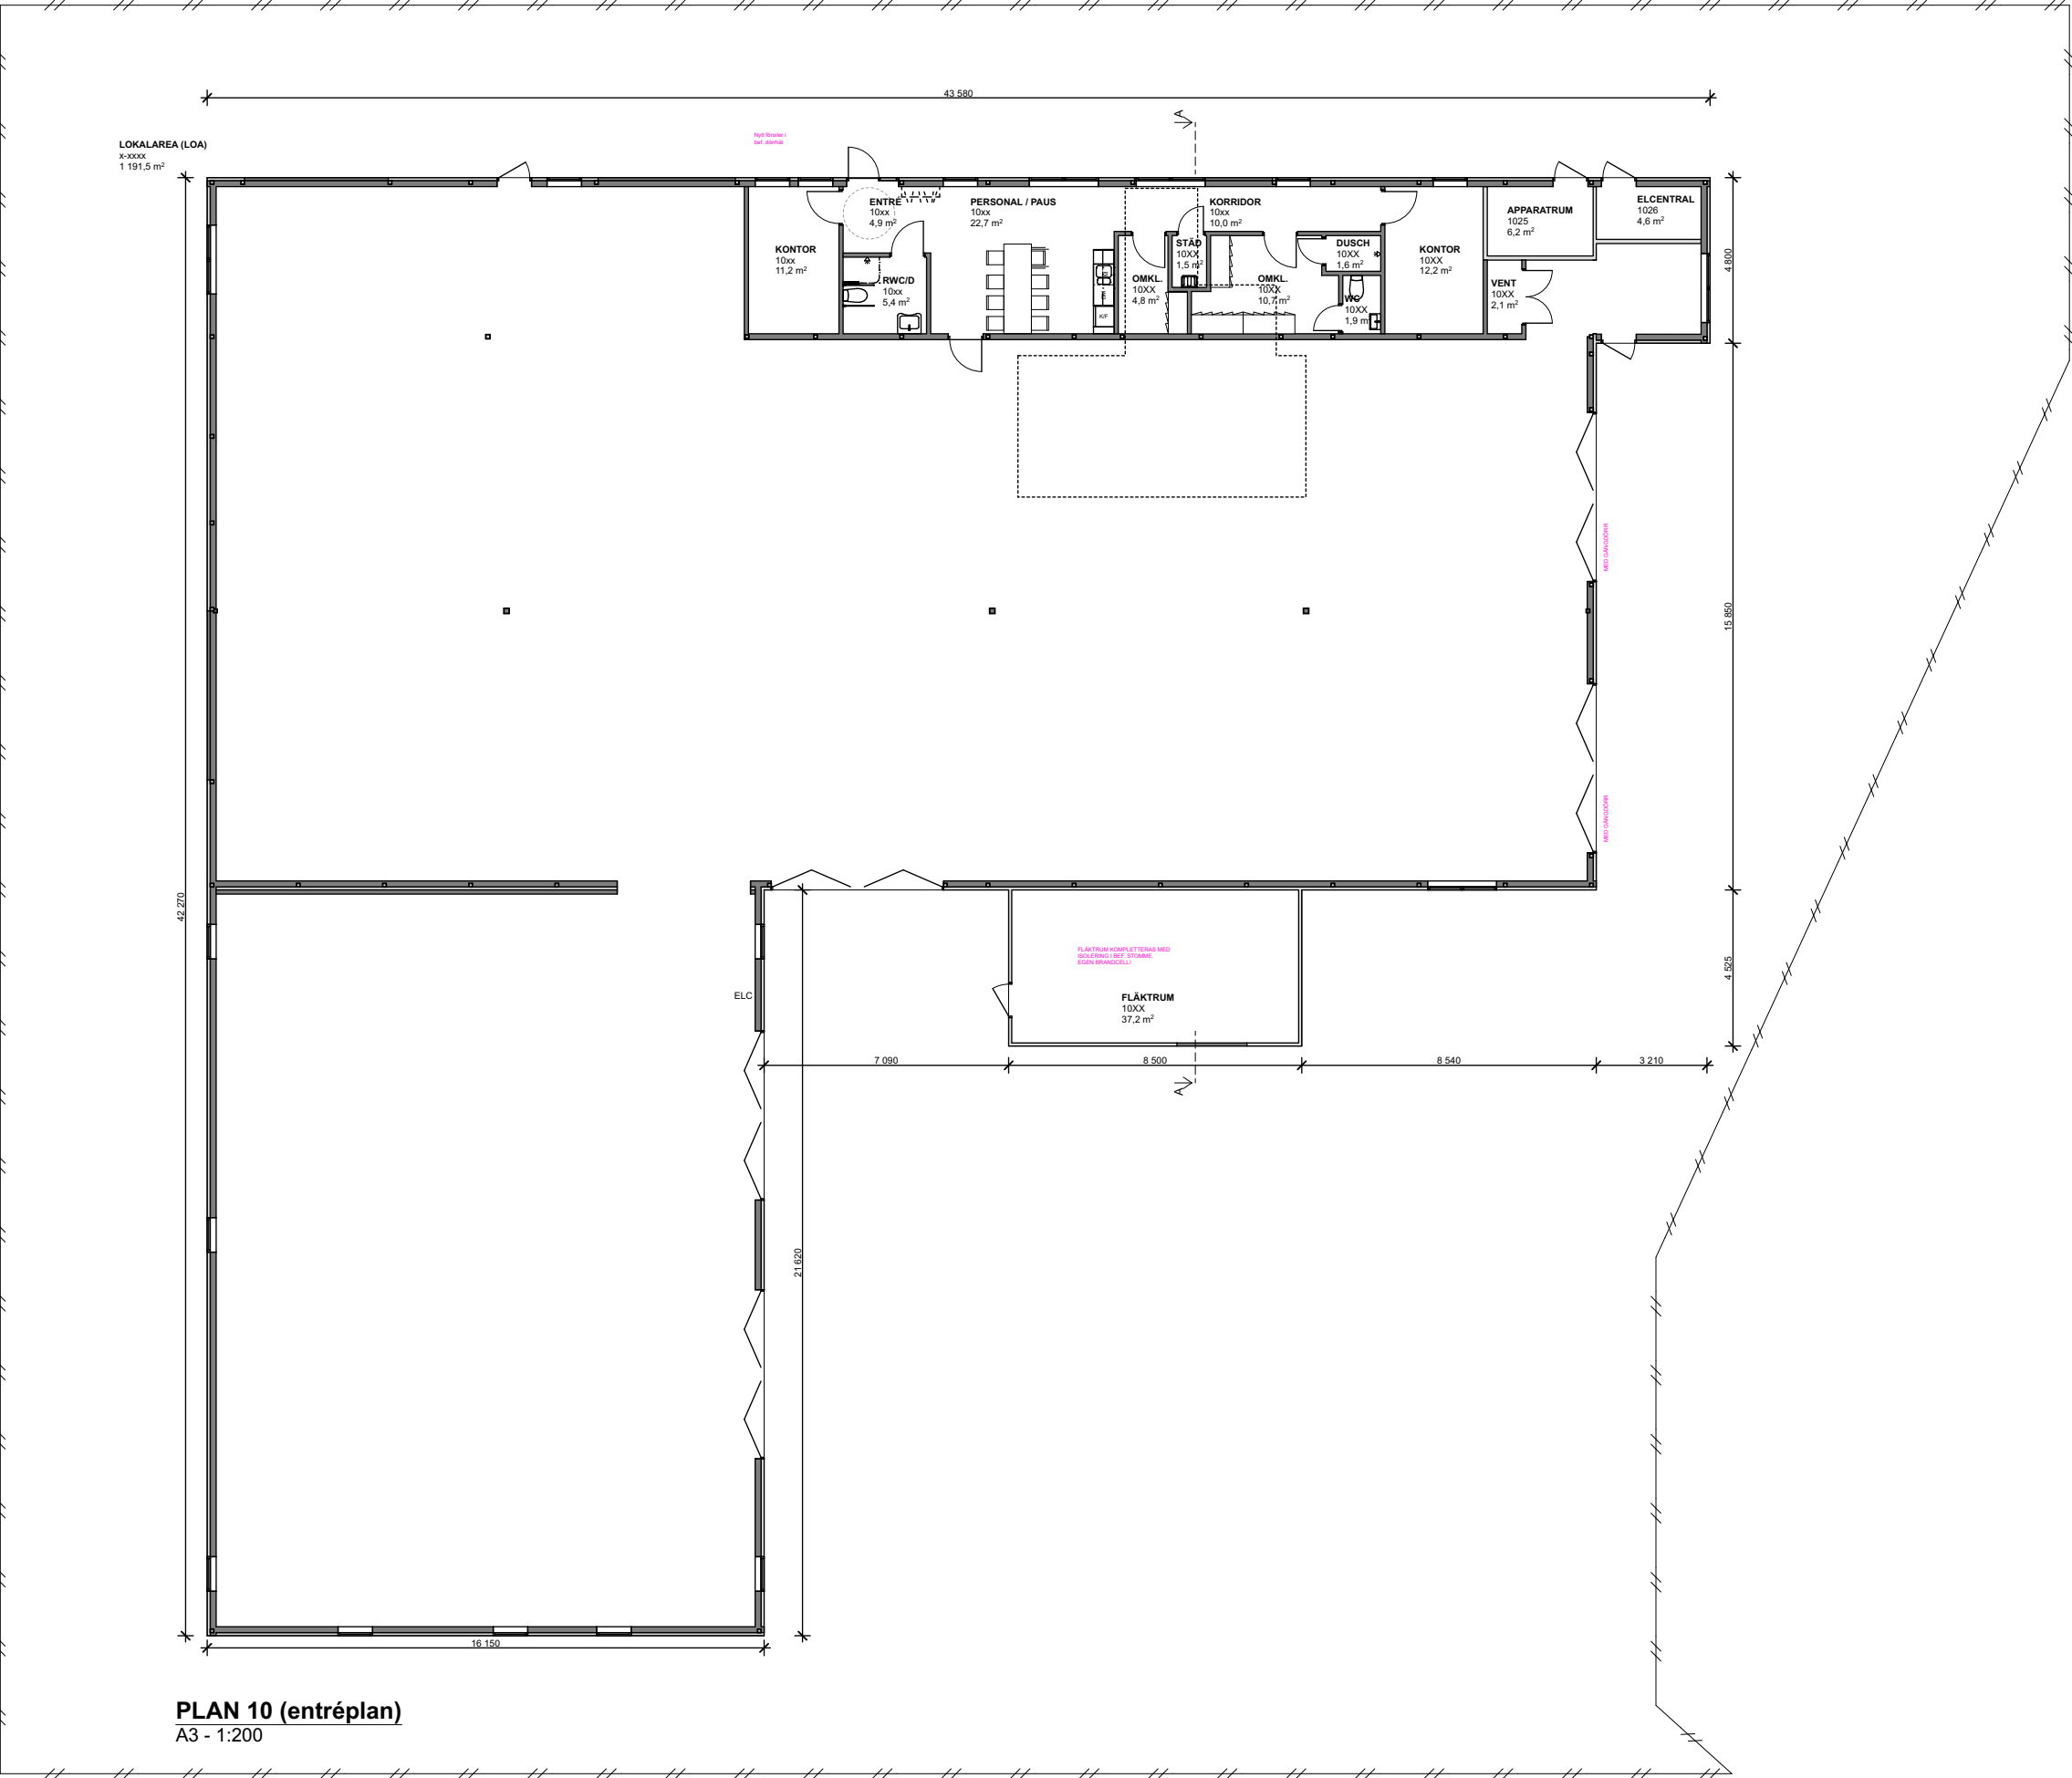

PLAN 10 (entréplan)
A3 - 1:200

