


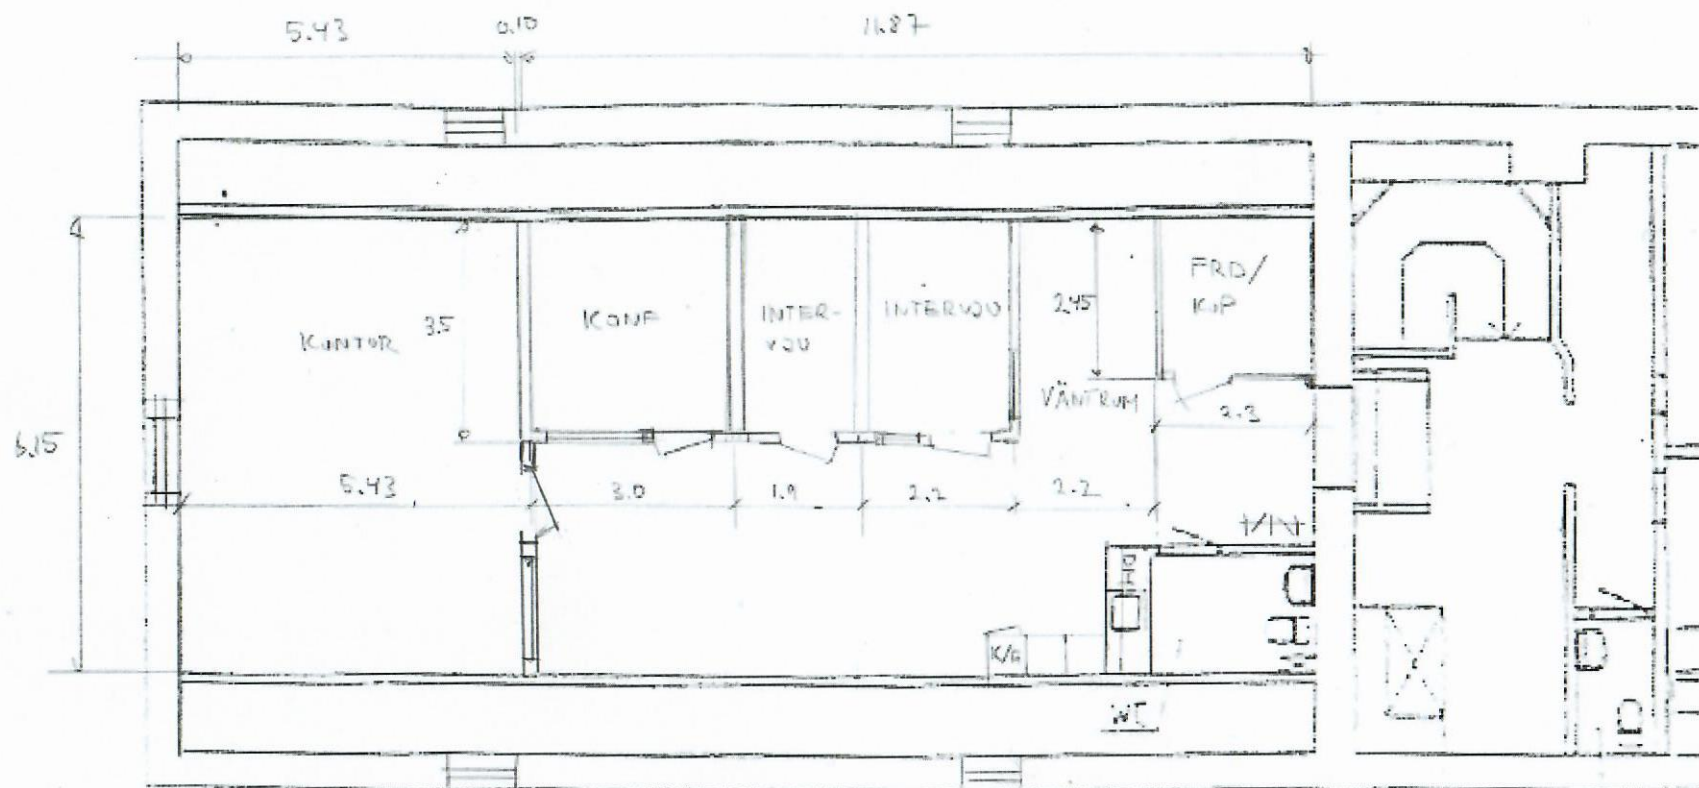

Plan 3

1:100

F10S3

1:100