


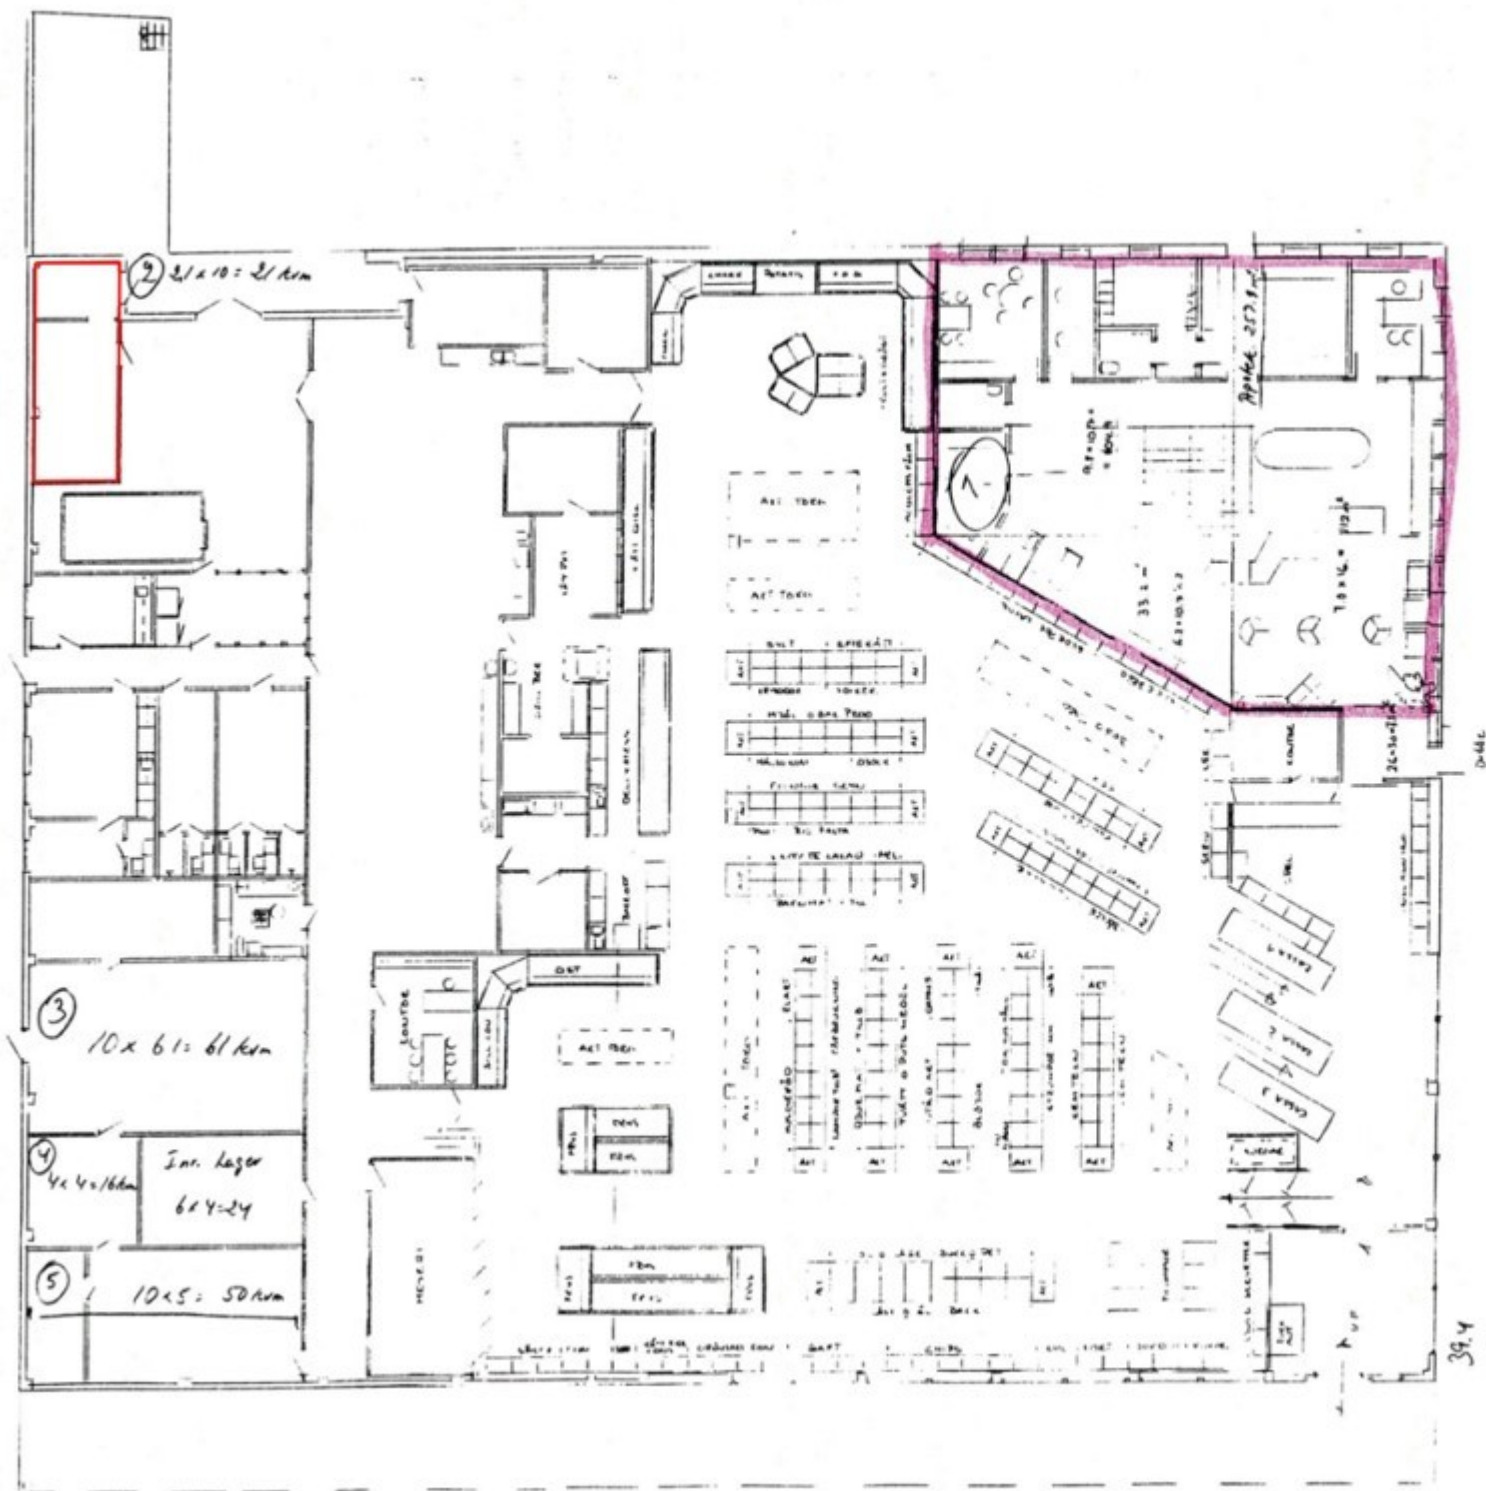

EMILSHUS