



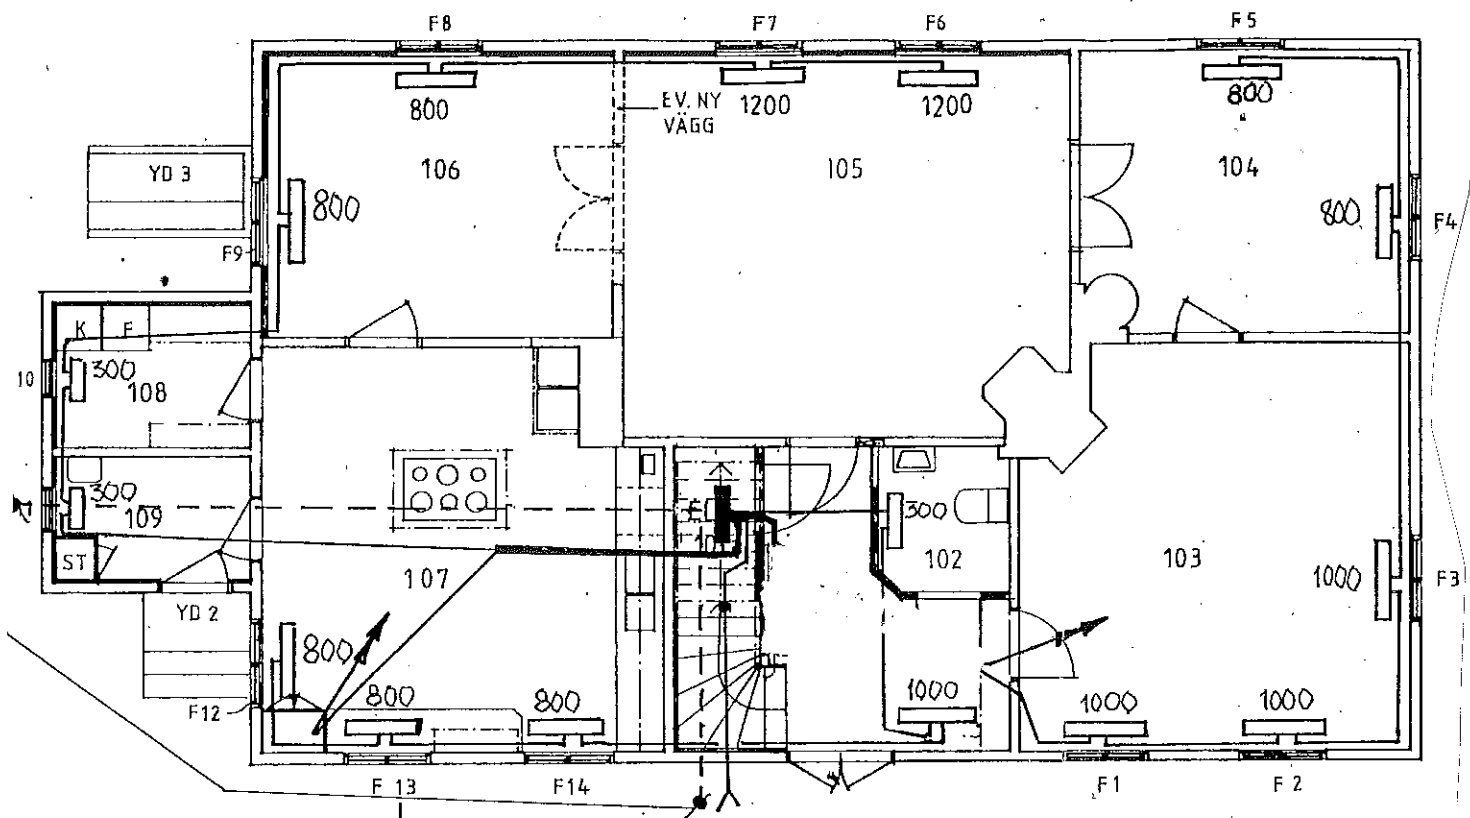

A ←
PLAN 1

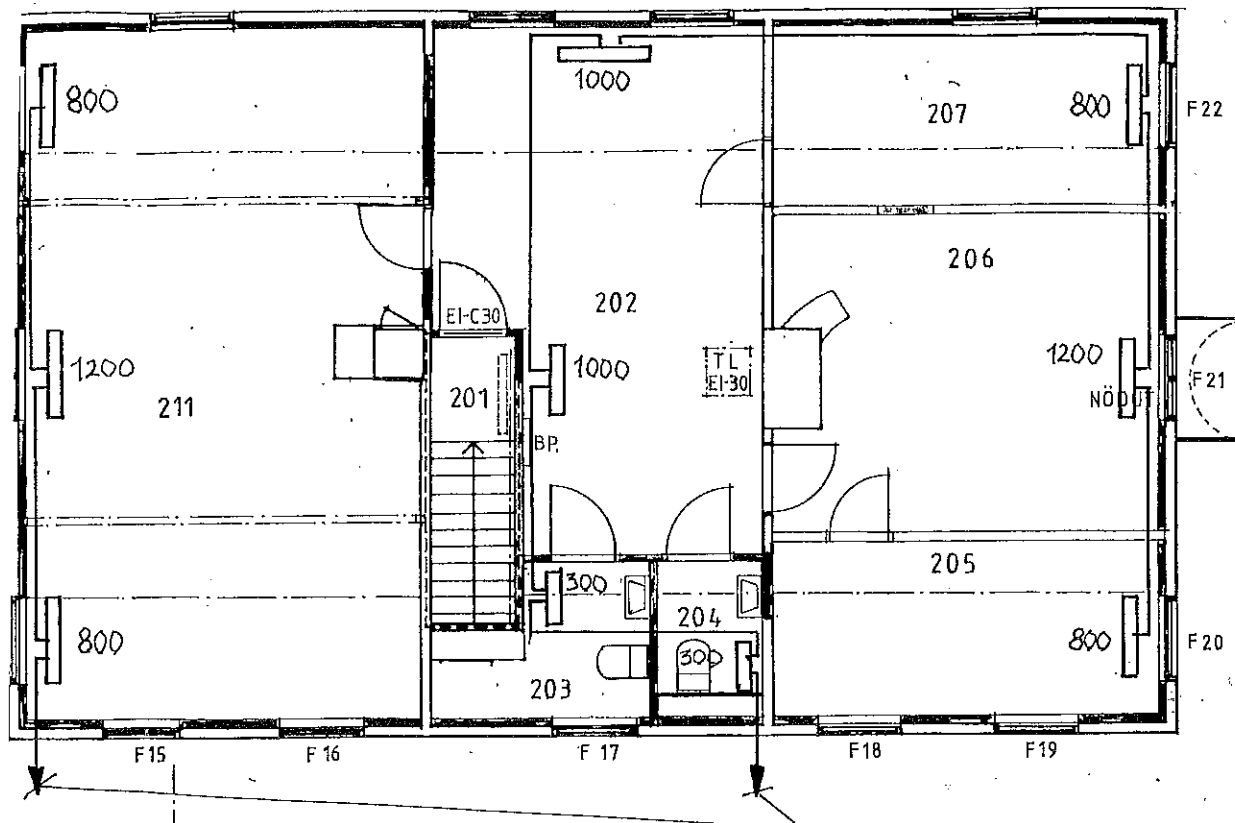

A ←
PLAN 2